
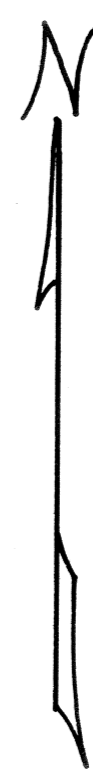


06073

CONTOUR MAP OF
HARD ROCK QUARRY
 FOR
STARKER FORESTS
 SW 1/4, SEC 19, T. 11S., R. 6 W., W. M.
 BENTON COUNTY, ORE.

SCALE: 1" = 100' CONTOUR INTERVAL = 10'
 3/10/76

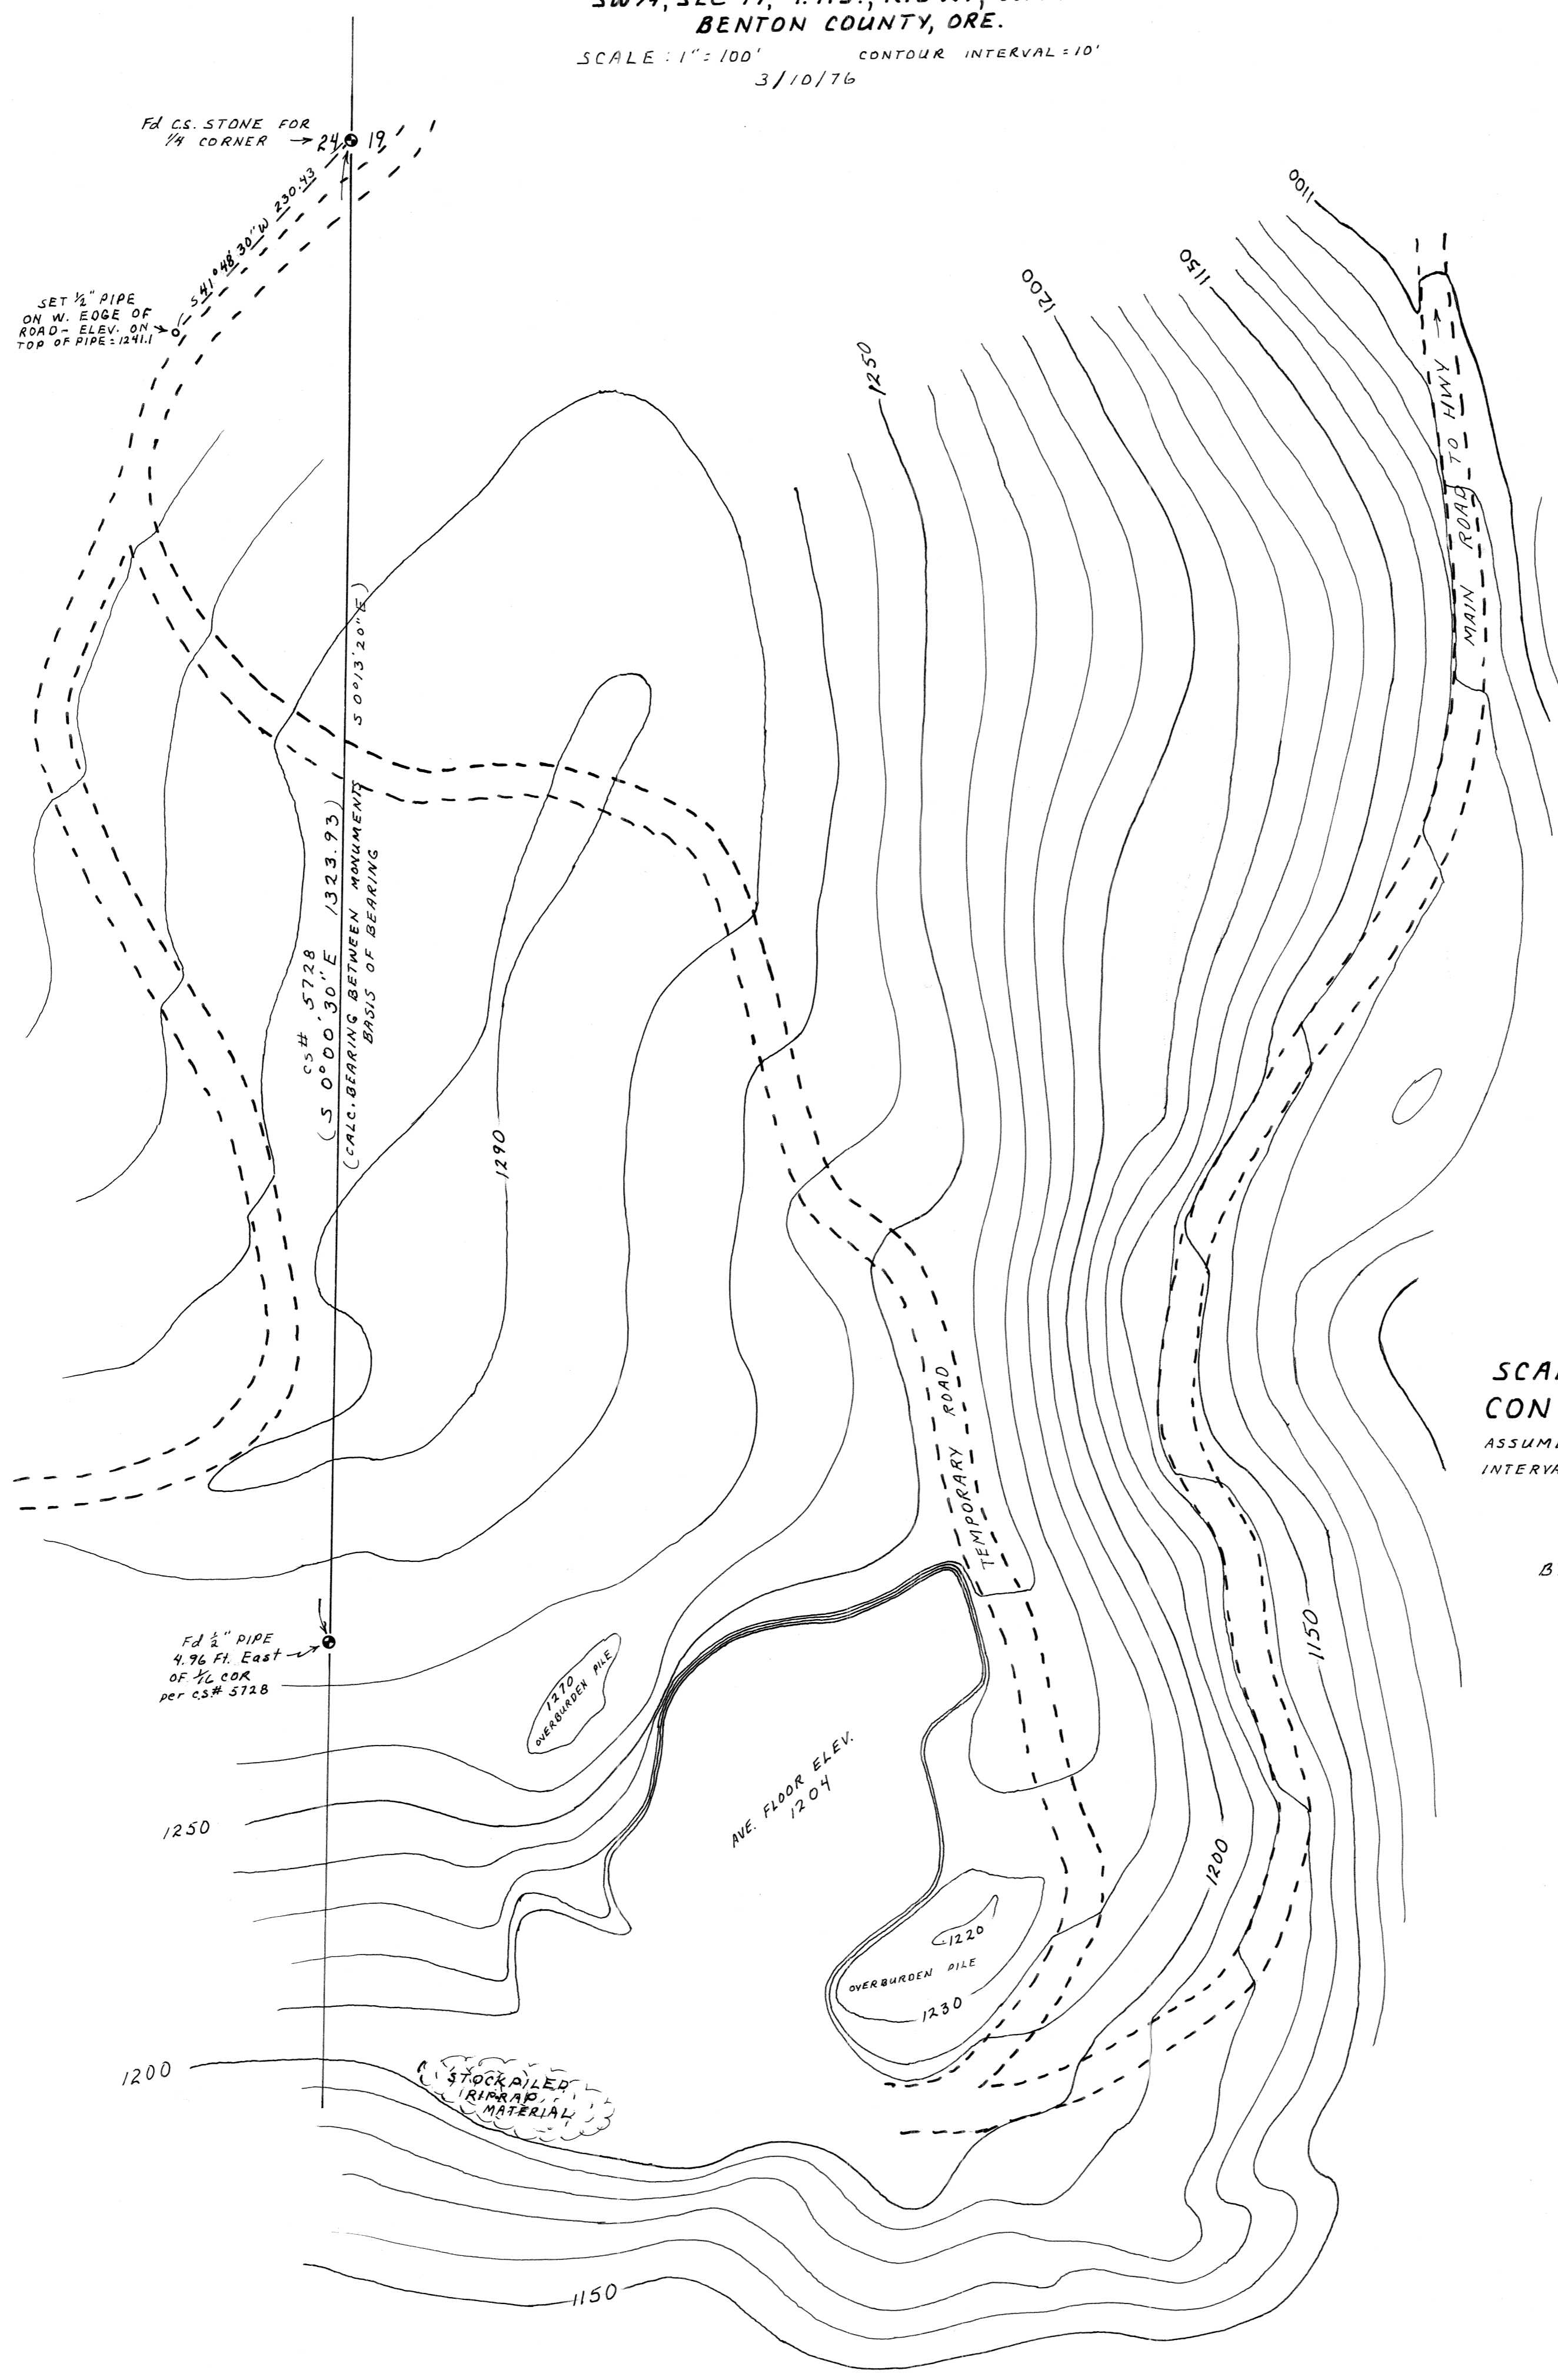

SCALE: 1" = 100'
 CONTOUR INTERVAL = 10'
 ASSUMED BEGINNING ELEVATION.
 INTERVALS SHOWN AS OF 3/3/76.

BERT W. UDELL RPE #2301
 BY ARNOLD BRUBAKER R.L.S. #992

REGISTERED
 PROFESSIONAL
 LAND SURVEYOR
Arnold Brubaker
 OREGON
 JULY 15, 1972
 ARNOLD BRUBAKER
 992

BERT W. UDELL
 LOGGING ENGINEERING & SURVEYING
 ROUTE 3, BOX 36
 LEBANON, OREGON 97356