


RECORD OF SURVEY  
 FOR BILL BROWN  
 Lot 13 RICHLAND ACRES  
 SE 1/4 NW 1/4 SEC. 11, T. 12S R. 5W W.M.  
 BENTON CO., ORE.

06145  
 Section 6145-A

SCALE 1"=20'  
 SEPT. 20, 1976

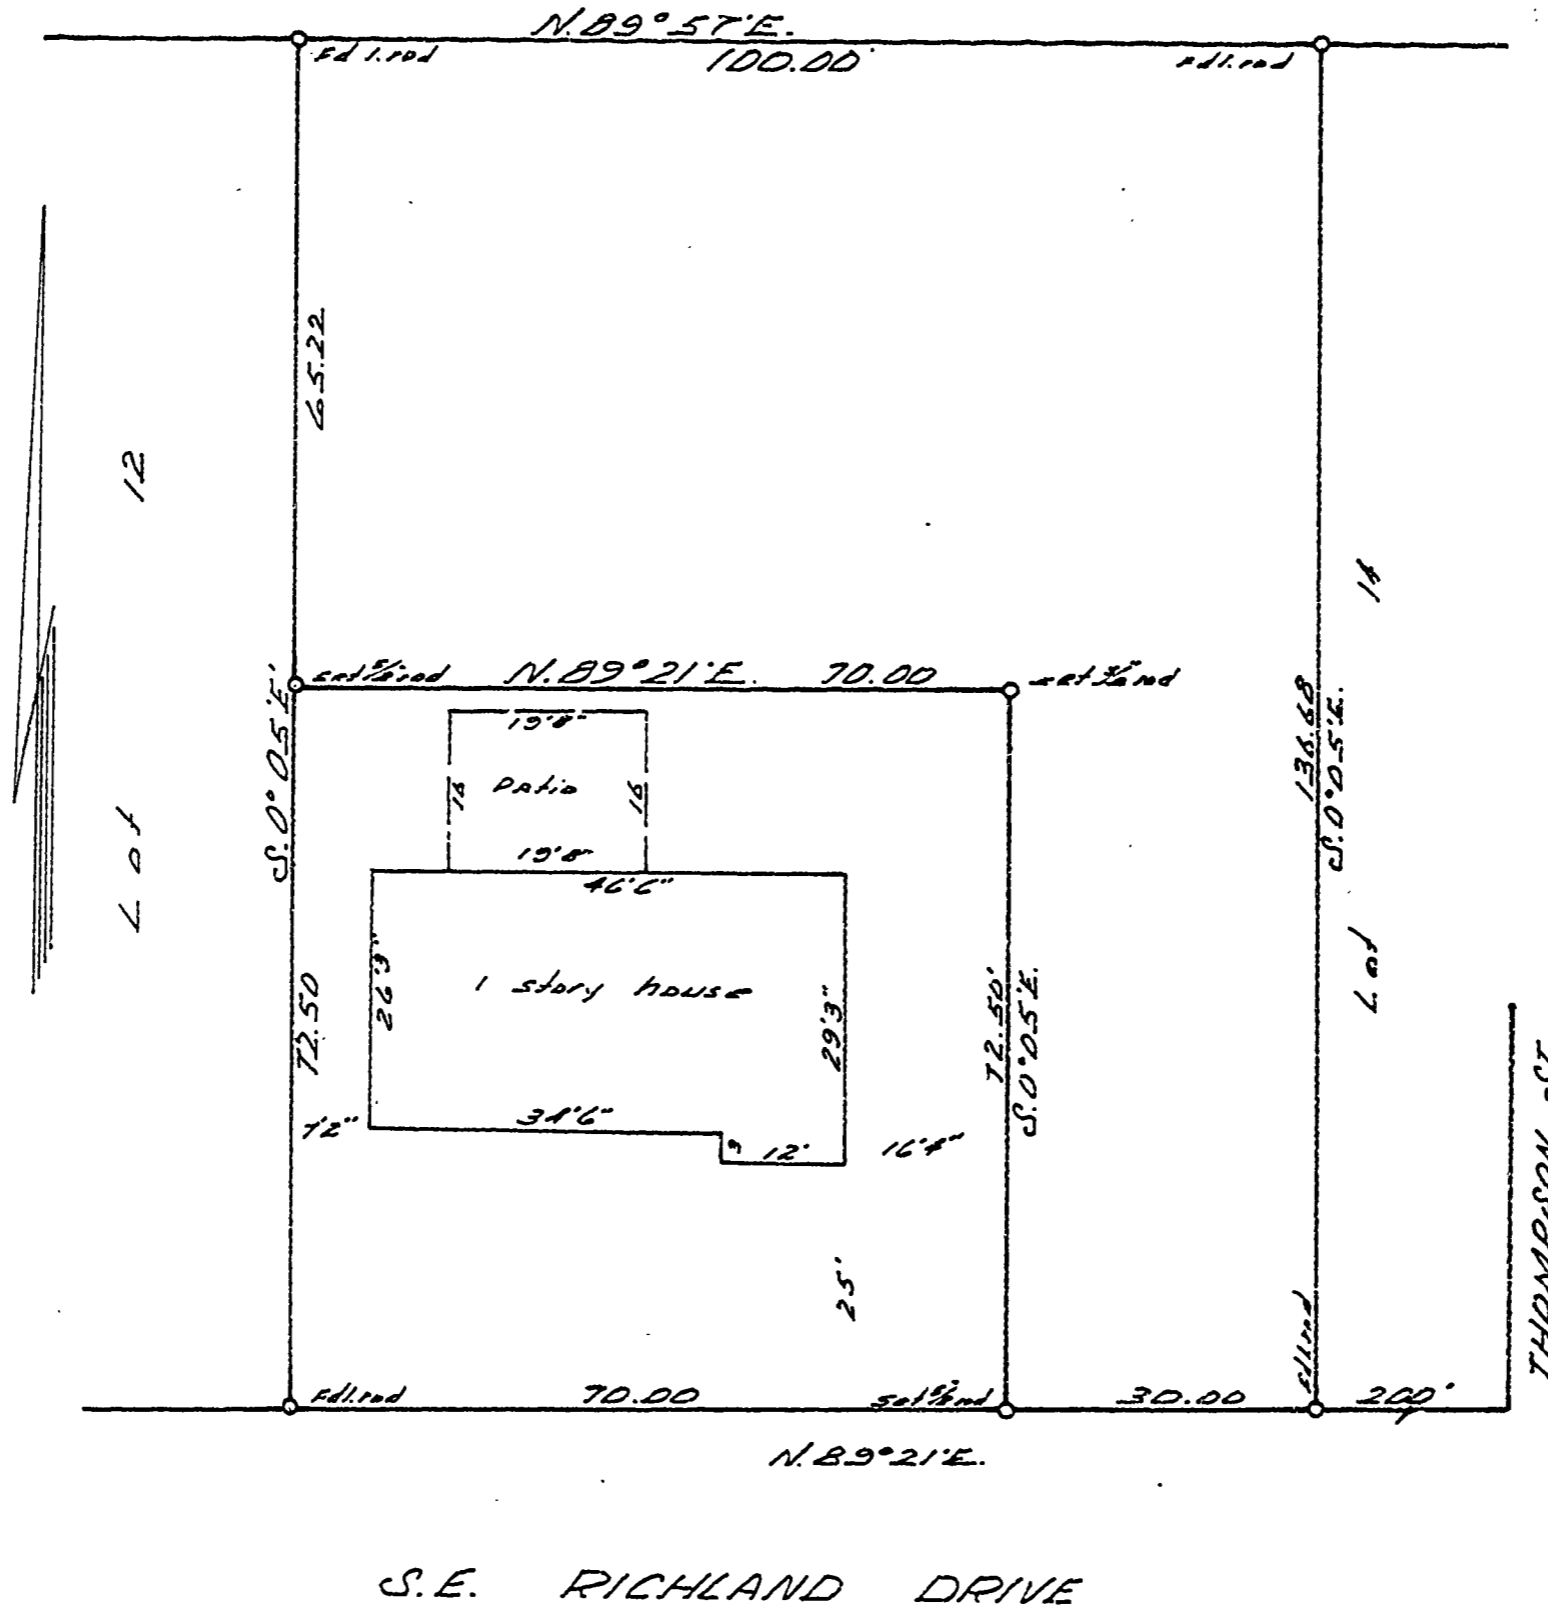

REGISTERED  
 PROFESSIONAL  
 LAND SURVEYOR

*Richard W. Fail*


OREGON  
 NOVEMBER 4, 1908  
 RICHARD W. FAIL  
 357

RECORD OF SURVEY  
 FOR BILL BROWN  
 Lot 13 RICHLAND ACRES  
 SE 1/4 NW 1/4 SEC. 11, T. 12S R. 5W W.M.  
 BENTON CO., ORE.

APPROVALS  
*[Signature]*  
 City Engineer  
 Acting *[Signature]*  
 Planning Director

SCALE 1"=20'  
 SEPT. 20, 1976

FINAL APPROVAL

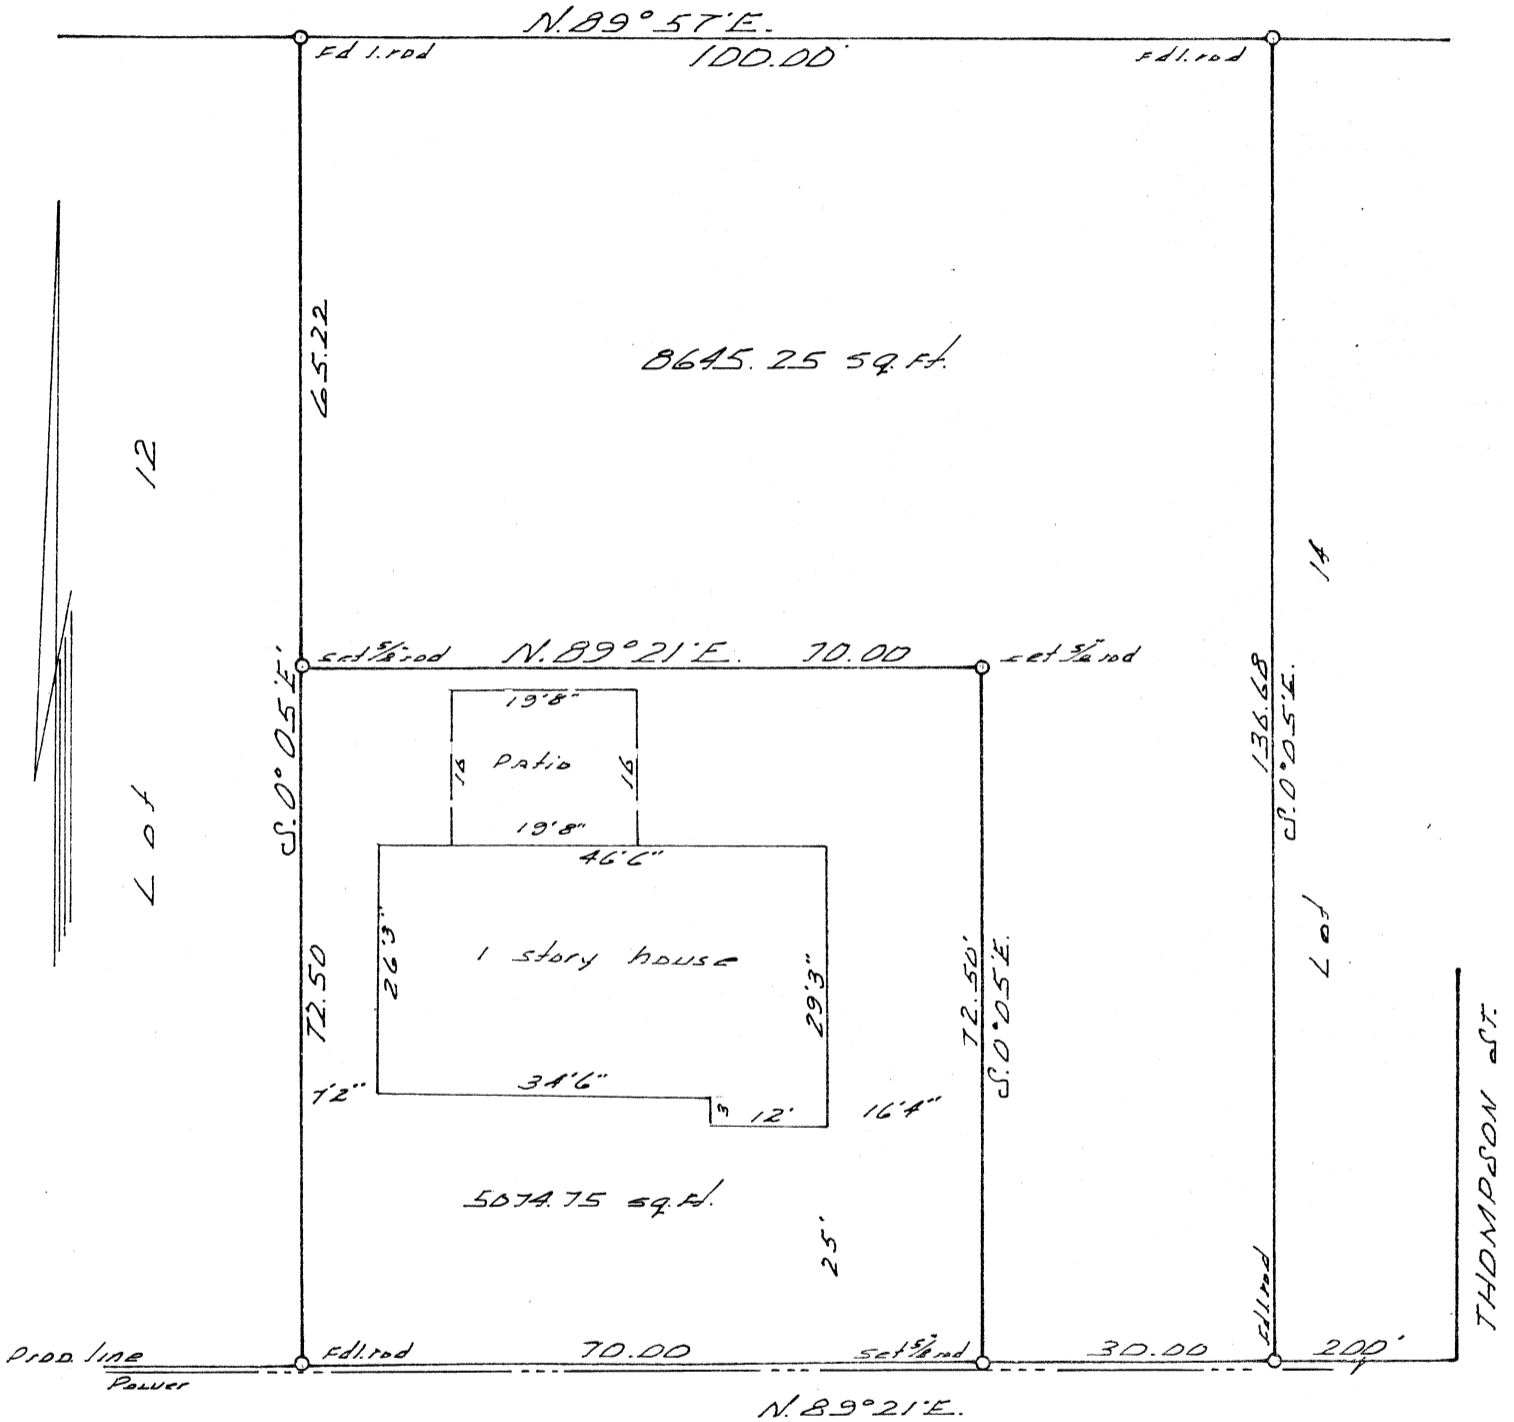

water  
 Edge DATE  
 S.E. RICHLAND DRIVE  
 sewer  
 Edge DATE  
 Phone  
 Prop. line

REGISTERED  
 PROFESSIONAL  
 LAND SURVEYOR

*[Signature]*  
 OREGON  
 NOVEMBER 4, 1954  
 RICHARD W. FAIL  
 357