


86154

Retracement Survey for
HULL-OAKES LUMBER CO.
in Sec. 22, T.14S., R.7W.

AUG. 1976

Scale: 1" = 1000'

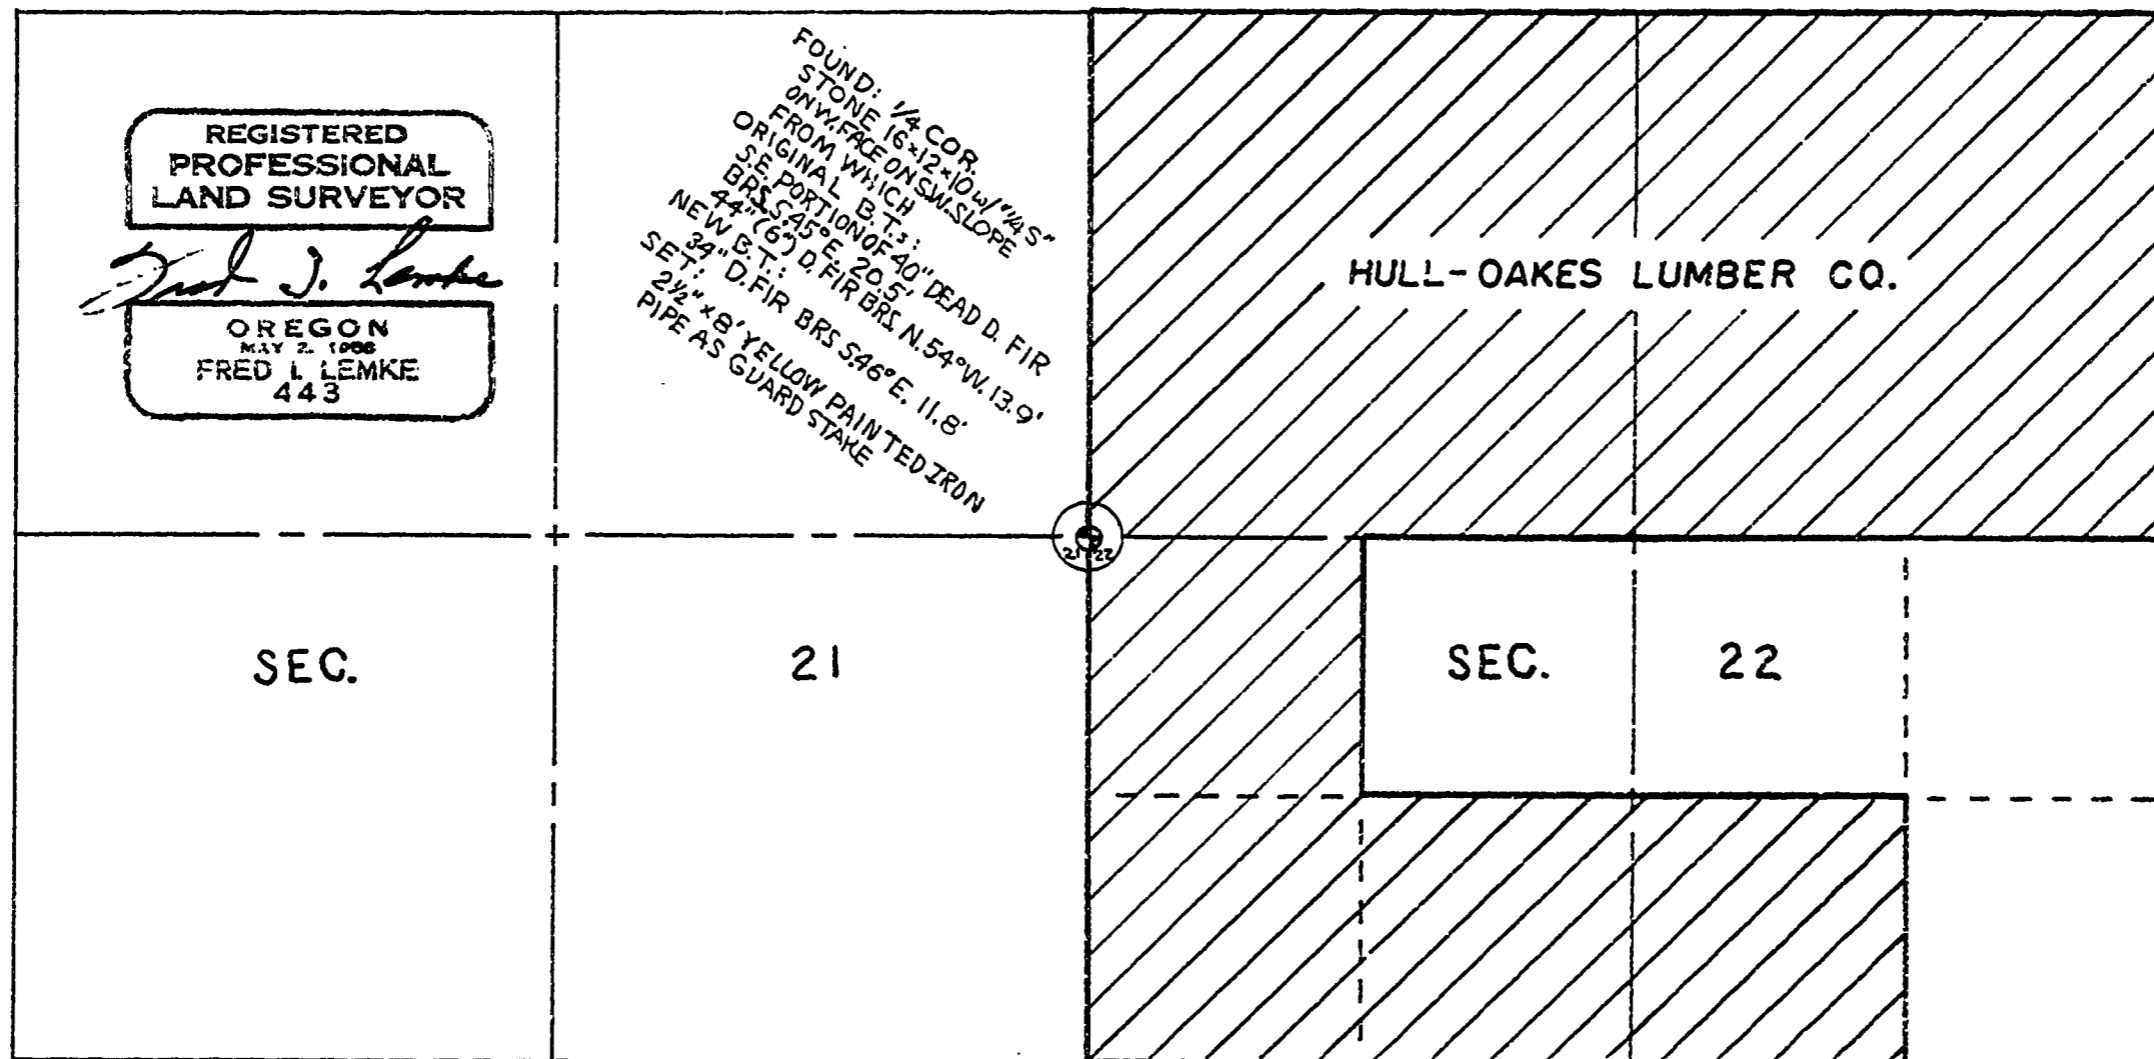

STAFF COMPASS DECLINATION CORRECTION:
MAG. N. ASSUMED TO BE 21° E.