


6157

6157



SURVEY 6157
 IN
 SECTION 30 T13SR8WWM
 BENTON COUNTY, OREGON
 FOR
 WILLAMETTE INDUSTRIES INC.
 SCALE 1" = 400'
 BEARINGS FROM SURVEY
 DATED 1/74 - 3/74 FOR W.I.I.

- 1 SE 1/16 5/8" X 30" I.R.
 10" HEM. N14°E 23.7 FT.
 MKD. SE 1/16 S30 BT, W.I.I. Y. TAG
 24" HEM. S86°E 9.5 FT
 MKD. SE 1/16 S30 BT W.I.I. Y. TAG
- 2 E 1/16 5/8" X 30" I.R.
 16" MAPLE S42°E 26.9 FT
 MKD. E 1/16 S31 BT W.I.I. Y. TAG
 18" DE N14°E 15.6 FT W.I.I. Y. TAG
 MKD. E 1/16 S 30 BT W.I.I. Y. TAG

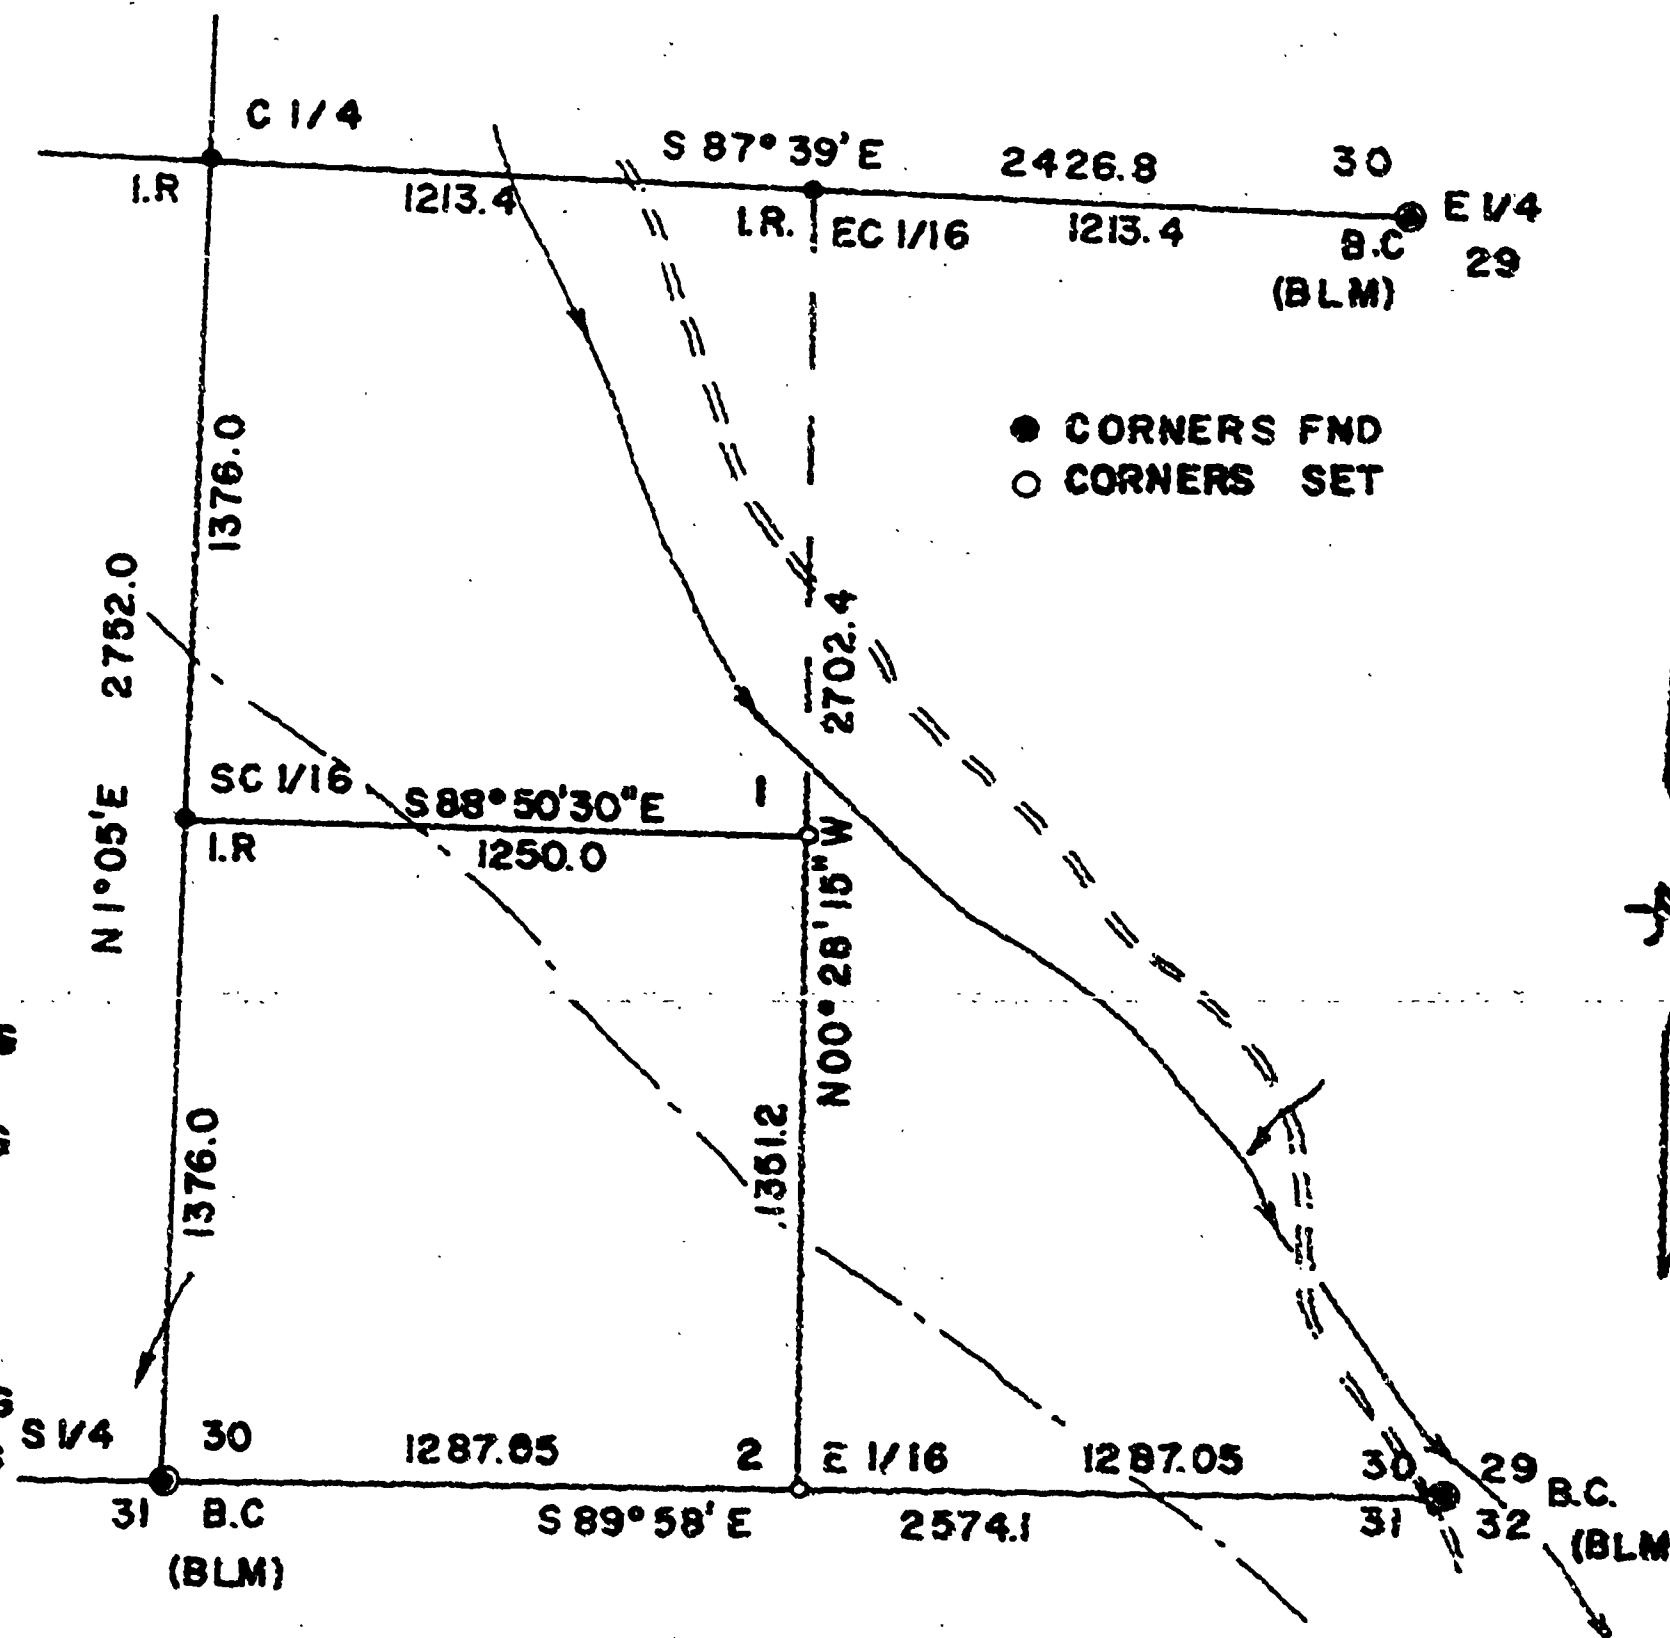

06157