

6190

6190

6190

66190


SYMONDS SURVEY

NW 1/4 SE 1/4 SEC. 1
T. 11 S. R. 4 W. W.M.

BENTON COUNTY, OREGON

Scale: 1" = 60'

October 25, 1976

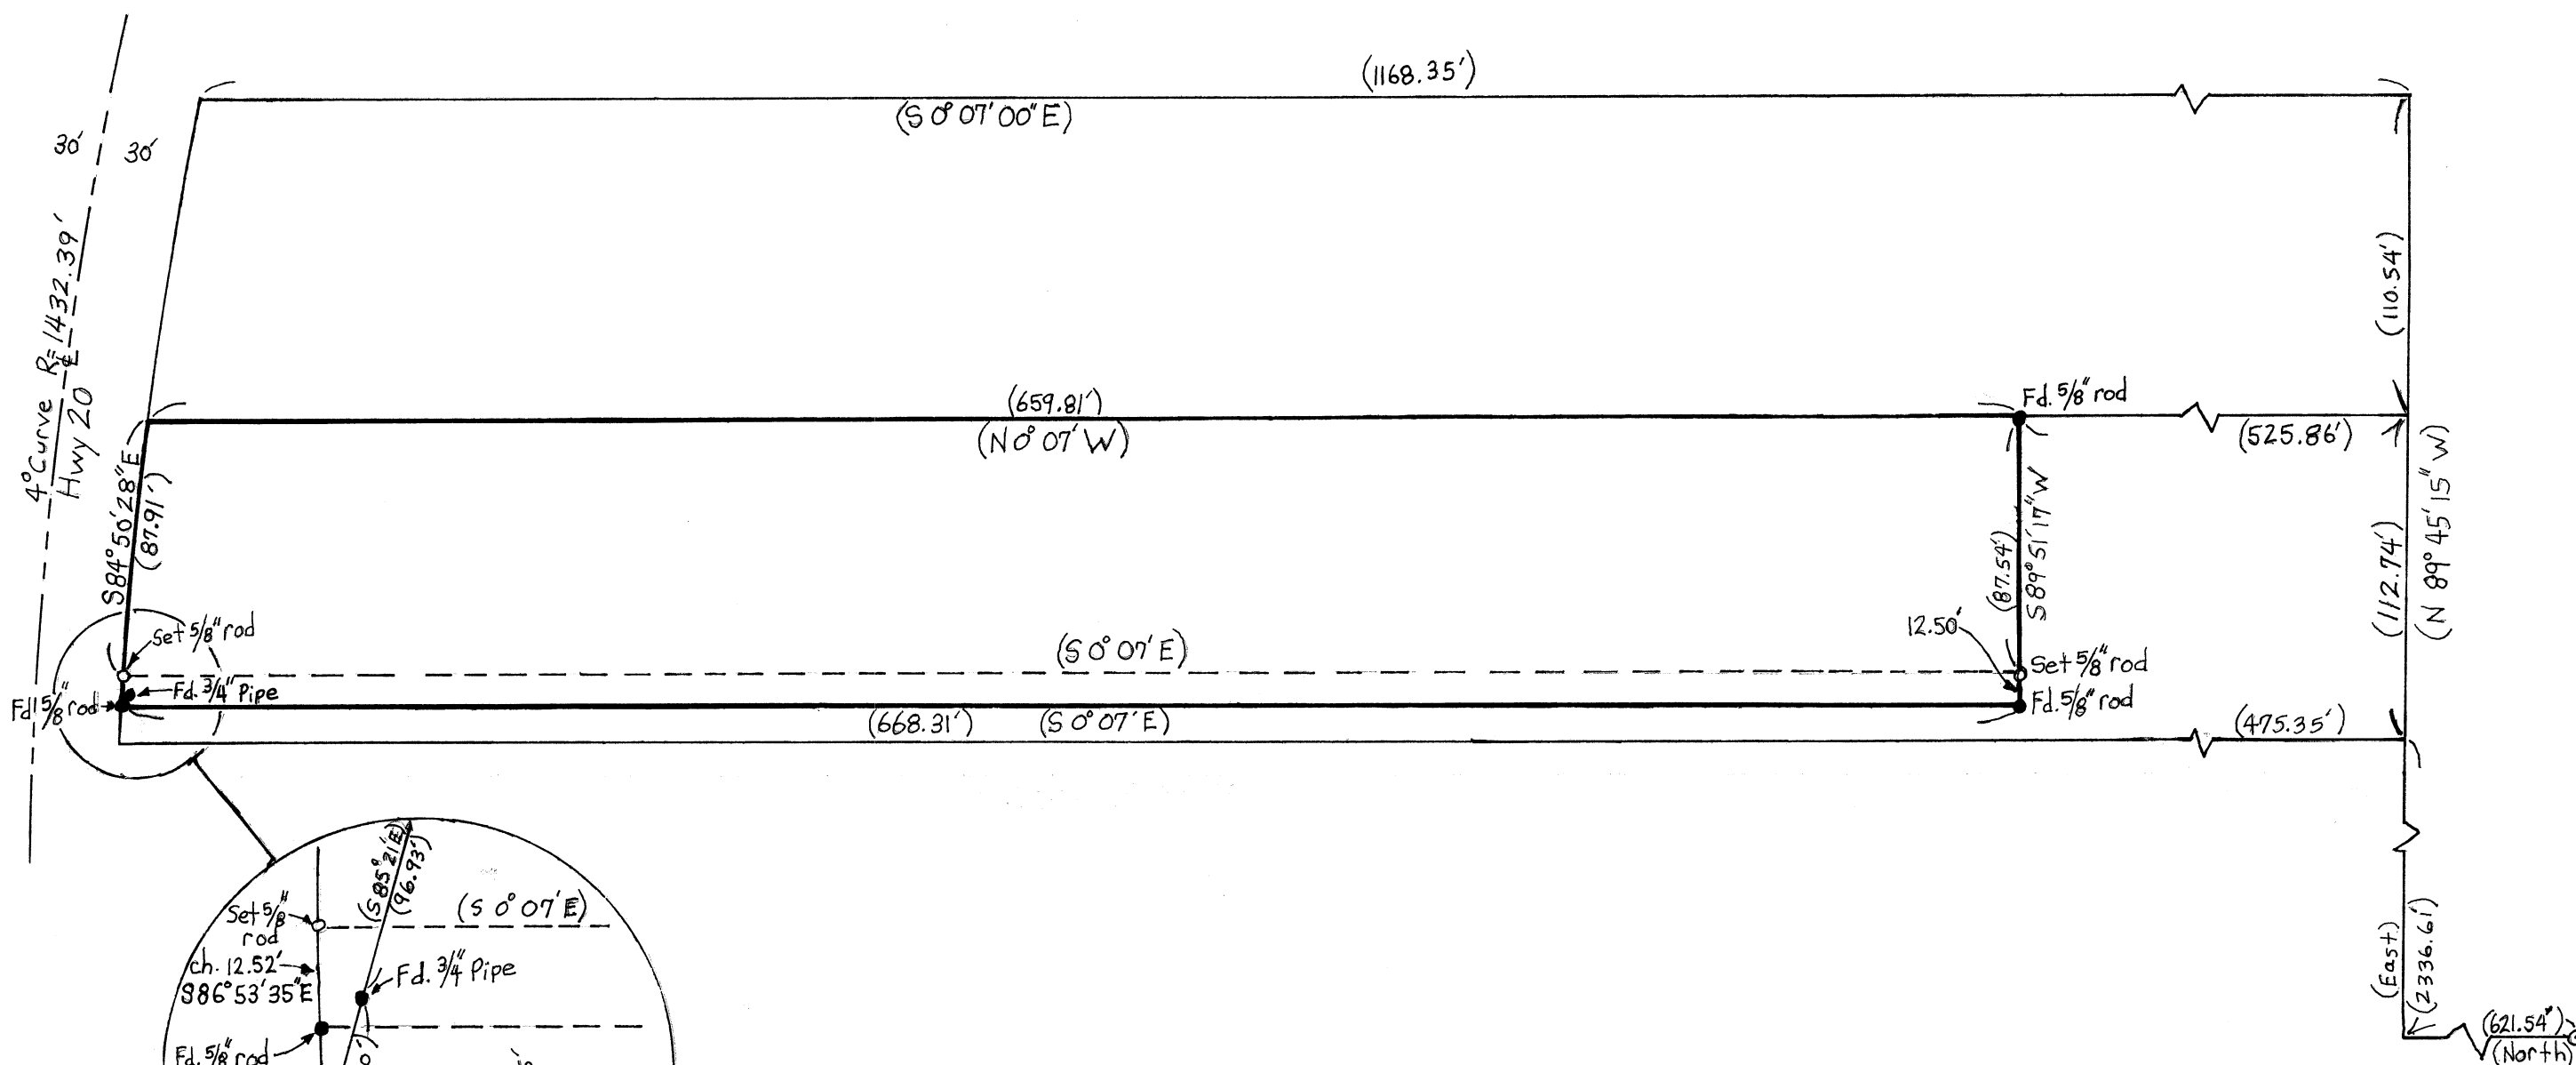

Bearings based on C.S. 3557

6190

