


SURVEY FOR T.R. GREGG
 PART OF LOT 7, PLEASANT VIEW FRUIT FARMS
 IN THE GEORGE W. BETHERS D.L.C. NO. 49
 TOWNSHIP 12S RANGE 5W OF W.M.
 DECEMBER 22, 1976

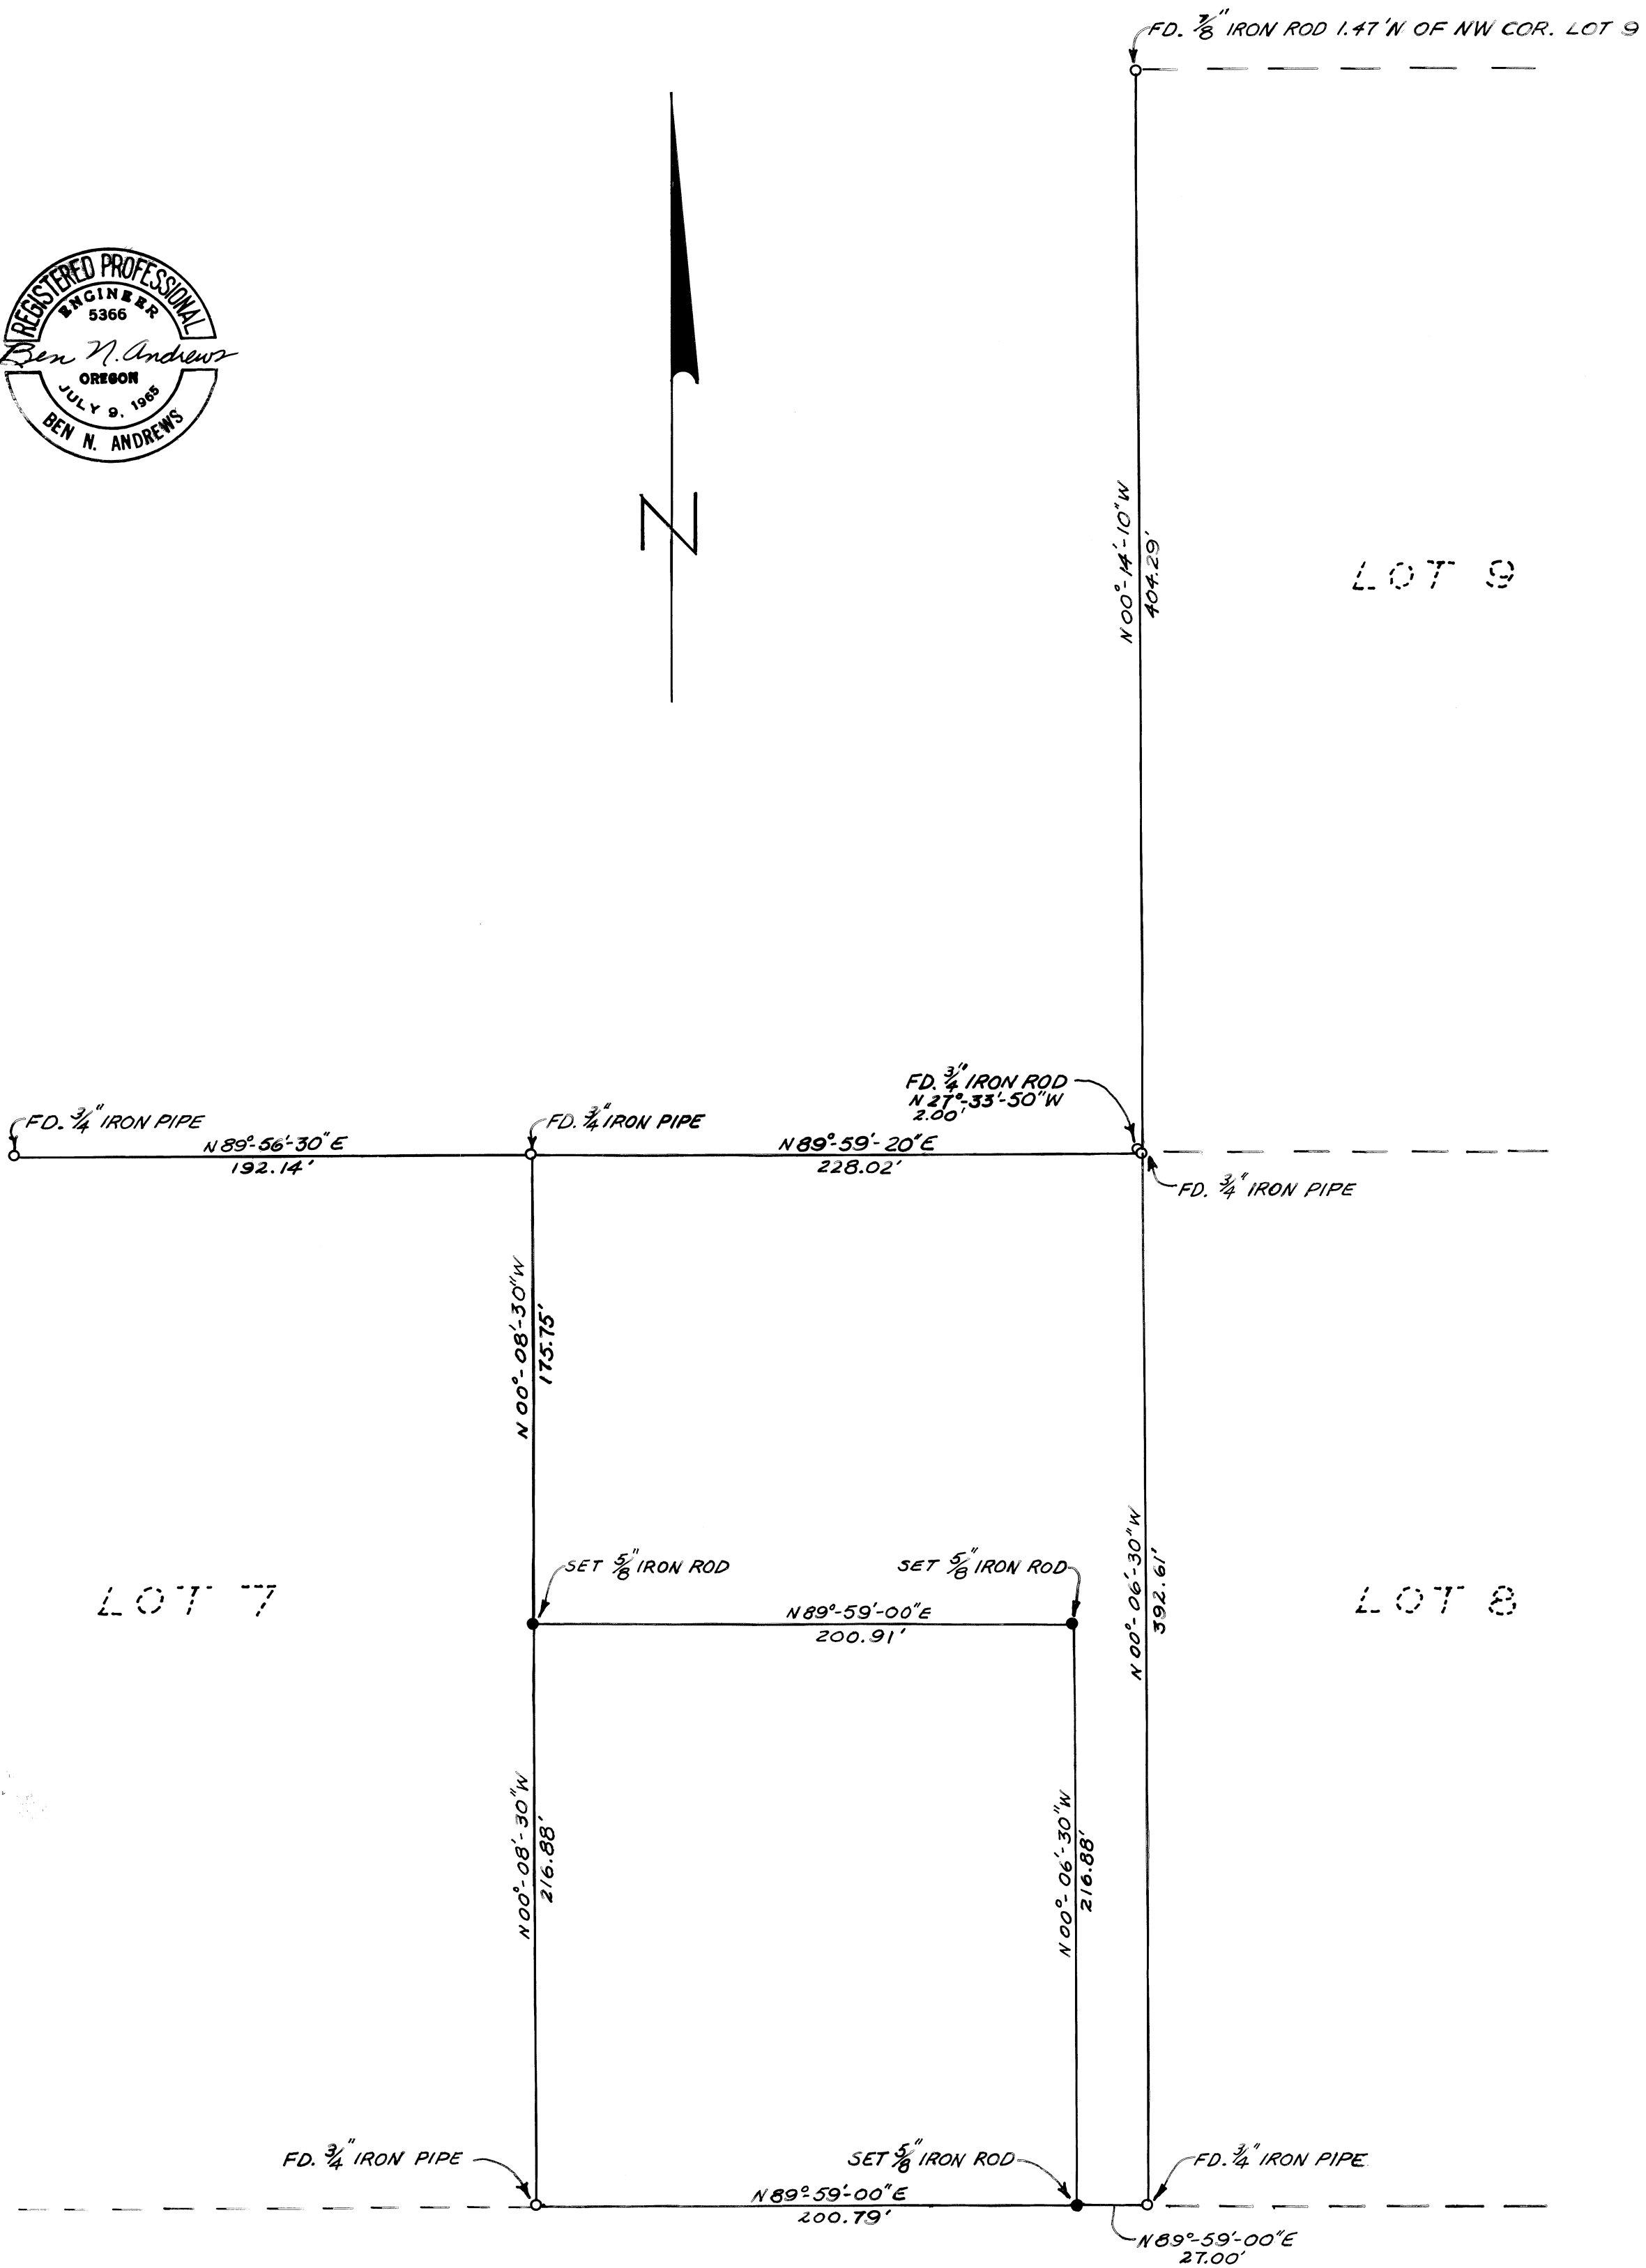

BASIS OF BEARINGS
 CS 4694
 SCALE: 1" = 50'