

PLAN OF SURVEY FOR

CLAUDE P. TROYCIAIR


LOT 10 AND A PORTION OF LOT 12, BLOCK 2

FAIRHAVEN HEIGHTS NO. 2

CORVALLIS, OREGON

SCALE 1" = 50'

FEBRUARY 24, 1977

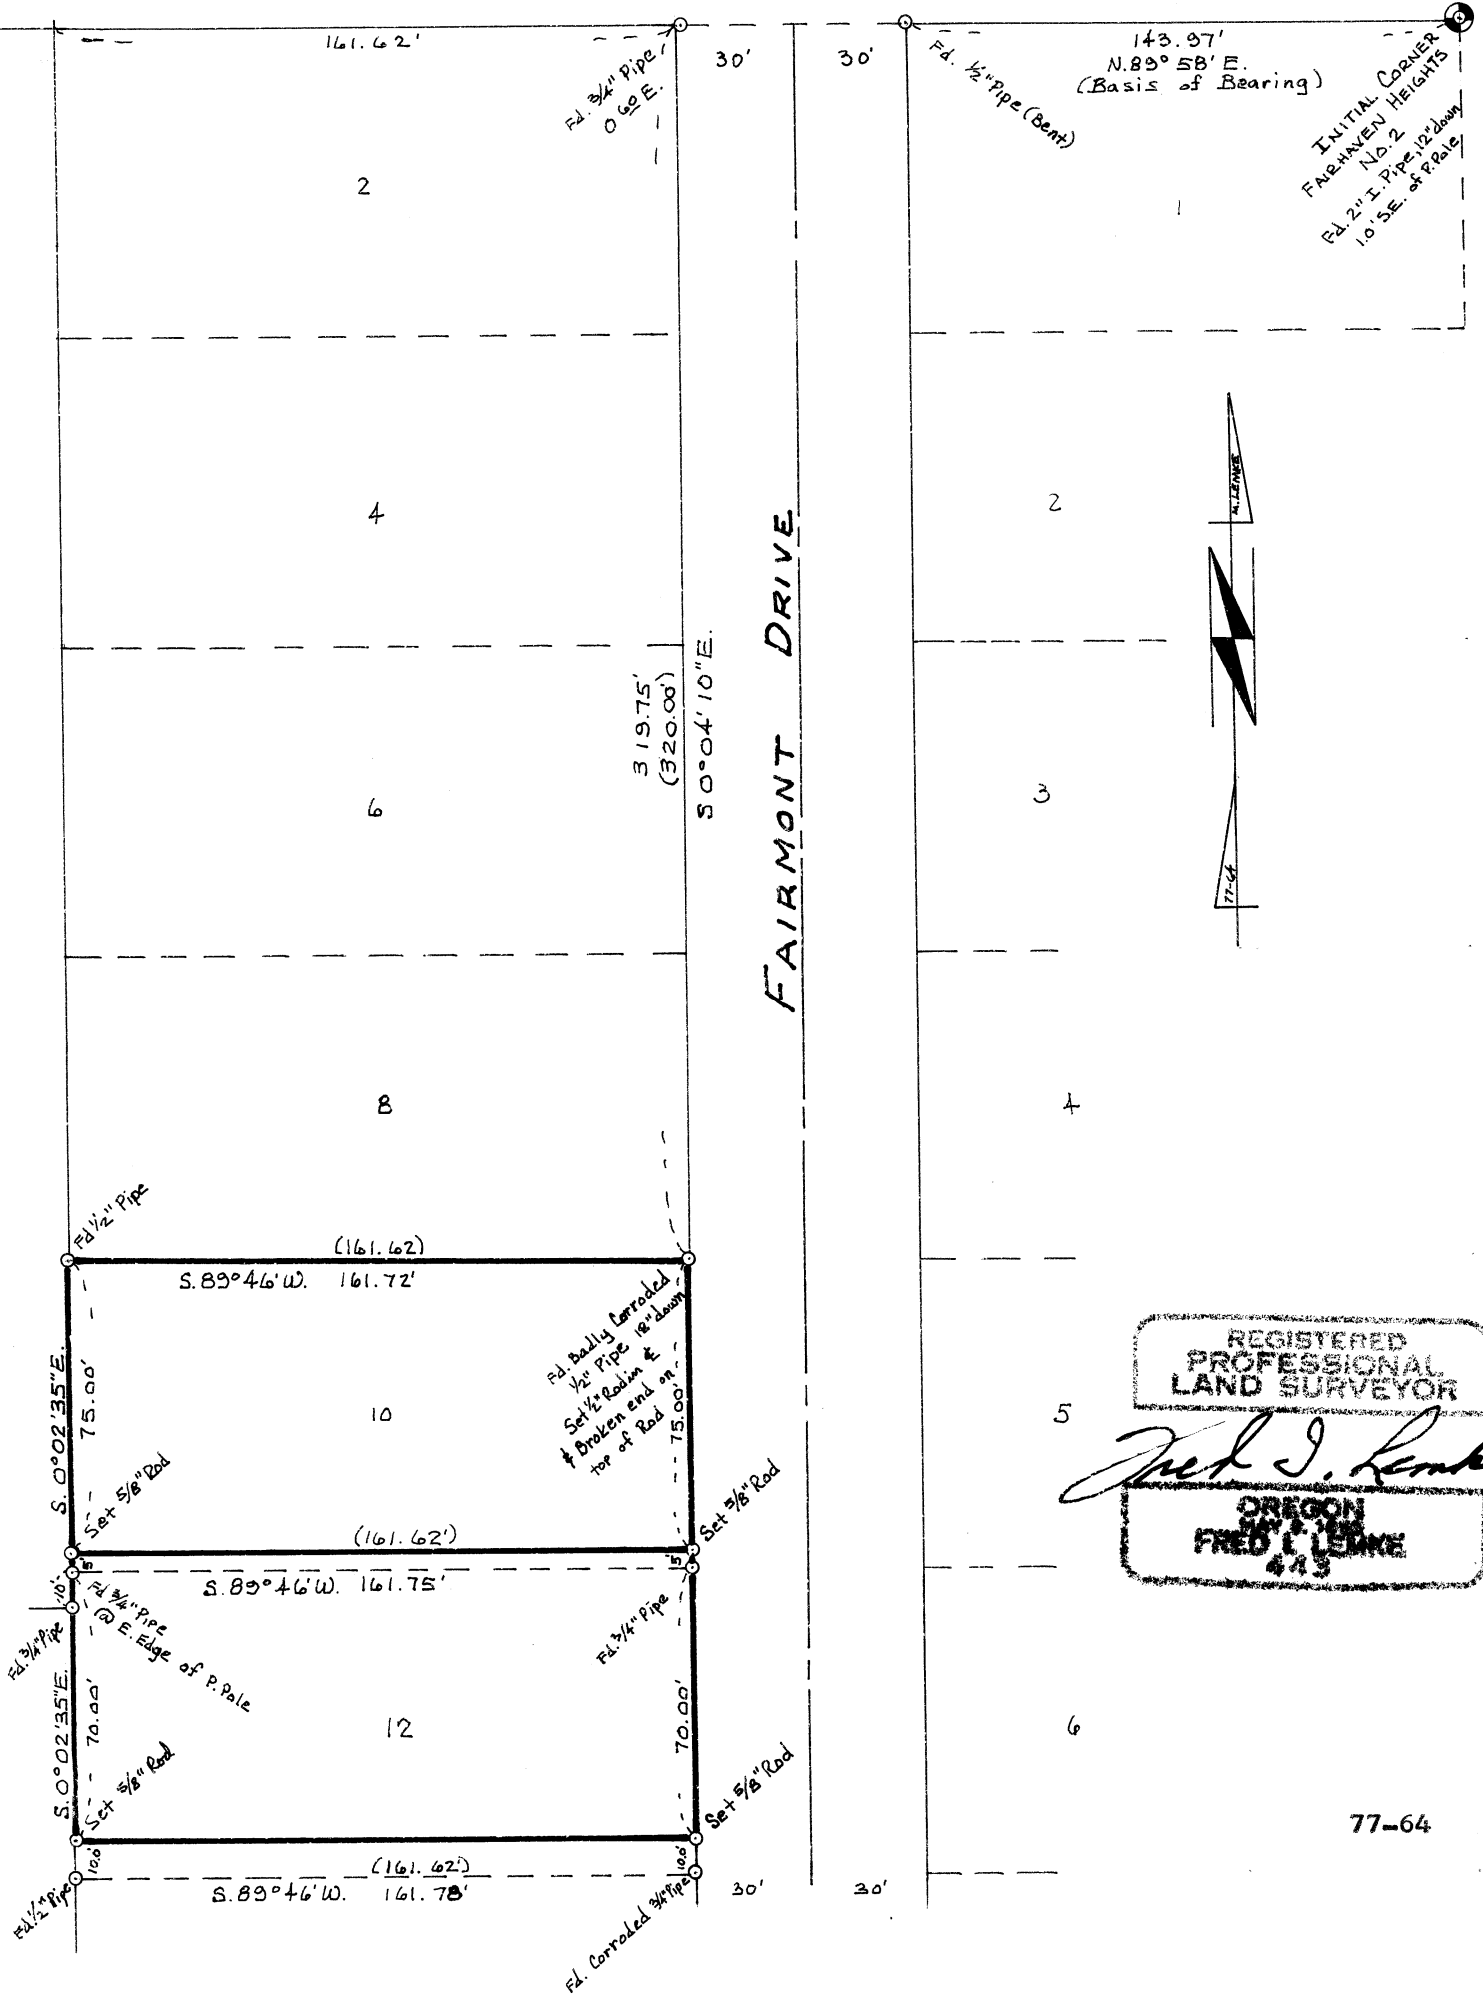

REGISTERED PROFESSIONAL LAND SURVEYOR

*Fred J. Lemke*

OREGON FRED J. LEMKE 443