


Benton Co. Surveyors Office
 C. S. FILE NO. _____
 FILING DATE _____
 FILE SIZE _____

RECORD OF SURVEY
 FOR
 MEL STEWART
 PART OF TRACT 2
 WILLAMETTEDALE FARMS
 SE 1/4 SEC. 24 - NE 1/4 SEC 25
 T.11S. R.5W. W.M.
 BENTON CO. ORE.

SCALE 1" = 200'
 MARCH 22, 1977

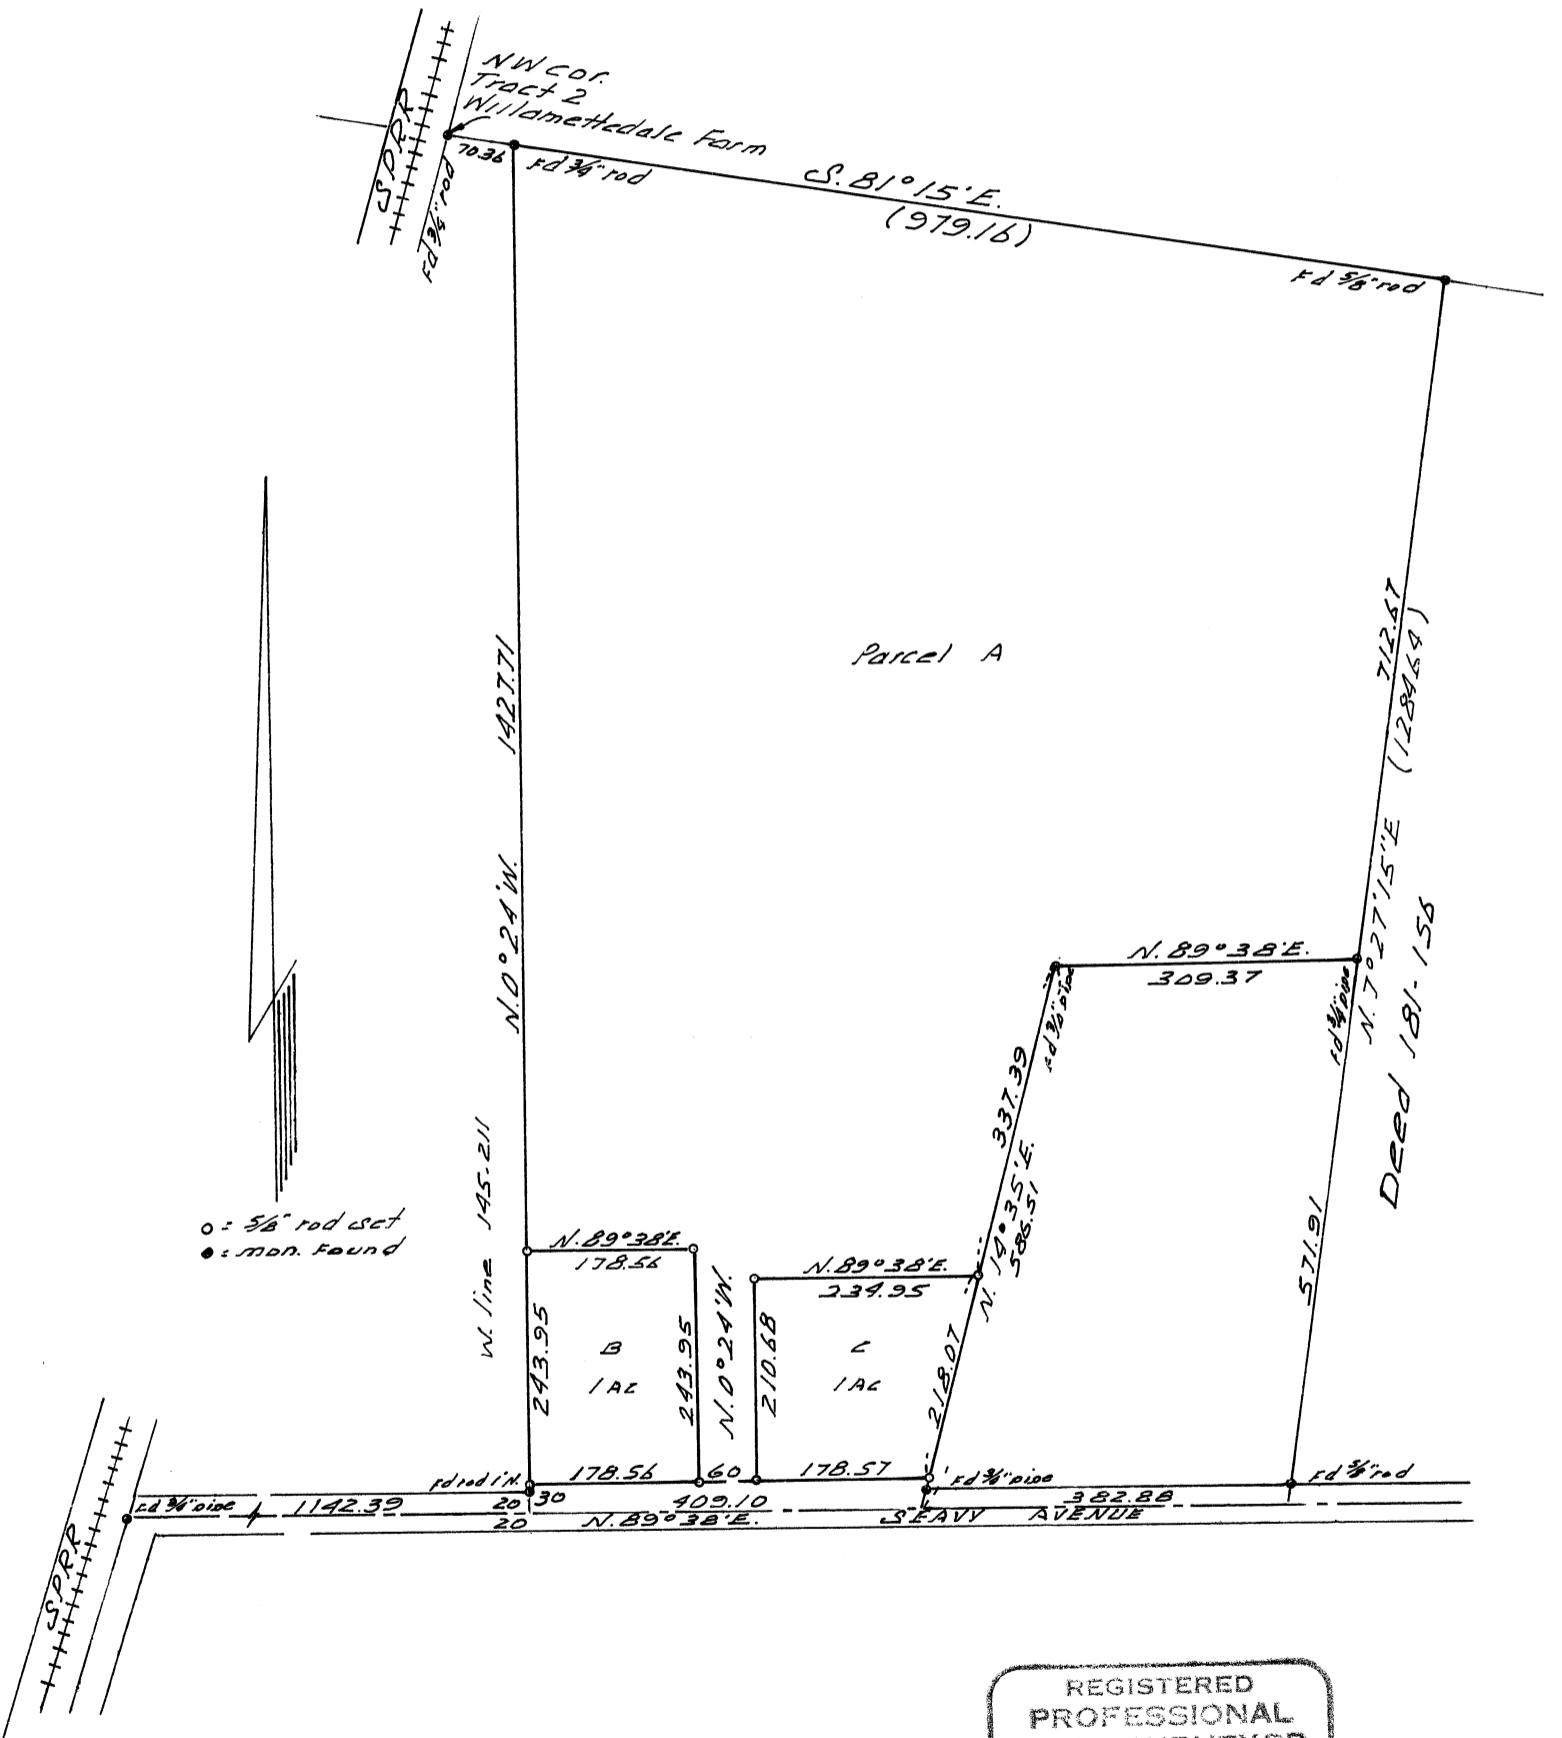

REGISTERED
 PROFESSIONAL
 LAND SURVEYOR

Richard W. Fail

OREGON
 NOVEMBER 4, 1955
 RICHARD W. FAIL
 357