


HWY 99 WEST

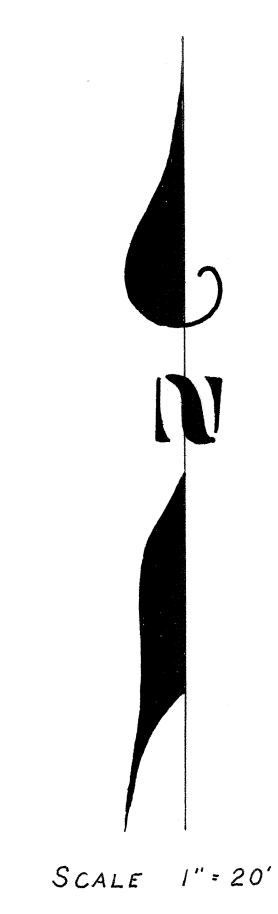

TUNISON STREET

ON THE WEST LINE OF STATE HIGHWAY 99 W
 21.927 CHAINS N 88° 25' E AND 17.193 CHAINS
 N 4° 06' E OF THE NORTHWEST CORNER OF THE
 DAVID BUTTERFIELD D.L.C. #47 IN T.12S, R.5W,
 W.M. IN BENTON COUNTY, OREGON

Region Co. Assessors Office
 C.S. FILE NO. 06321
 FILING DATE 4-5-77
 FILE SIZE 18"

LEGEND

- SET 5/8" IRON ROD
- FOUND MONUMENT AS NOTED
- EXTENDED LINES OF SURVEY
- NEW PARCEL LINES
- ORIGINAL PARCEL LINES
- REVISED PARCEL LINES
- I.R. IRON ROD
- I.P. IRON PIPE
- Fd. FOUND

NOTE:

BASIS OF BEARINGS FROM
 C.S. 2180
 REFER TO C.S. 6235 FOR
 LOCATION OF ADDITIONAL MONUMENTS
 REVISIONS
 MARCH 9, 1977 1. PARCEL B WEST & EAST LINE
 2. SEWER EASEMENT REDESCRIBED

MINOR LAND PARTITION

PREPARED FOR: THOMAS L. MOODY
 LOCATED 21.927 CHAINS N 88° 25' E AND 17.193 CHAINS
 N 04° 06' E OF THE NORTHWEST CORNER OF THE DAVID
 BUTTERFIELD D.L.C. #47 IN T.12S, R.5W, W.M. IN
 BENTON COUNTY, OREGON
 JANUARY, 1977
 McCULLOUGH, BRYANT & ASSOCIATES INC.
 CORVALLIS, OREGON

MINOR LAND PARTITION APPROVED
Richard J. House 4/4/77
 Planning Director Date
Robert Bost 4/4/77
 City Engineer Date

REGISTERED
 PROFESSIONAL
 LAND SURVEYOR
Tom O. McCullough
 OREGON
 1954 TO 1977
 TOM O. McCULLOUGH
 630

PROJECT 17-479