


638



BEARINGS FROM
C.S. 5168

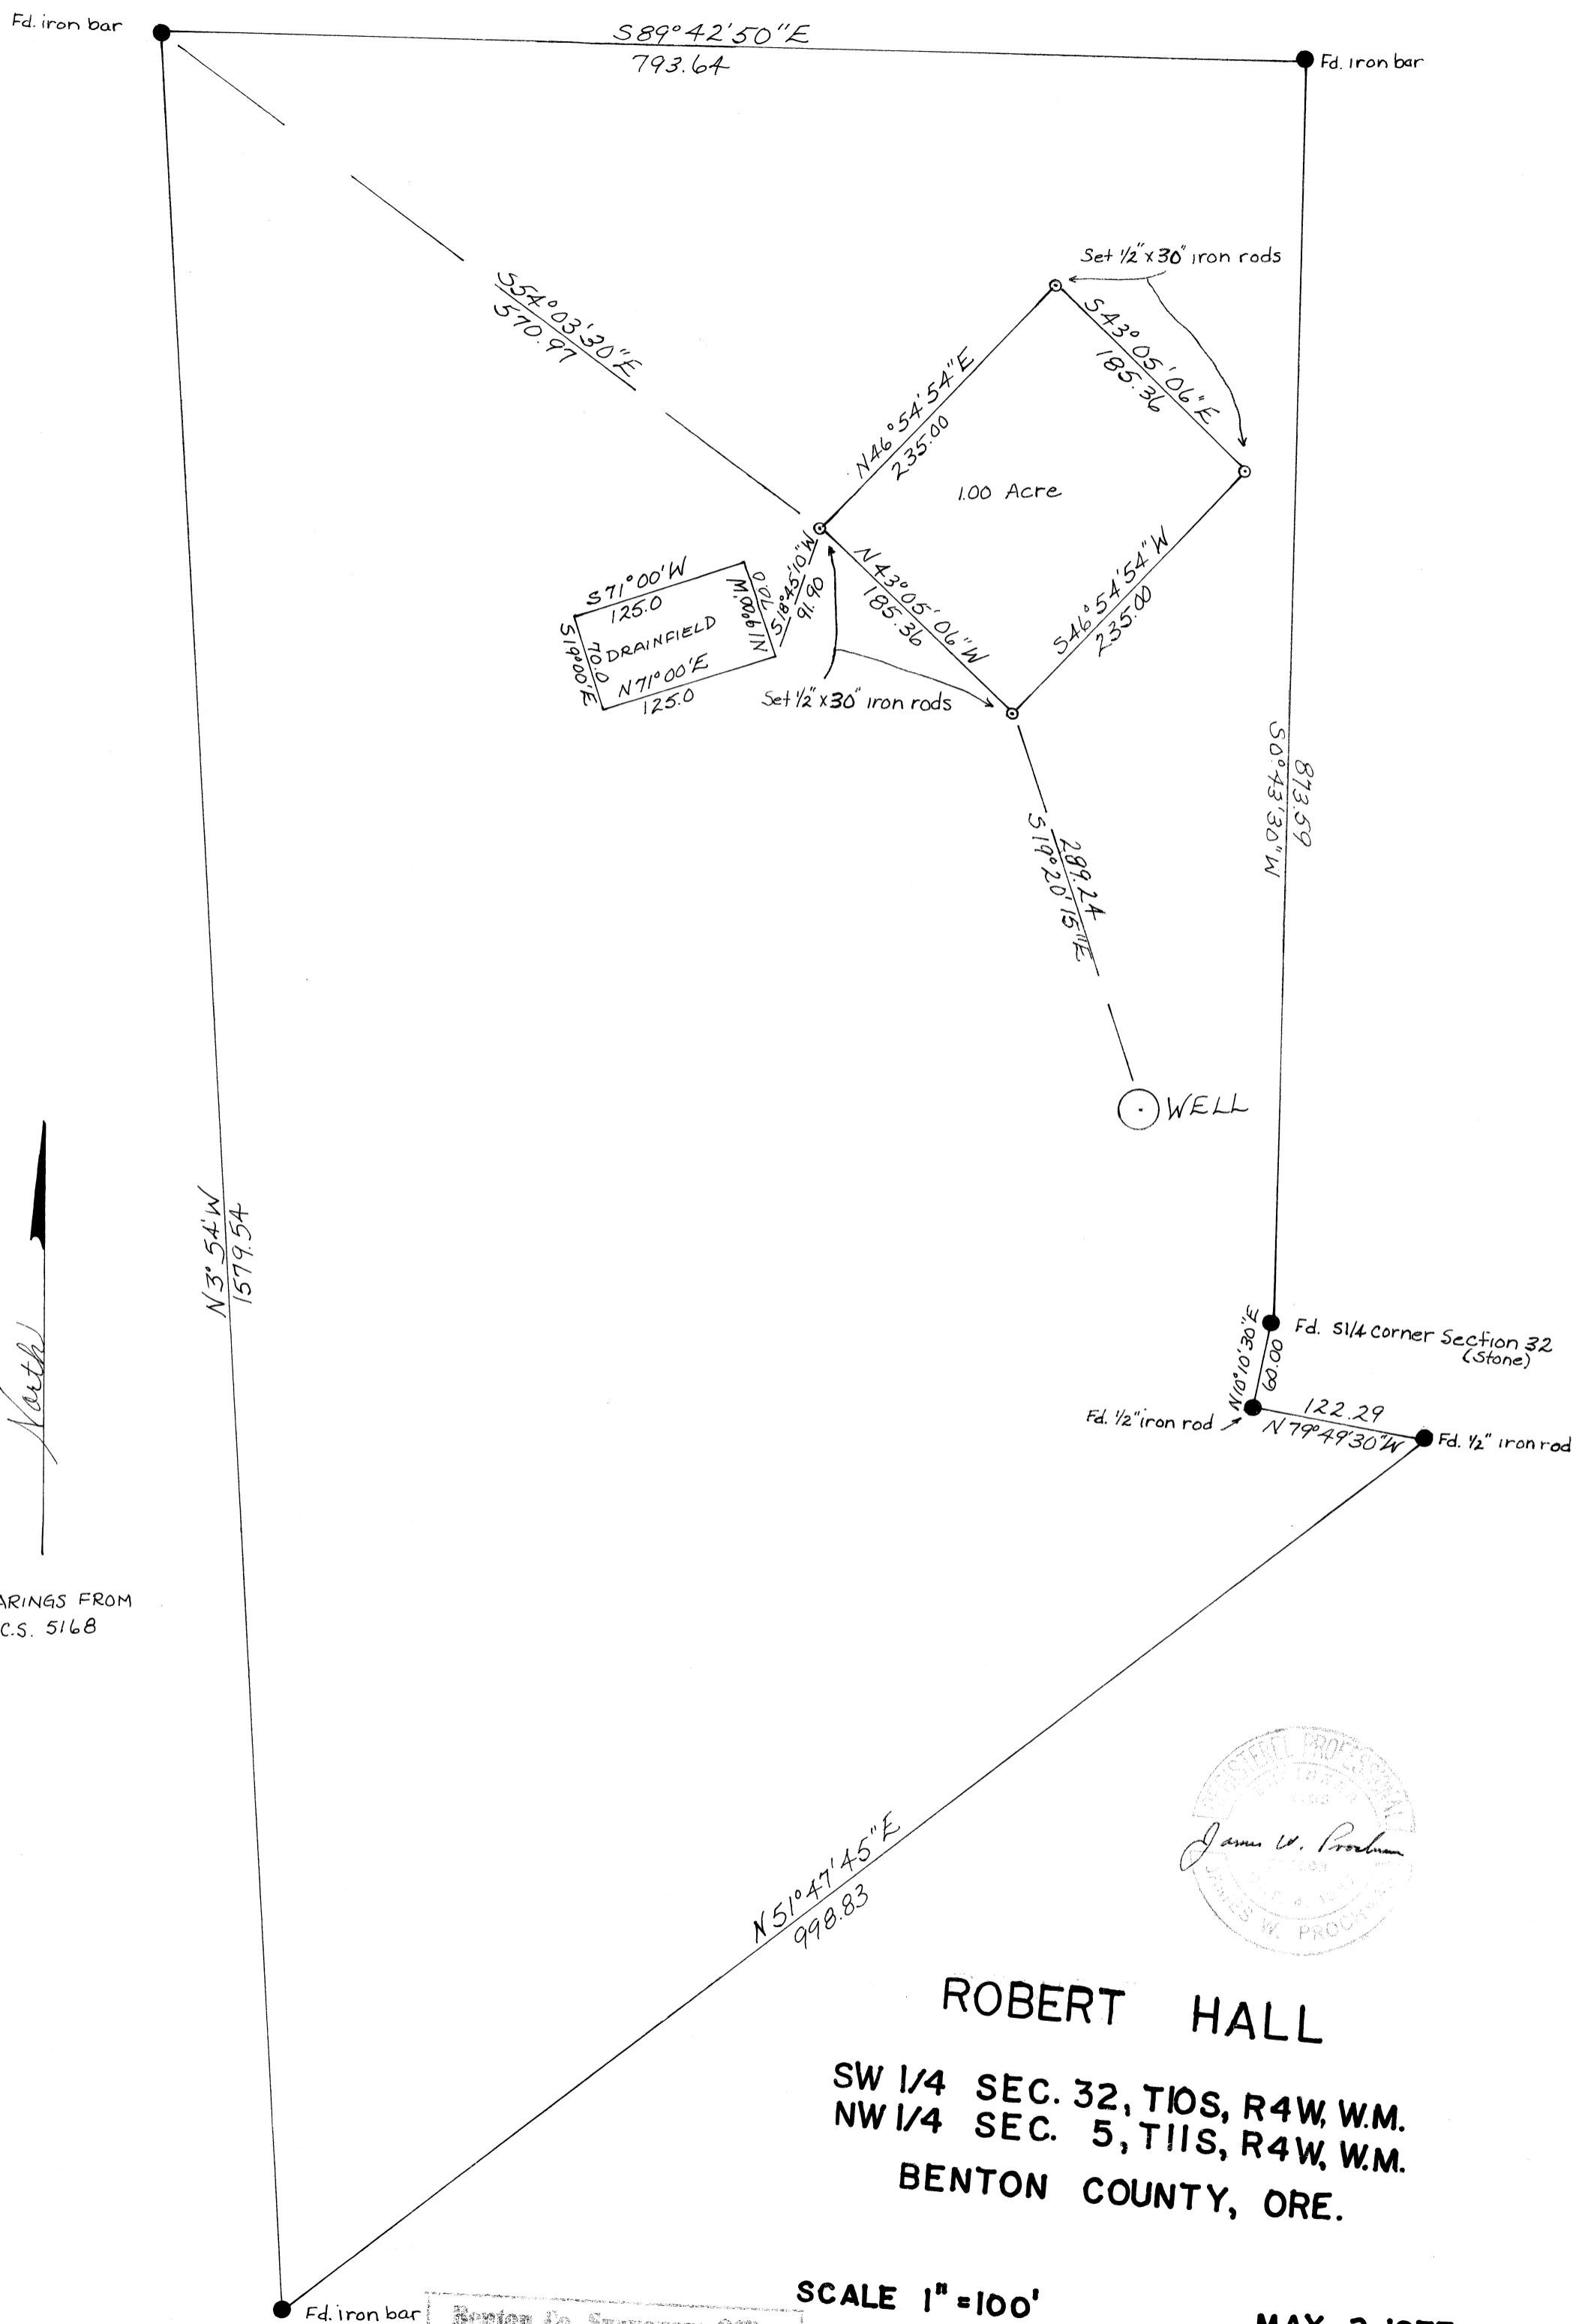

ROBERT HALL

SW 1/4 SEC. 32, T10S, R4W, W.M.
 NW 1/4 SEC. 5, T11S, R4W, W.M.
 BENTON COUNTY, ORE.

SCALE 1" = 100'

MAY 2, 1977

Benton Co. Surveyors Office
 C. S. FILE NO. _____
 FILING DATE _____
 FILE SIZE _____

638/