

CS 6414

Map of Survey For

CURTIS SUMMERS

Benton Co. Surveyors Office

C. S. FILE NO. 00314

FILING DATE 8-17-77

FILE SIZE 8 1/2 x 14

N.E. 1/4 Sec. 4, T. 13 S., R. 6 W. of W.M.

BENTON COUNTY, OREGON

Scale: 1" = 100' Job No: 77-198


Drawn by: V.M.V.

Date: July 6, 1977



● Denotes 5/8" Rod Found

○ Denotes 5/8" Rod Set

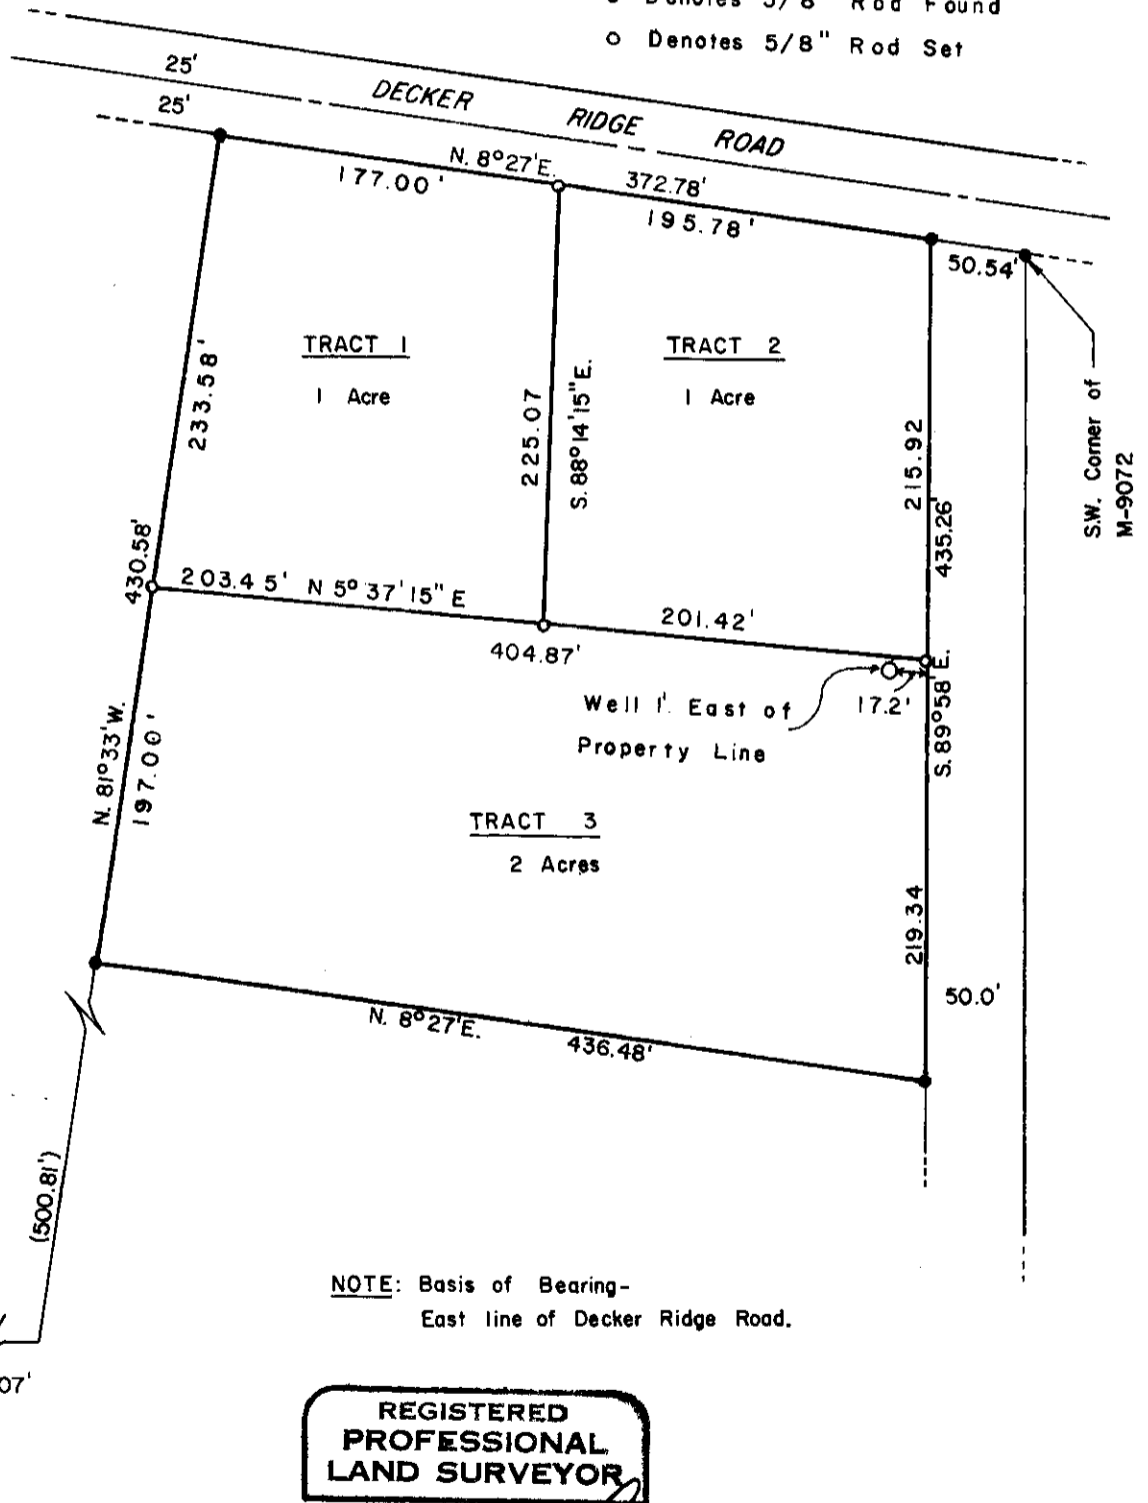

S.W. Corner HILKIAH BANKS D.L.C. No. 48 1-1/4" Shaft

S.W. Corner of M-9072

REGISTERED PROFESSIONAL LAND SURVEYOR

*Fred I. Lemke*

OREGON MAY 2, 1998 FRED I. LEMKE 443