


Benton Co. Surveyors Office
 C. S. FILE NO. _____
 FILING DATE _____
 FILE SIZE _____

*RECORD OF SURVEY
 FOR
 LAWRENCE JANSSEN
 IN
 SW 1/4 SEC. 19, T.11S. R.4W.
 SE 1/4 SEC. 24, T.11S. R.5W.
 OF THE WILL. MER.,
 BENTON COUNTY, ORE.*

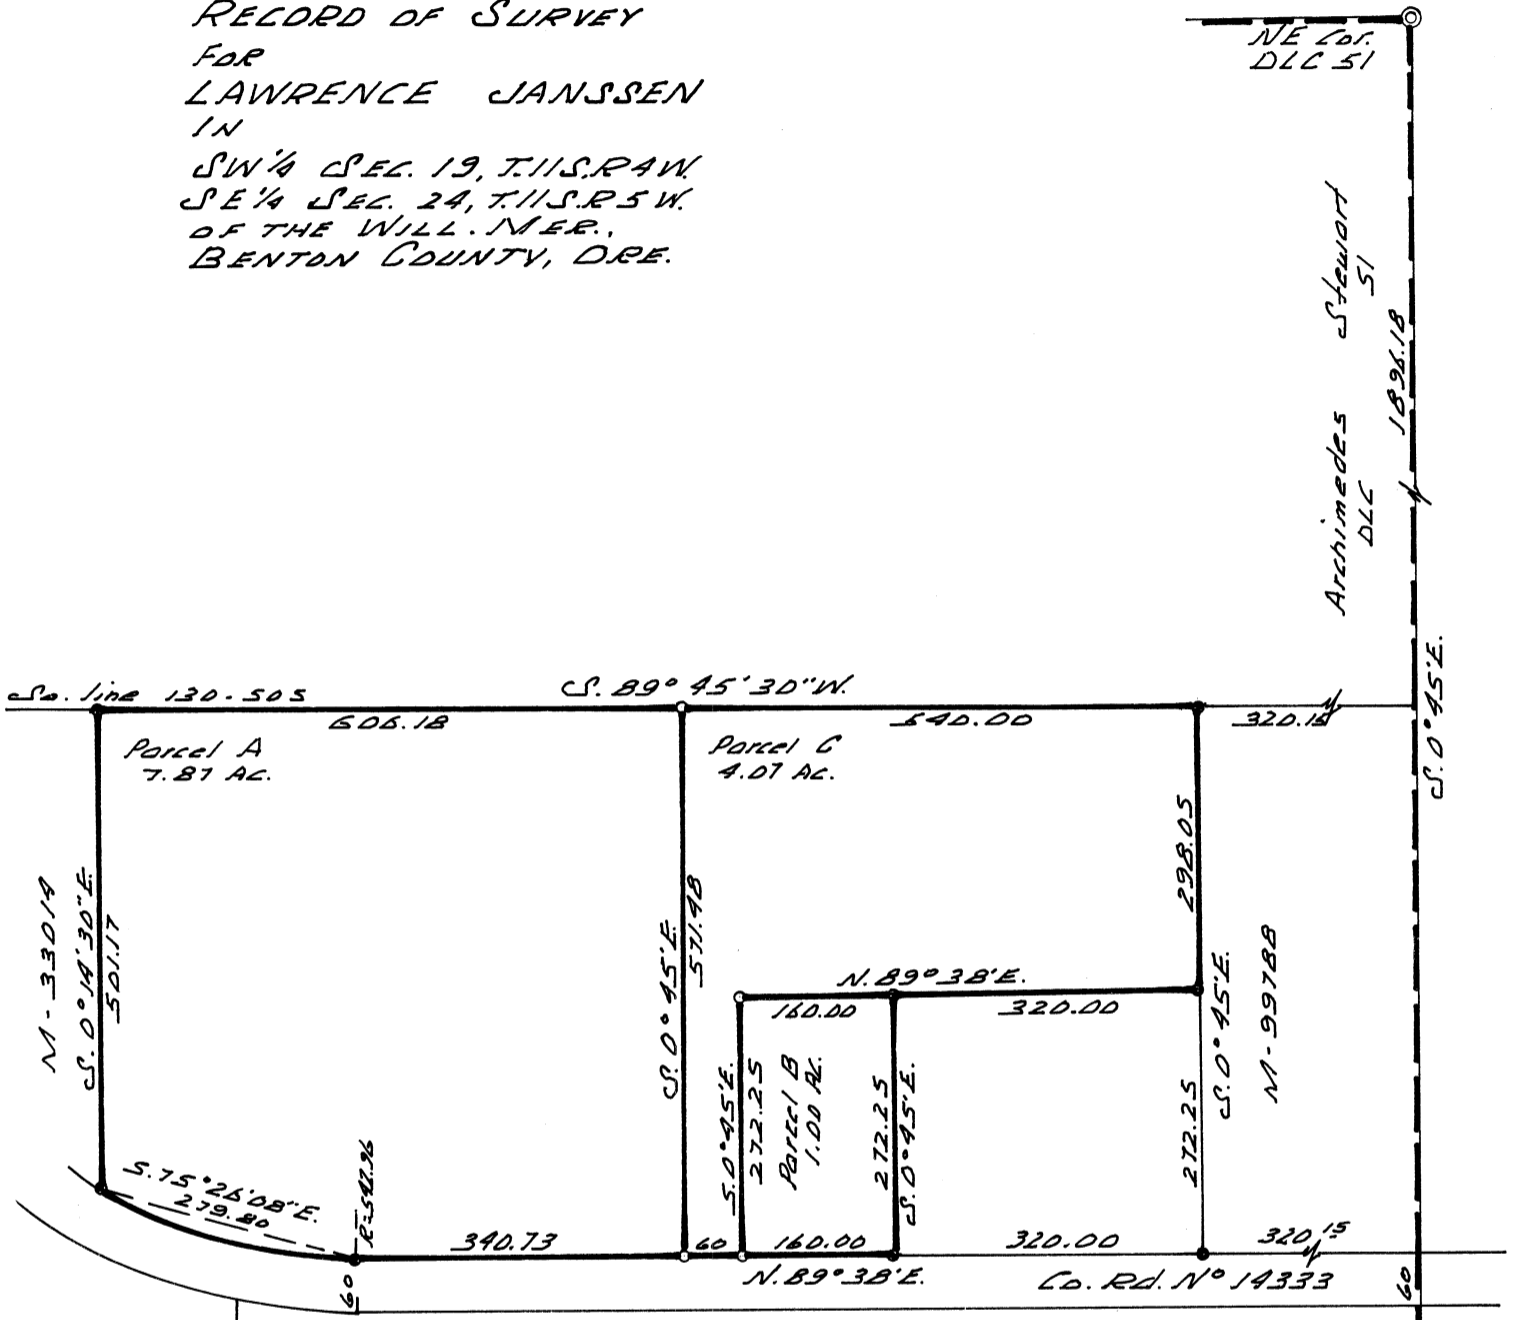

W O O D B U R N P A R K

SCALE 1"=200'
 SURVEYED 12-5-77
 ● = 5/8" iron rods Fd.
 ○ = 5/8" iron rods Set

REGISTERED
 PROFESSIONAL
 LAND SURVEYOR

Richard W. Fail

OREGON
 NOVEMBER 4, 1969
 RICHARD W. FAIL
 357

