


RECORD OF SURVEY  
 for PER SJOGREN  
 in THE ALFRED WITHAM DLC No. 55  
 NE 1/4 Sec. 28, T. 11S., R. 5W., W. M.  
 BENTON COUNTY, OREGON  
 January 1978

PLAT NO. 10000  
 DATE 1-27-78  
 FILE SIZE 8 1/2 X 14

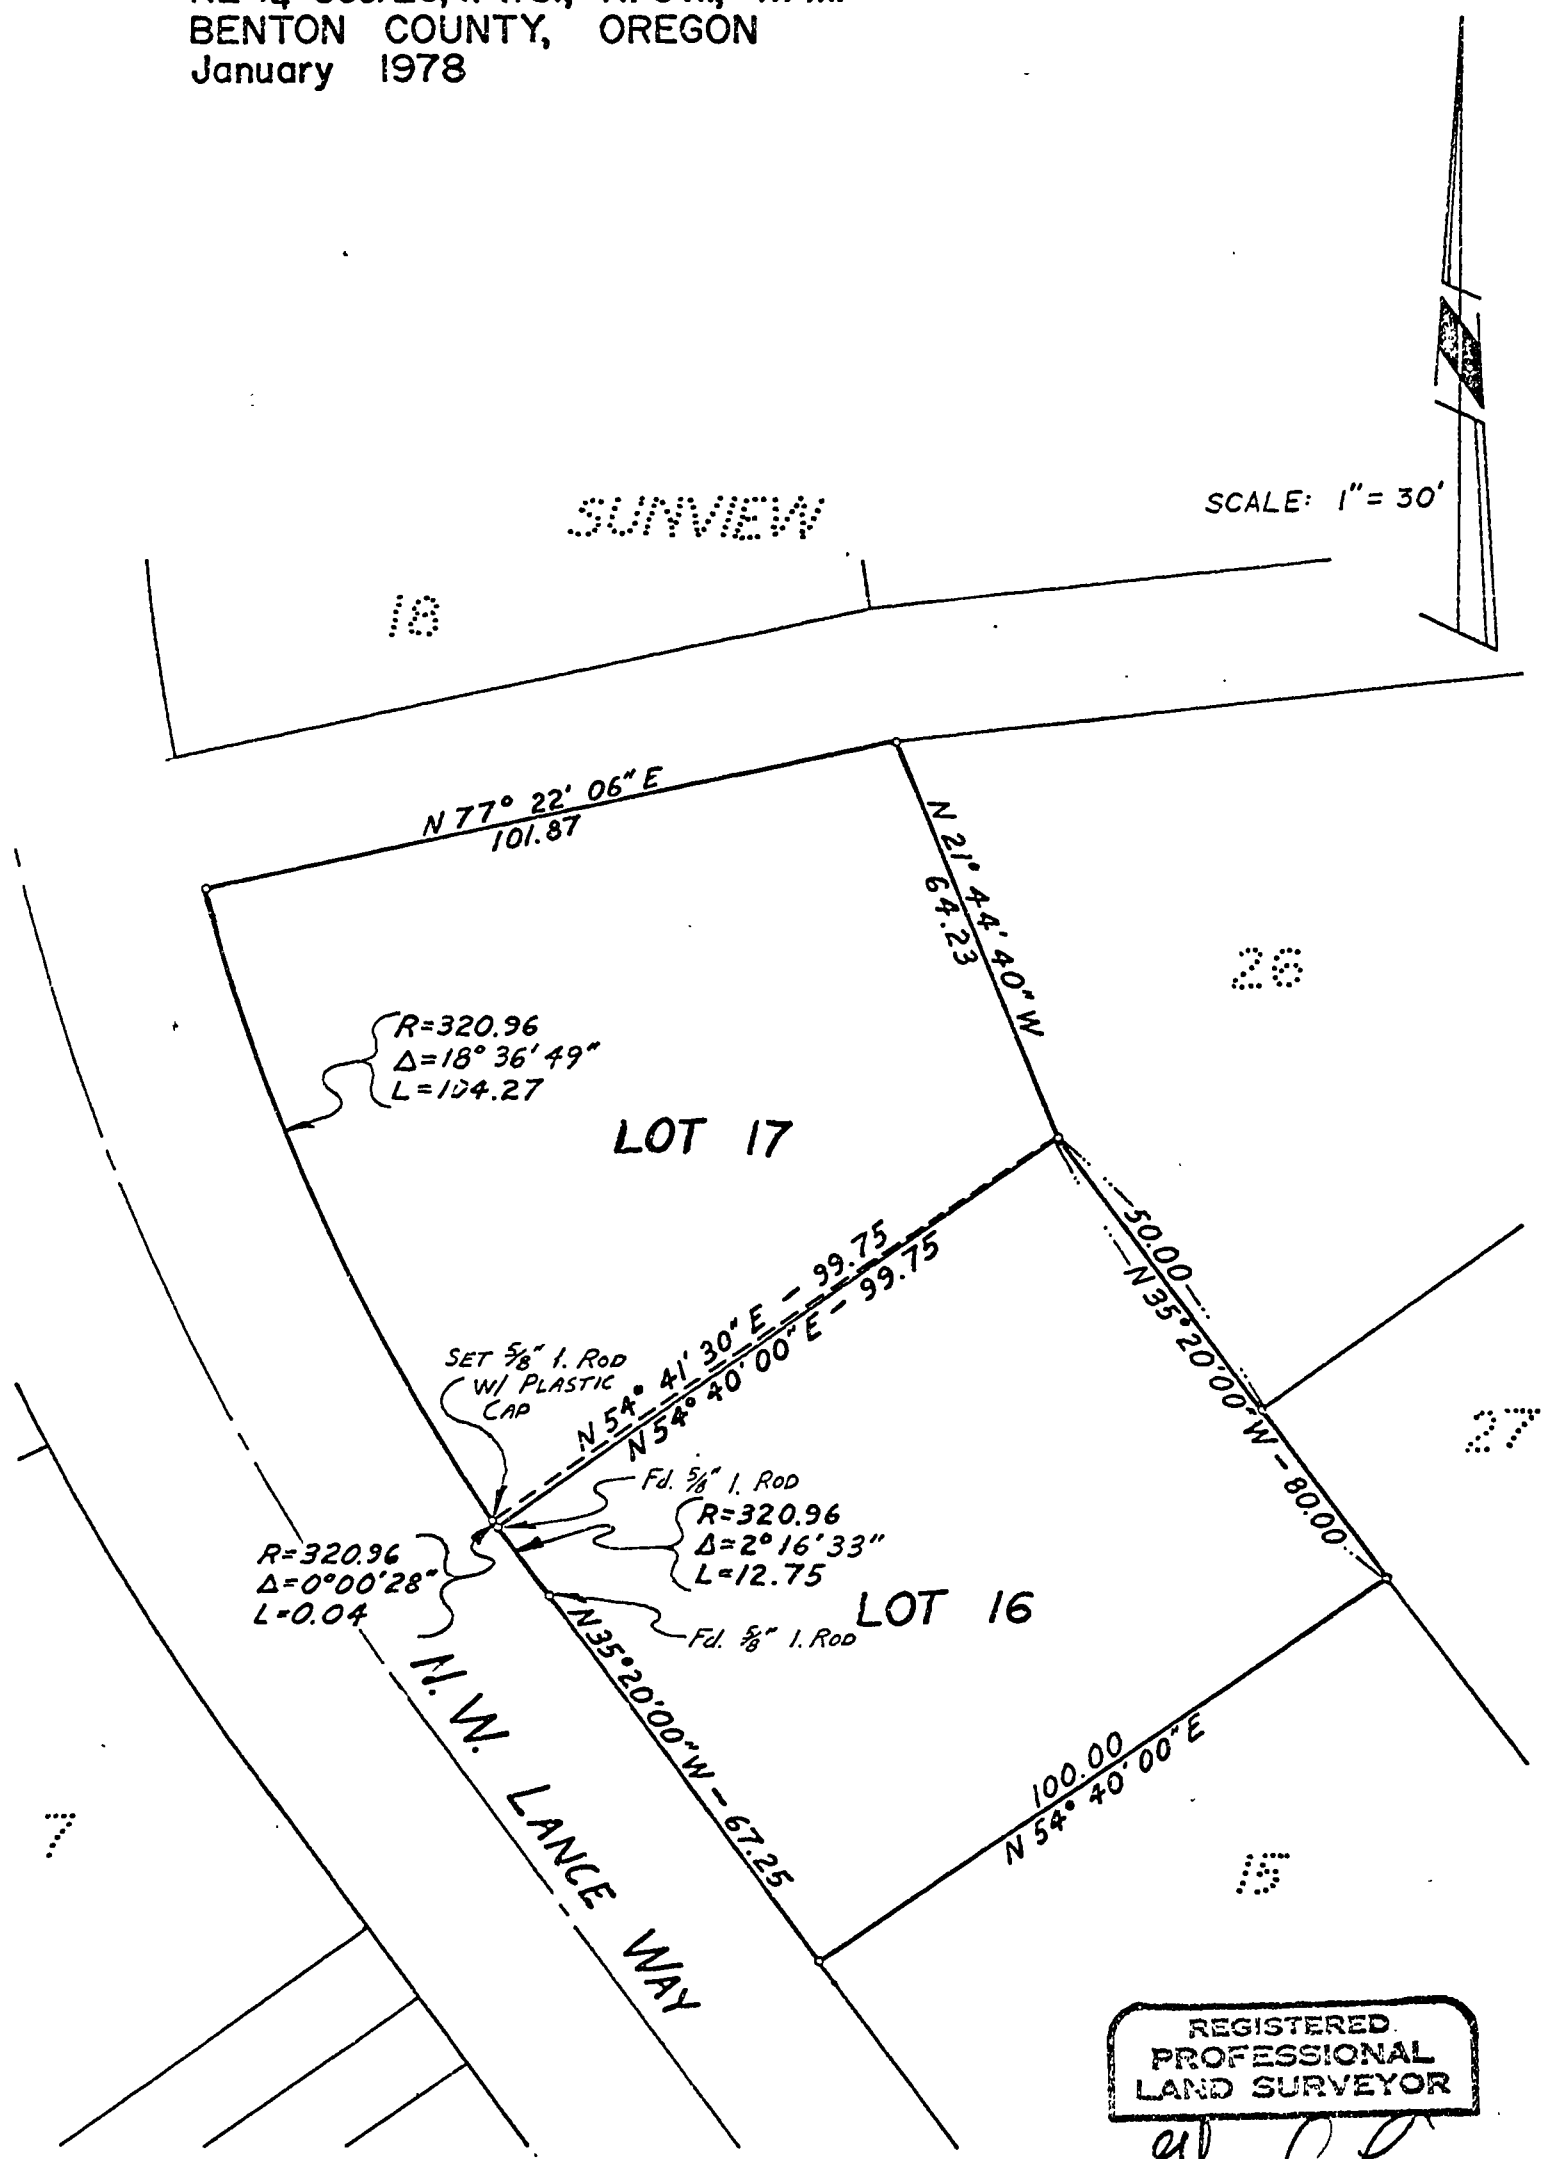

REGISTERED  
 PROFESSIONAL  
 LAND SURVEYOR

*Glenn A. Ling*  
 OREGON  
 SEPT. 30, 1977  
 GLENN A. LING  
 1433