

Benton Co. Surveyors Office  
 C.S. FILE NO. 610011  
 FILING DATE 3-27-78  
 FILE SIZE 18"


C.S.

**FRED ELLISON & H.J. BOERSMA**

S.W. 1/4 SECTION 1, T.11S., R. 4 W., W. M.

BENTON COUNTY, OREGON

Scale: 1" = 40' MARCH 10, 1978

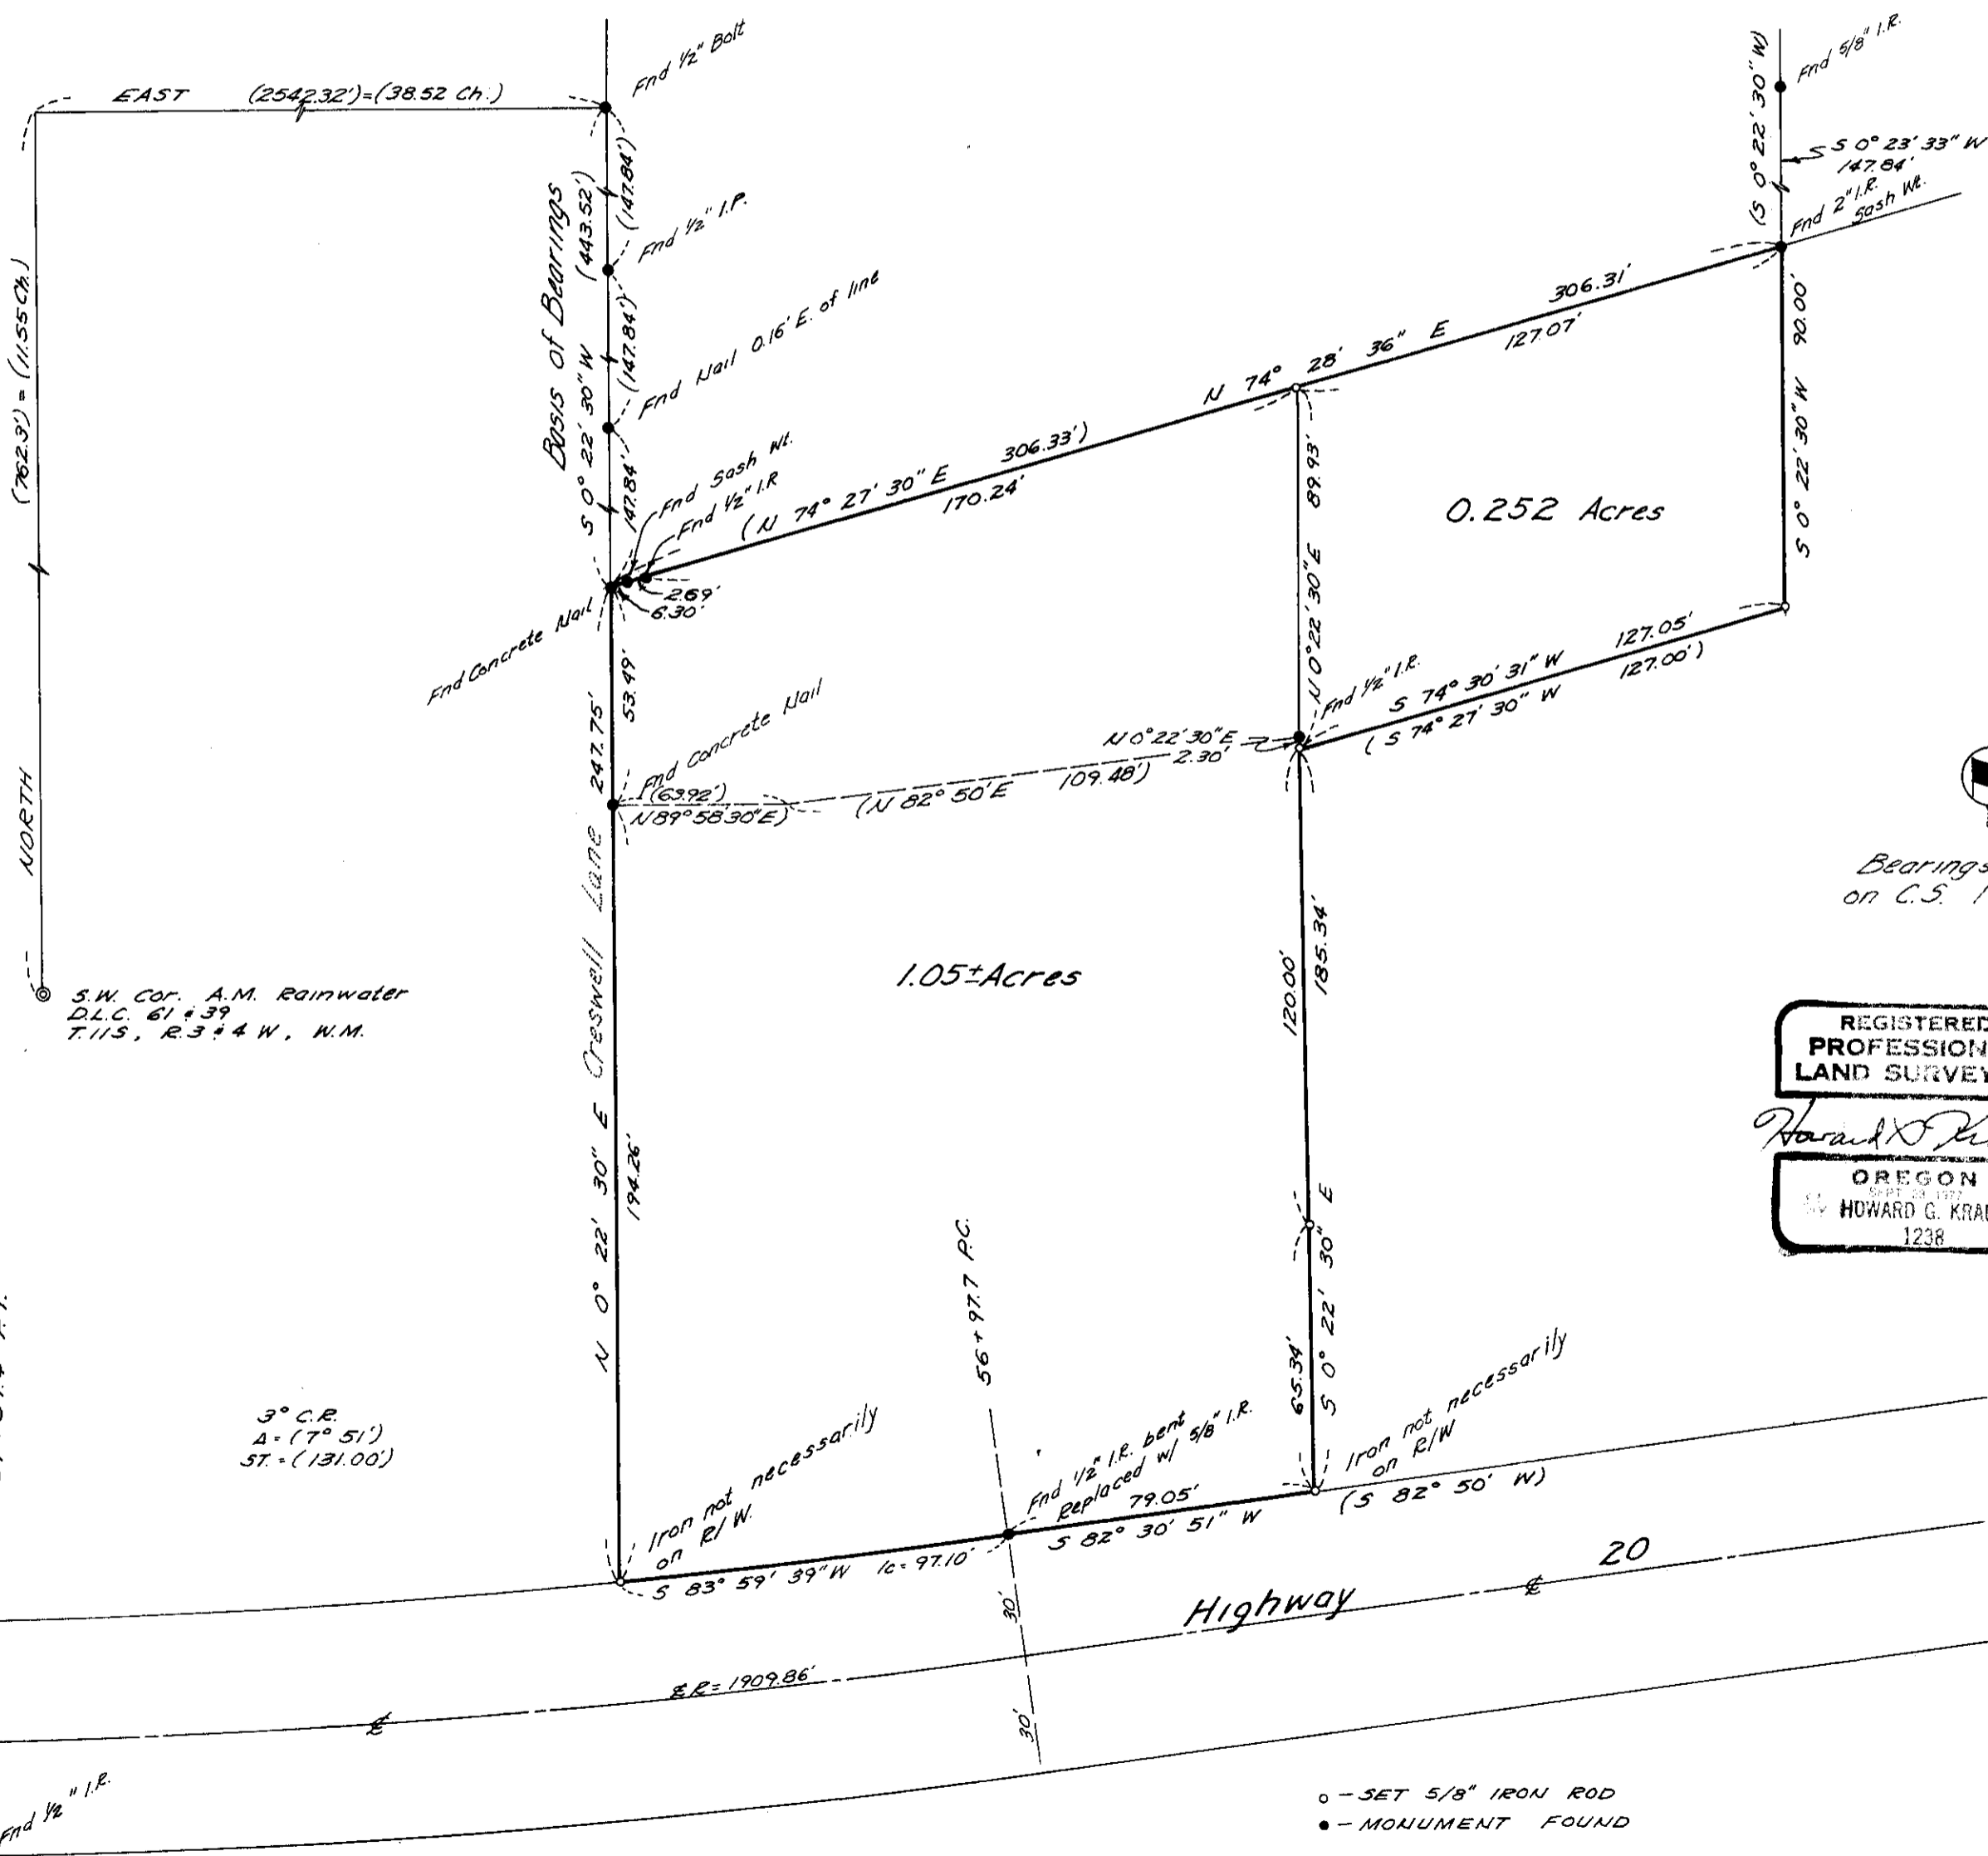

Bearings based on C.S. 1935

REGISTERED PROFESSIONAL LAND SURVEYOR

*Howard G. Kraus*

OREGON  
 SEP 24 1977  
 HOWARD G. KRAUS  
 1238

- - SET 5/8" IRON ROD
- - MONUMENT FOUND

