


Benton Co. Surveyors Office
 C. S. FILE NO. 05439
 FILING DATE 6-12-76
 FILE SIZE 3 1/2 x 14

RECORD OF SURVEY
 FOR JANET METZKER
 IN NE 1/4 SEC. 15 T.11 S. R.5 W.
 BENTON COUNTY, OREGON
 SCALE 1" = 200' JUNE 9, 1978

• = Monuments of record recorded on C.S. Nos. 5658 & 6439
 o = 3/8" x 30" rods set

REGISTERED PROFESSIONAL LAND SURVEYOR
Richard W. Fail
 OREGON NOVEMBER 4, 1932
 RICHARD W. FAIL 357

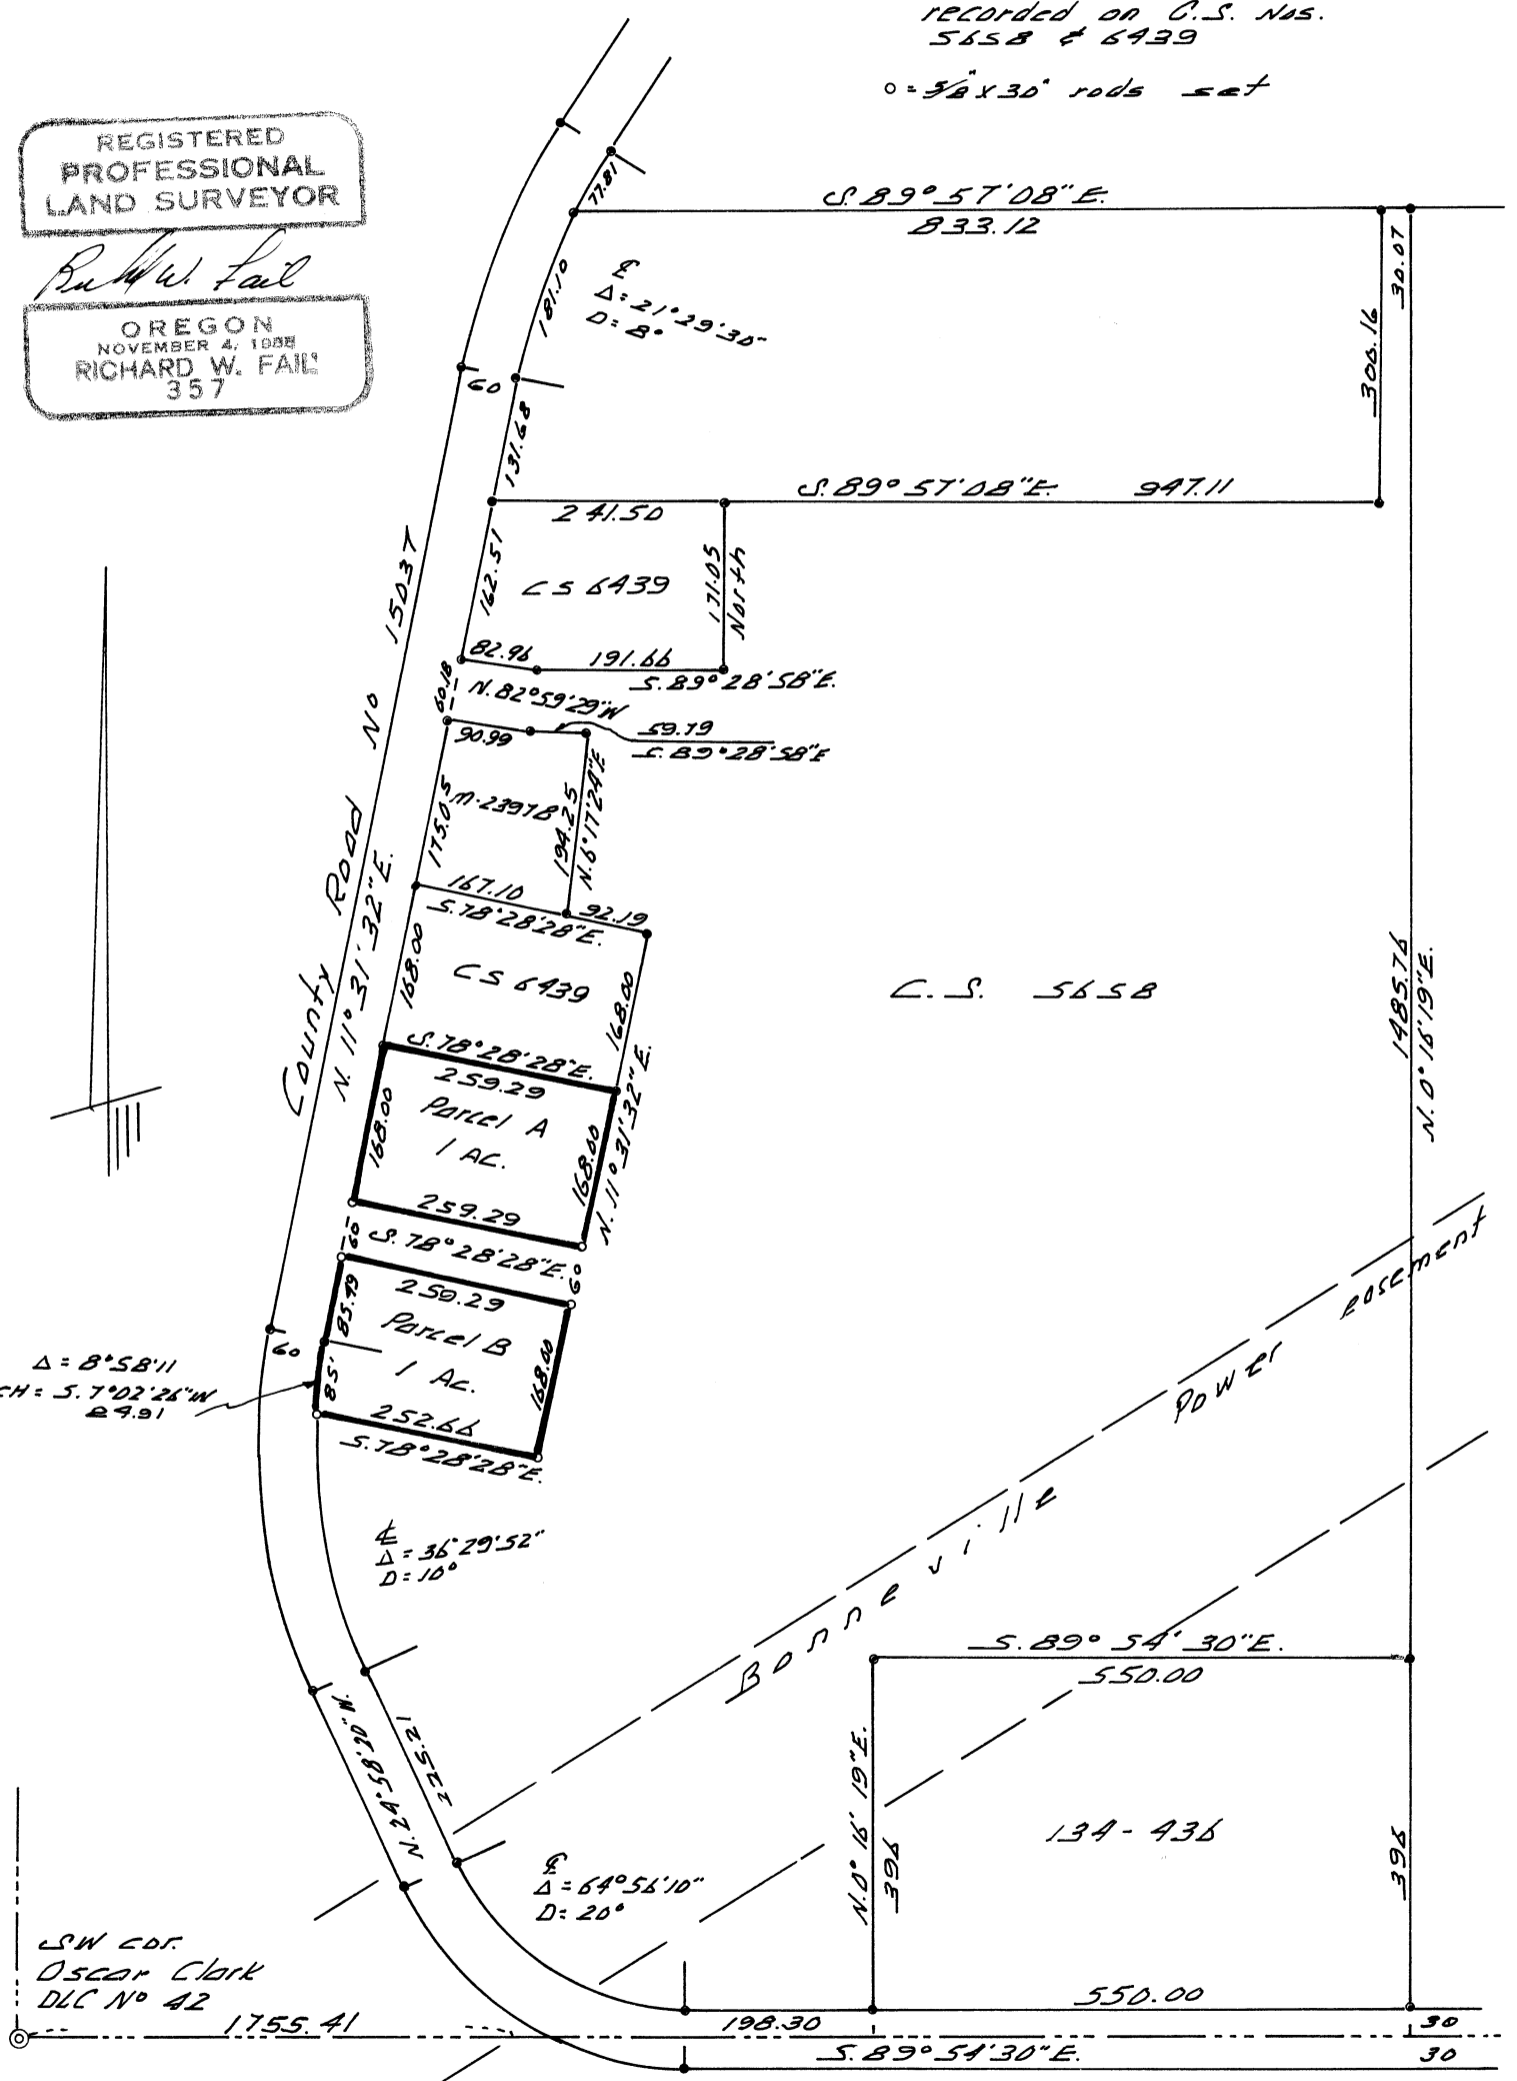

$\Delta = 8^{\circ} 58' 11''$
 CH = $S. 7^{\circ} 02' 28'' W.$
 249.91

SW COR.
 Oscar Clark
 DLC No 42
 1755.41