

0002

A SURVEY FOR SIDNEY BRICKHOUSE

IN FIRVIEW HOMES

S.W. 1/4 N.W. 1/4 Sec. 23

T. 10S. R. 4W., WM.

Benton County, Oregon

Scale 1"=50'


July 18, 1978

Benton Co. Surveyors Office

C. S. FILE NO. 06692

FILING DATE 8-15-78

FILE SIZE 18

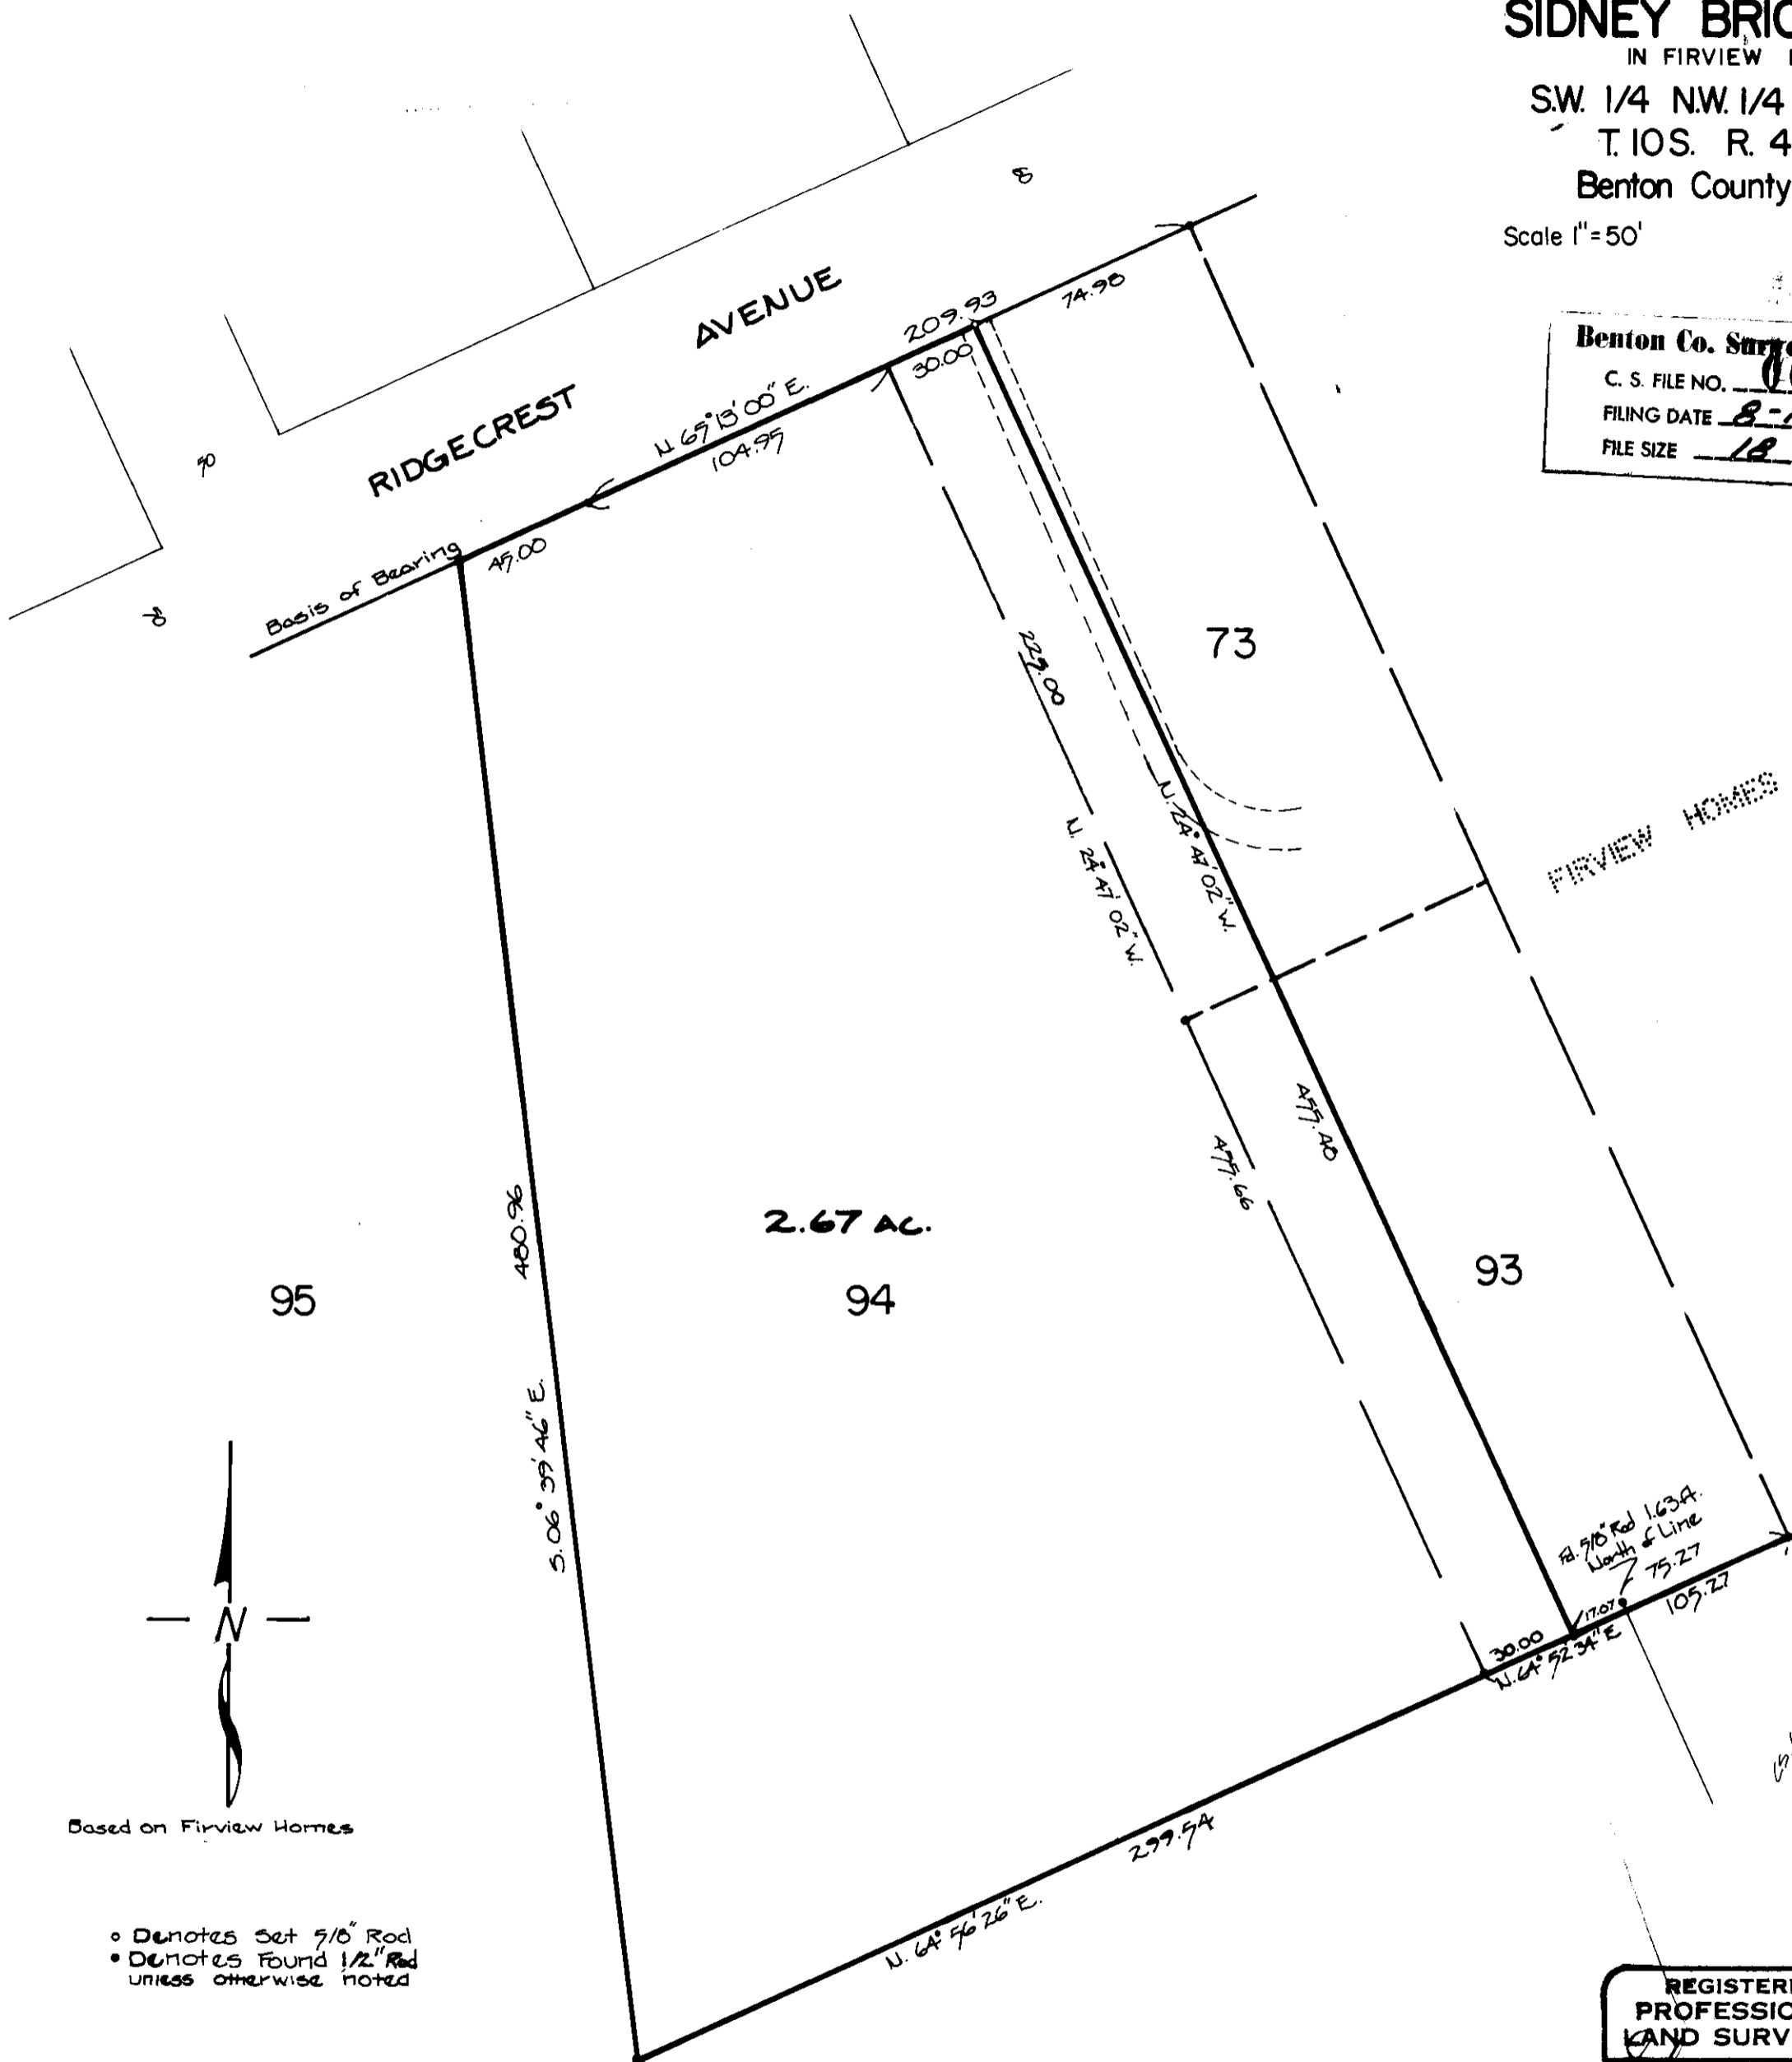

Based on Firview Homes

- Denotes Set 5/16" Rod
- Denotes Found 1/2" Rod unless otherwise noted

TIMBERLAND SERVICES, INC.
 1010 Airport Road P. O. Box 668
 Albany, Oregon 97321
 Telephone (503) 926-9404

LAND SURVEYING - ENGINEERING
 LAND USE PLANNING - ROADS
 FORESTRY CONSULTING

REGISTERED
PROFESSIONAL
LAND SURVEYOR

Edgar R. Cook

OREGON
JULY 30, 1976
EDGAR R. COOK
1073

06692