

06697


RECORD OF SURVEY
for TOM SKINNER

in LOT 4 BLOCK 1 GEE'S REVISED ADD'N
PHILOMATH, BENTON COUNTY, OREGON
NORRICE P. NEWTON D.L.C. No. 72, T. 12S., R. 5W., W. M.

AUGUST 1978
SCALE: 1" = 50'

Benton Co. Surveyors Office
C. S. FILE NO 06697
FILING DATE 8-15-78
FILE SIZE 8 1/2 X 14

REGISTERED
PROFESSIONAL
LAND SURVEYOR
Paul E. Green
OREGON
DECEMBER 2, 1977
PAUL E. GREEN
1521

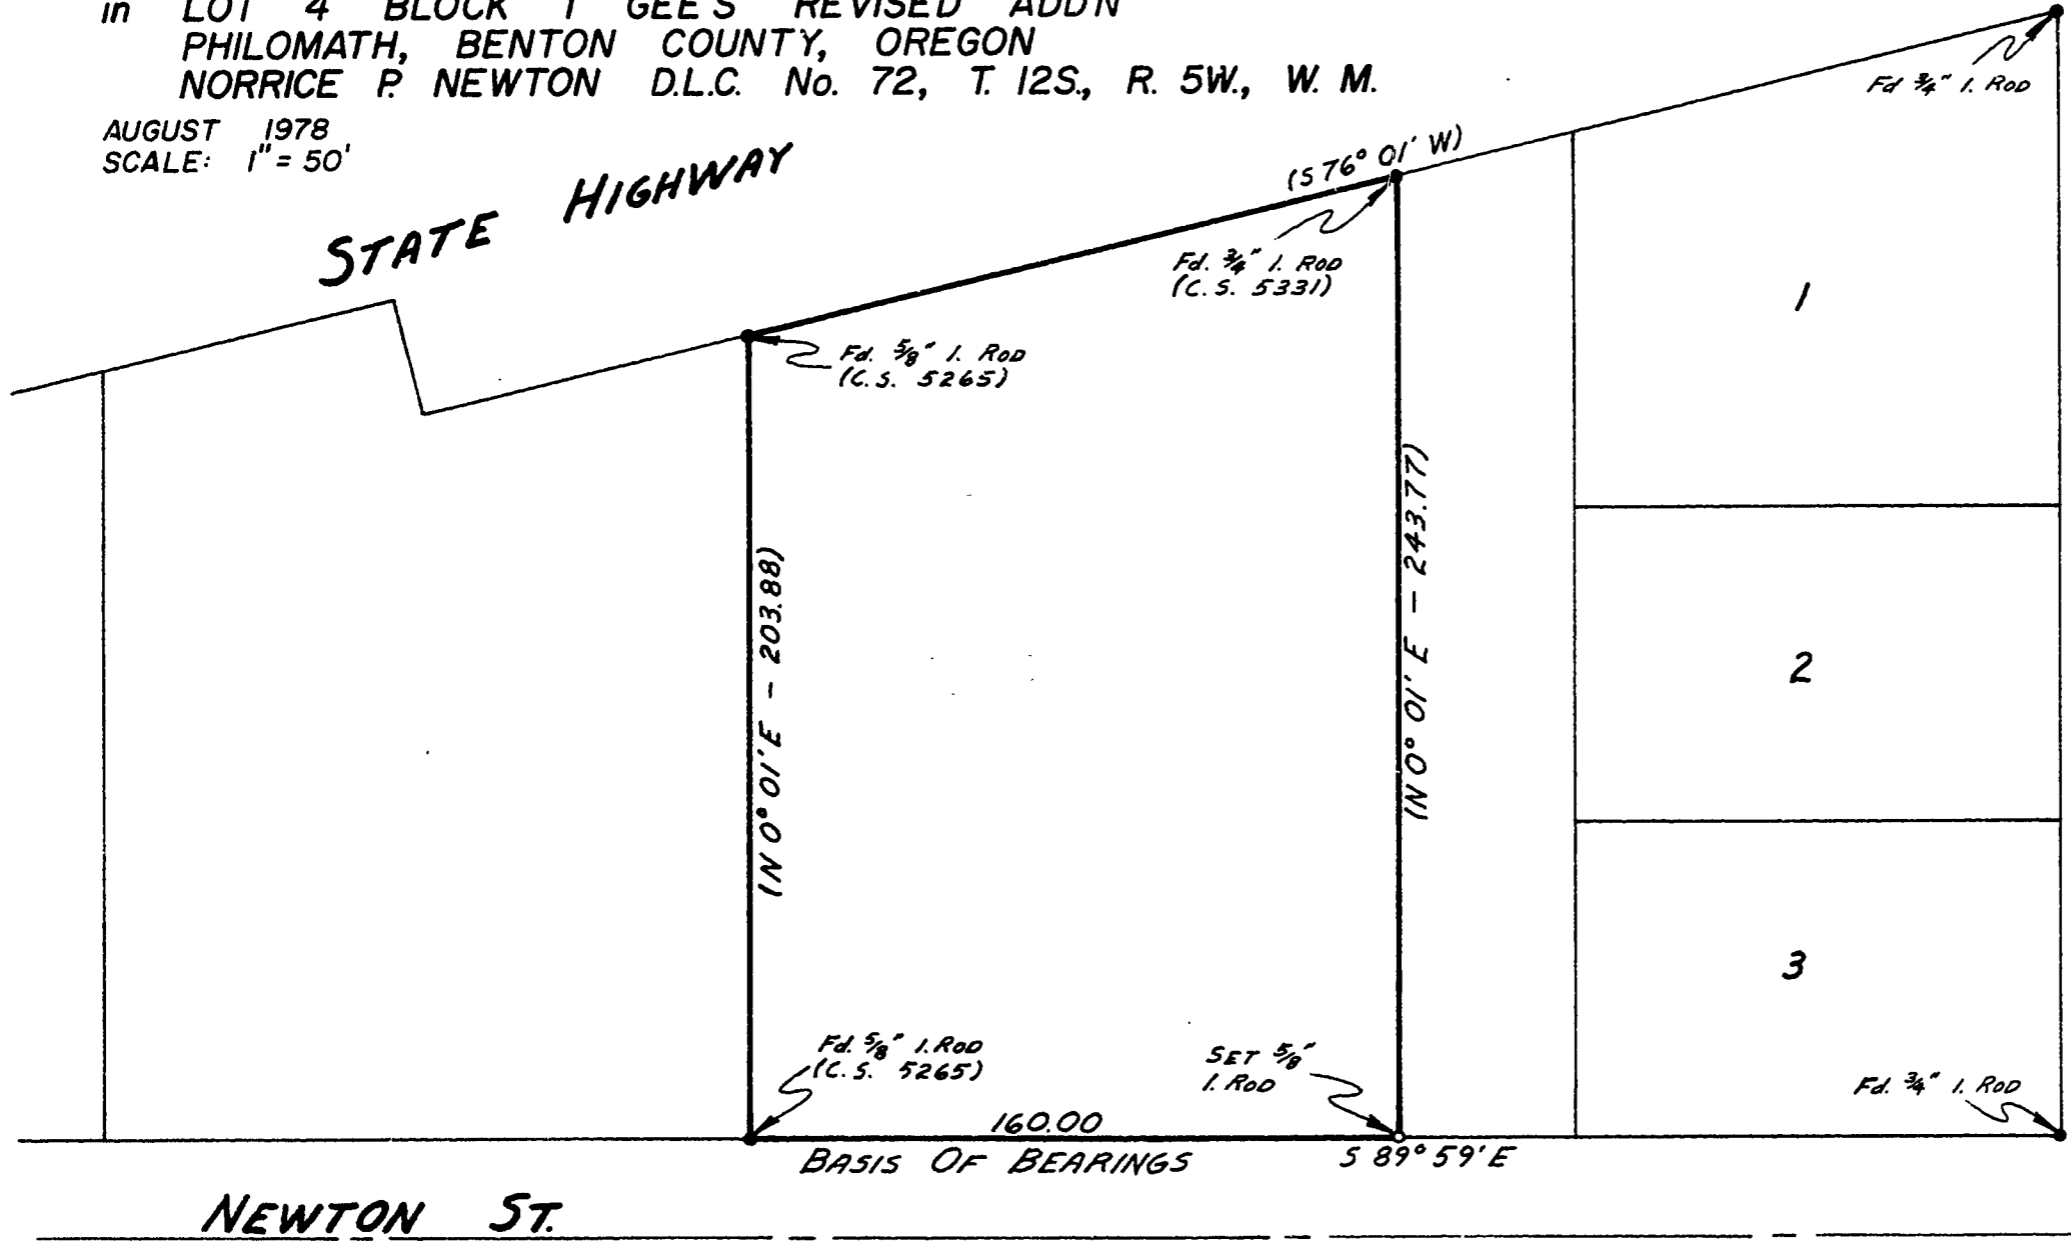

26th St.

LEGEND

- MONUMENT FOUND, AS NOTED
- SET $\frac{5}{8}''$ IRON ROD
- () RECORD DATA