


06725

Benton Co. Surveyors Office
 C. S. FILE NO. **06725**
 FILING DATE 9-8-78
 FILE SIZE 8 1/2 x 14

RECORD OF SURVEY
 for **LOU WINTERSTEIN**
 in SW 1/4 SEC. 33, T. 11S., R. 6W., W.M.
 BENTON COUNTY, OREGON
 AUGUST 1978
 SCALE: 1"=200'

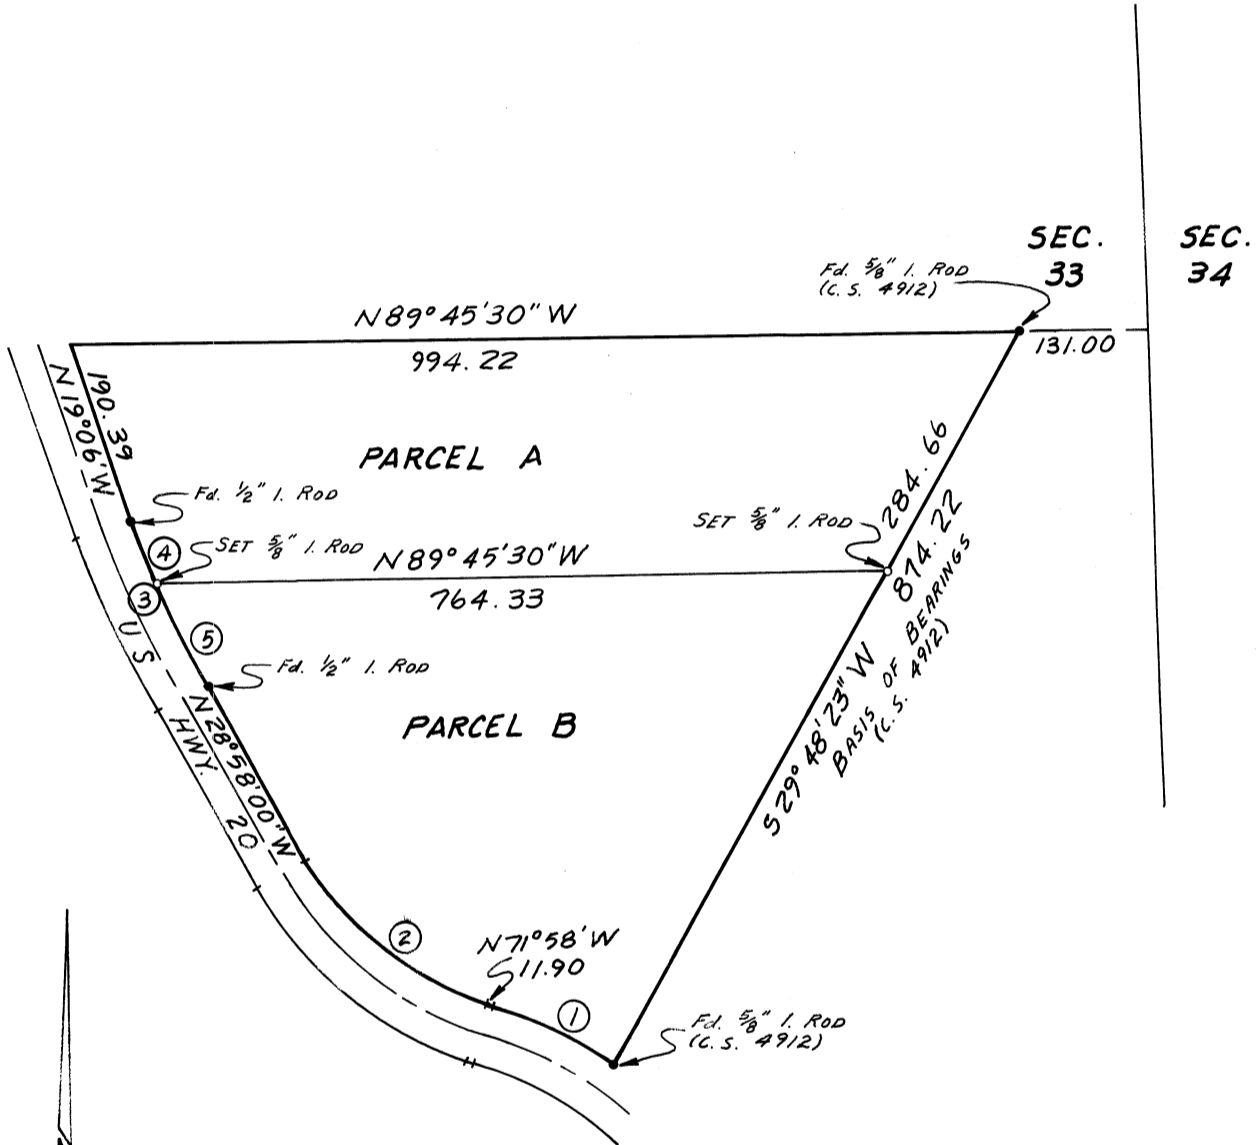

CURVE DATA

No.	R	Δ	L	BEARING	CHORD DISTANCE
1.	388.10	19°55'49"	135.00	N62°00'06"W	134.32
2.	328.10	43°02'00"	246.43	N50°29'00"W	240.68
3.	1115.92	9°50'00"	191.52	N24°01'00"W	191.28
4.	1115.92	3°44'36"	72.90	N20°58'18"W	72.89
5.	1115.92	6°05'24"	118.61	N25°53'18"W	118.56

REGISTERED
 PROFESSIONAL
 LAND SURVEYOR

Jack R. Burrell

OREGON
 JACK R. BURRELL
 1639