


C.S. FILE NO. 6743
FILING DATE 10-10-78
FILE SIZE 8 1/2 x 14

RECORD OF SURVEY
for WILLARD GRANT
in ARNOLD FULLER D.L.C. No. 38
N.E. 1/4 SEC. 11, T. 11S., R. 5W., W. M.
BENTON COUNTY, OREGON
SEPTEMBER 1978
SCALE: 1" = 100'

REGISTERED
PROFESSIONAL
LAND SURVEYOR

Jack R. Burrell

OREGON
JACK R. BURRELL
1820

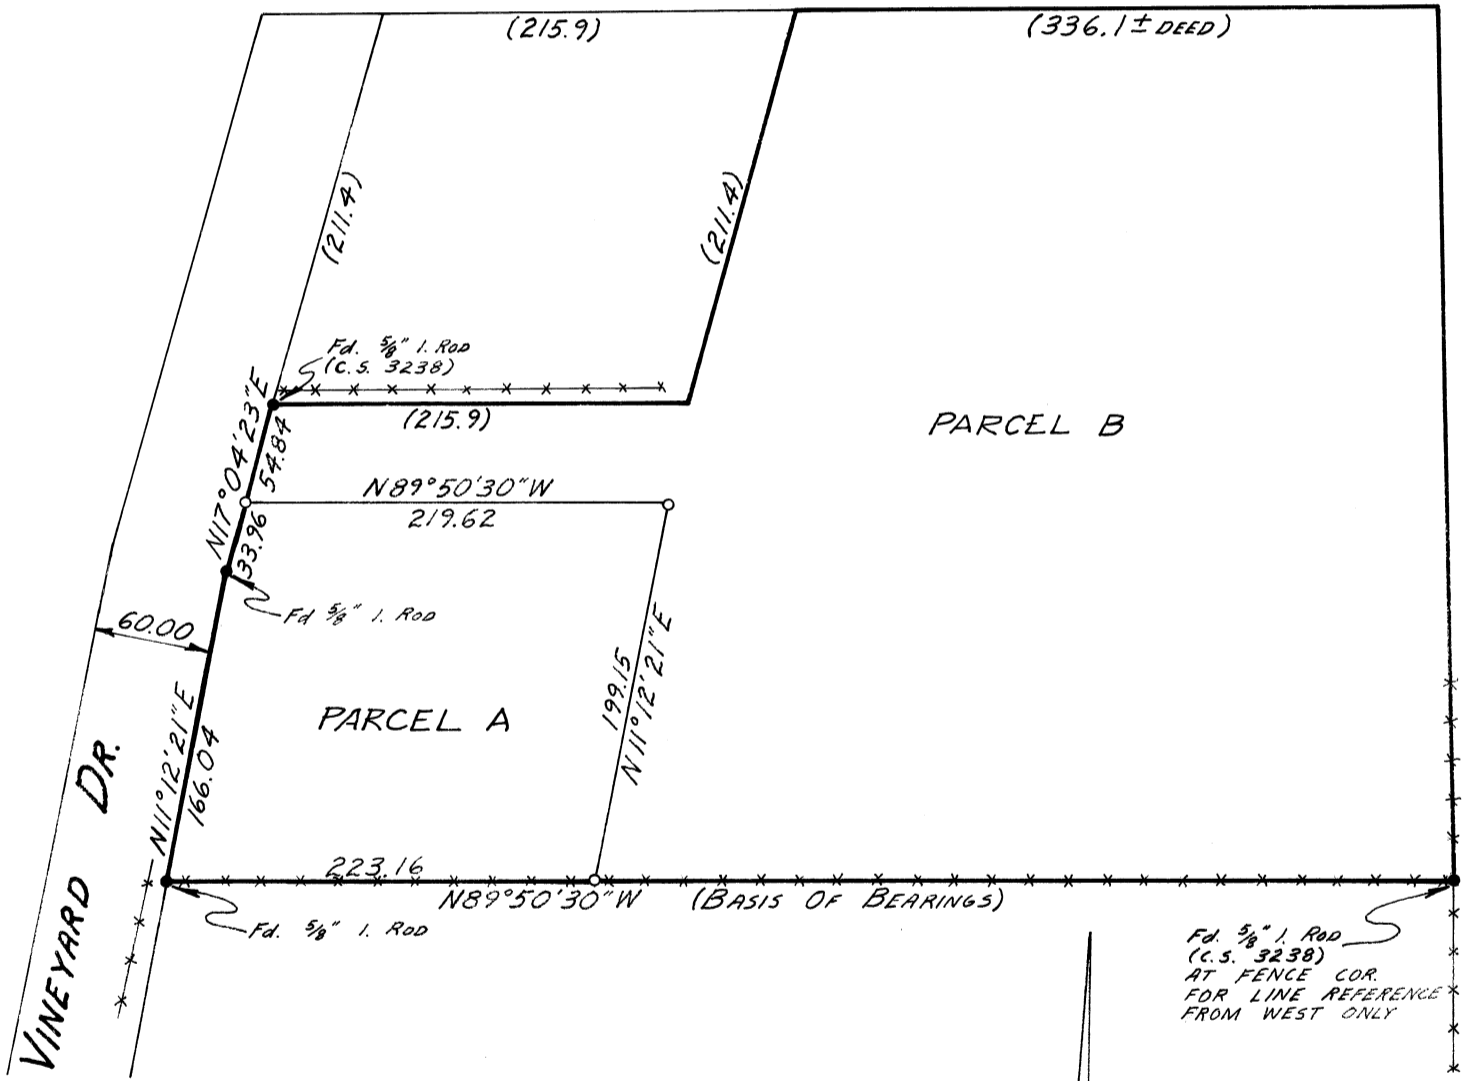

LEGEND

- SET 5/8" IRON ROD WITH PLASTIC CAP
- FOUND MONUMENT, AS NOTED
- *** FENCE
- () RECORD DATA

