


Benton Co. Surveyors Office

C. S. FILE NO. 6750
FILING DATE 10-10-78
FILE SIZE 8 1/2-14

C. S. _____

(REILING RD. (CENTER ST.))

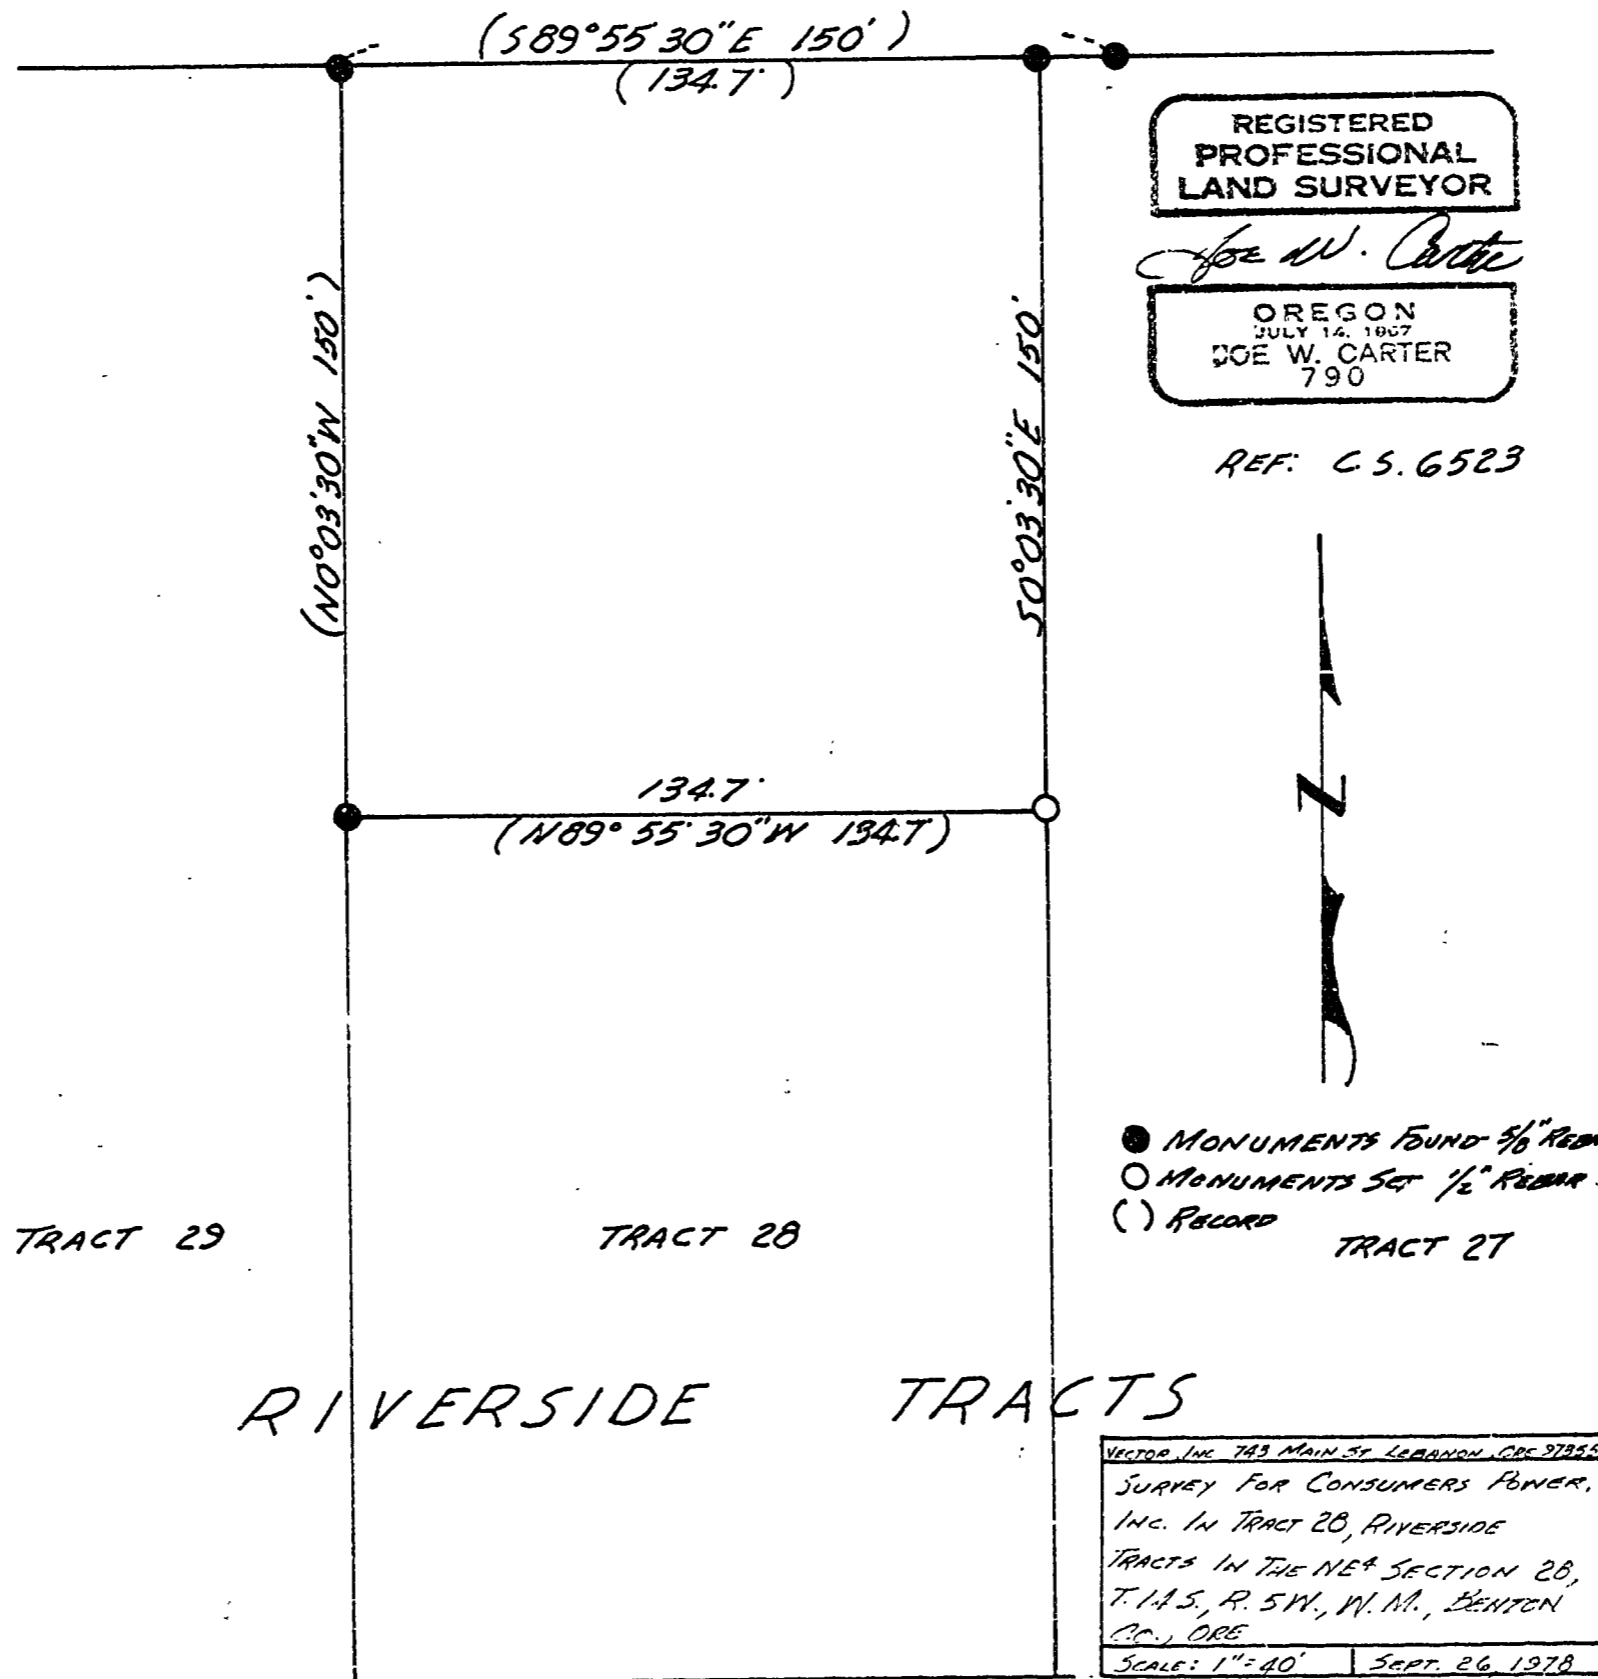

REGISTERED
PROFESSIONAL
LAND SURVEYOR

Joe W. Carter

OREGON
JULY 12, 1907
JOE W. CARTER
790

REF: C.S. 6523



- MONUMENTS FOUND 3/8\" REBAR
- MONUMENTS SET 1/2\" REBAR
- () RECORD

TRACT 29

TRACT 28

TRACT 27

RIVERSIDE TRACTS

VECTOR, INC. 743 MAIN ST. LEWISBURG, ORE. 97355
SURVEY FOR CONSUMERS POWER,
INC. IN TRACT 28, RIVERSIDE
TRACTS IN THE NE 1/4 SECTION 28,
T. 14 S., R. 5 W., W. M., BENTON
CO., ORE.
SCALE: 1\" = 40' | SEPT. 26, 1978