


6785

6785

Benton Co. Surveyors Office
 C. S. FILE NO. 6785
 FILING DATE 11-13-78
 FILE SIZE 18

SURVEY FOR T.R. GREGG
 PART OF LOT 8 PLEASANT VIEW
 FARMS IN THE GEO. W. BETHERS
 D.L.C. NO. 49, SW 1/4, SEC 9,
 TOWNSHIP 12S RANGE 5W OF
 WM

OCT 27, 1978

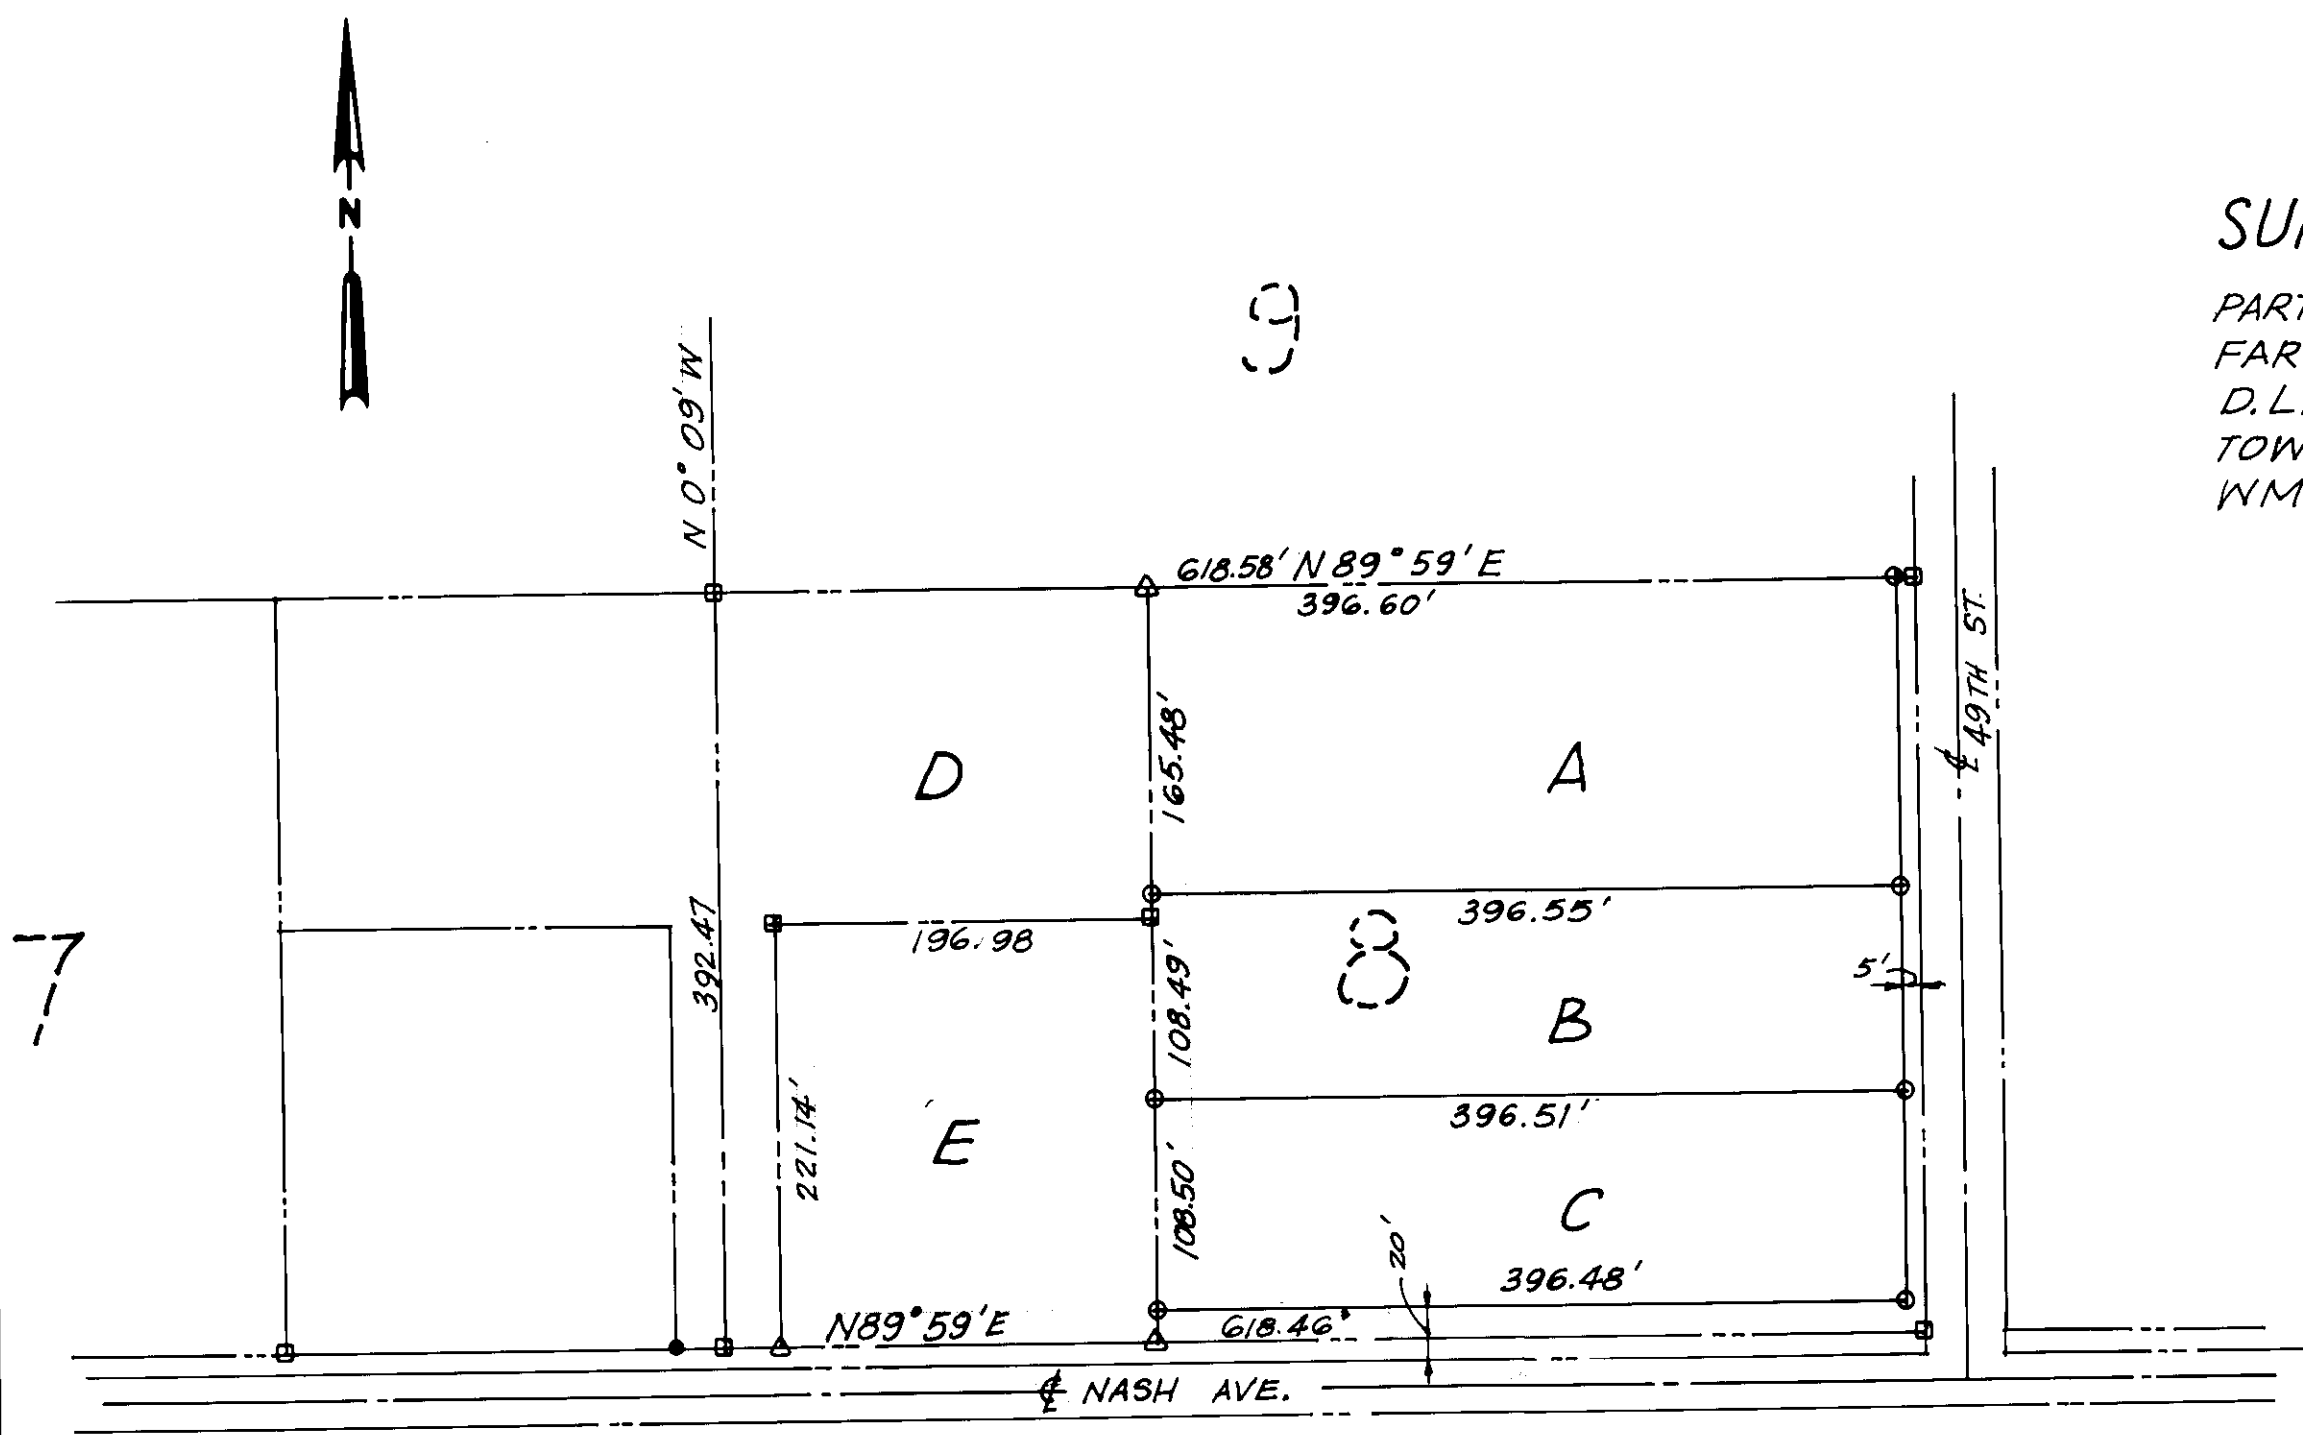

- DENOTES 5/8" IRON ROD FOUND
- " 3/4" PIPE "
- △ " 1" " "
- " 3/4" " SET

BASIS OF BEARINGS CS 4694
 SCALE: 1" = 100'

REGISTERED
 PROFESSIONAL
 LAND SURVEYOR
William F. Farley
 OREGON
 OCTOBER 28, 1977
 WILLIAM F. FARLEY
 1492

6785