


RECORD OF SURVEY

for L.E. MERRITT
 in N.W. 1/4 SEC. 7, T.11 S., R. 7 W., WM.
 BENTON COUNTY, OREGON
 JANUARY 22, 1979
 SCALE: 1" = 200'

6832
 1-22-79
 18"

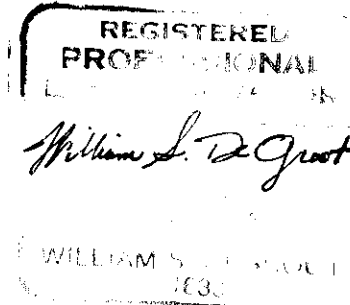

E. 1/16 S 6/57


FD. 40" dia. FIR SNAG, 18ft. TALL

MARKED BEARING TREES:

A FIR, 10" dia., BRS. S.17°E., 8.6'
 MKD. "X", with PK. nail in base.

A FIR, 13" dia., BRS. S. 72°E., 30.5'
 MKD. "X", with PK. nail in base.

22.32 ACRES

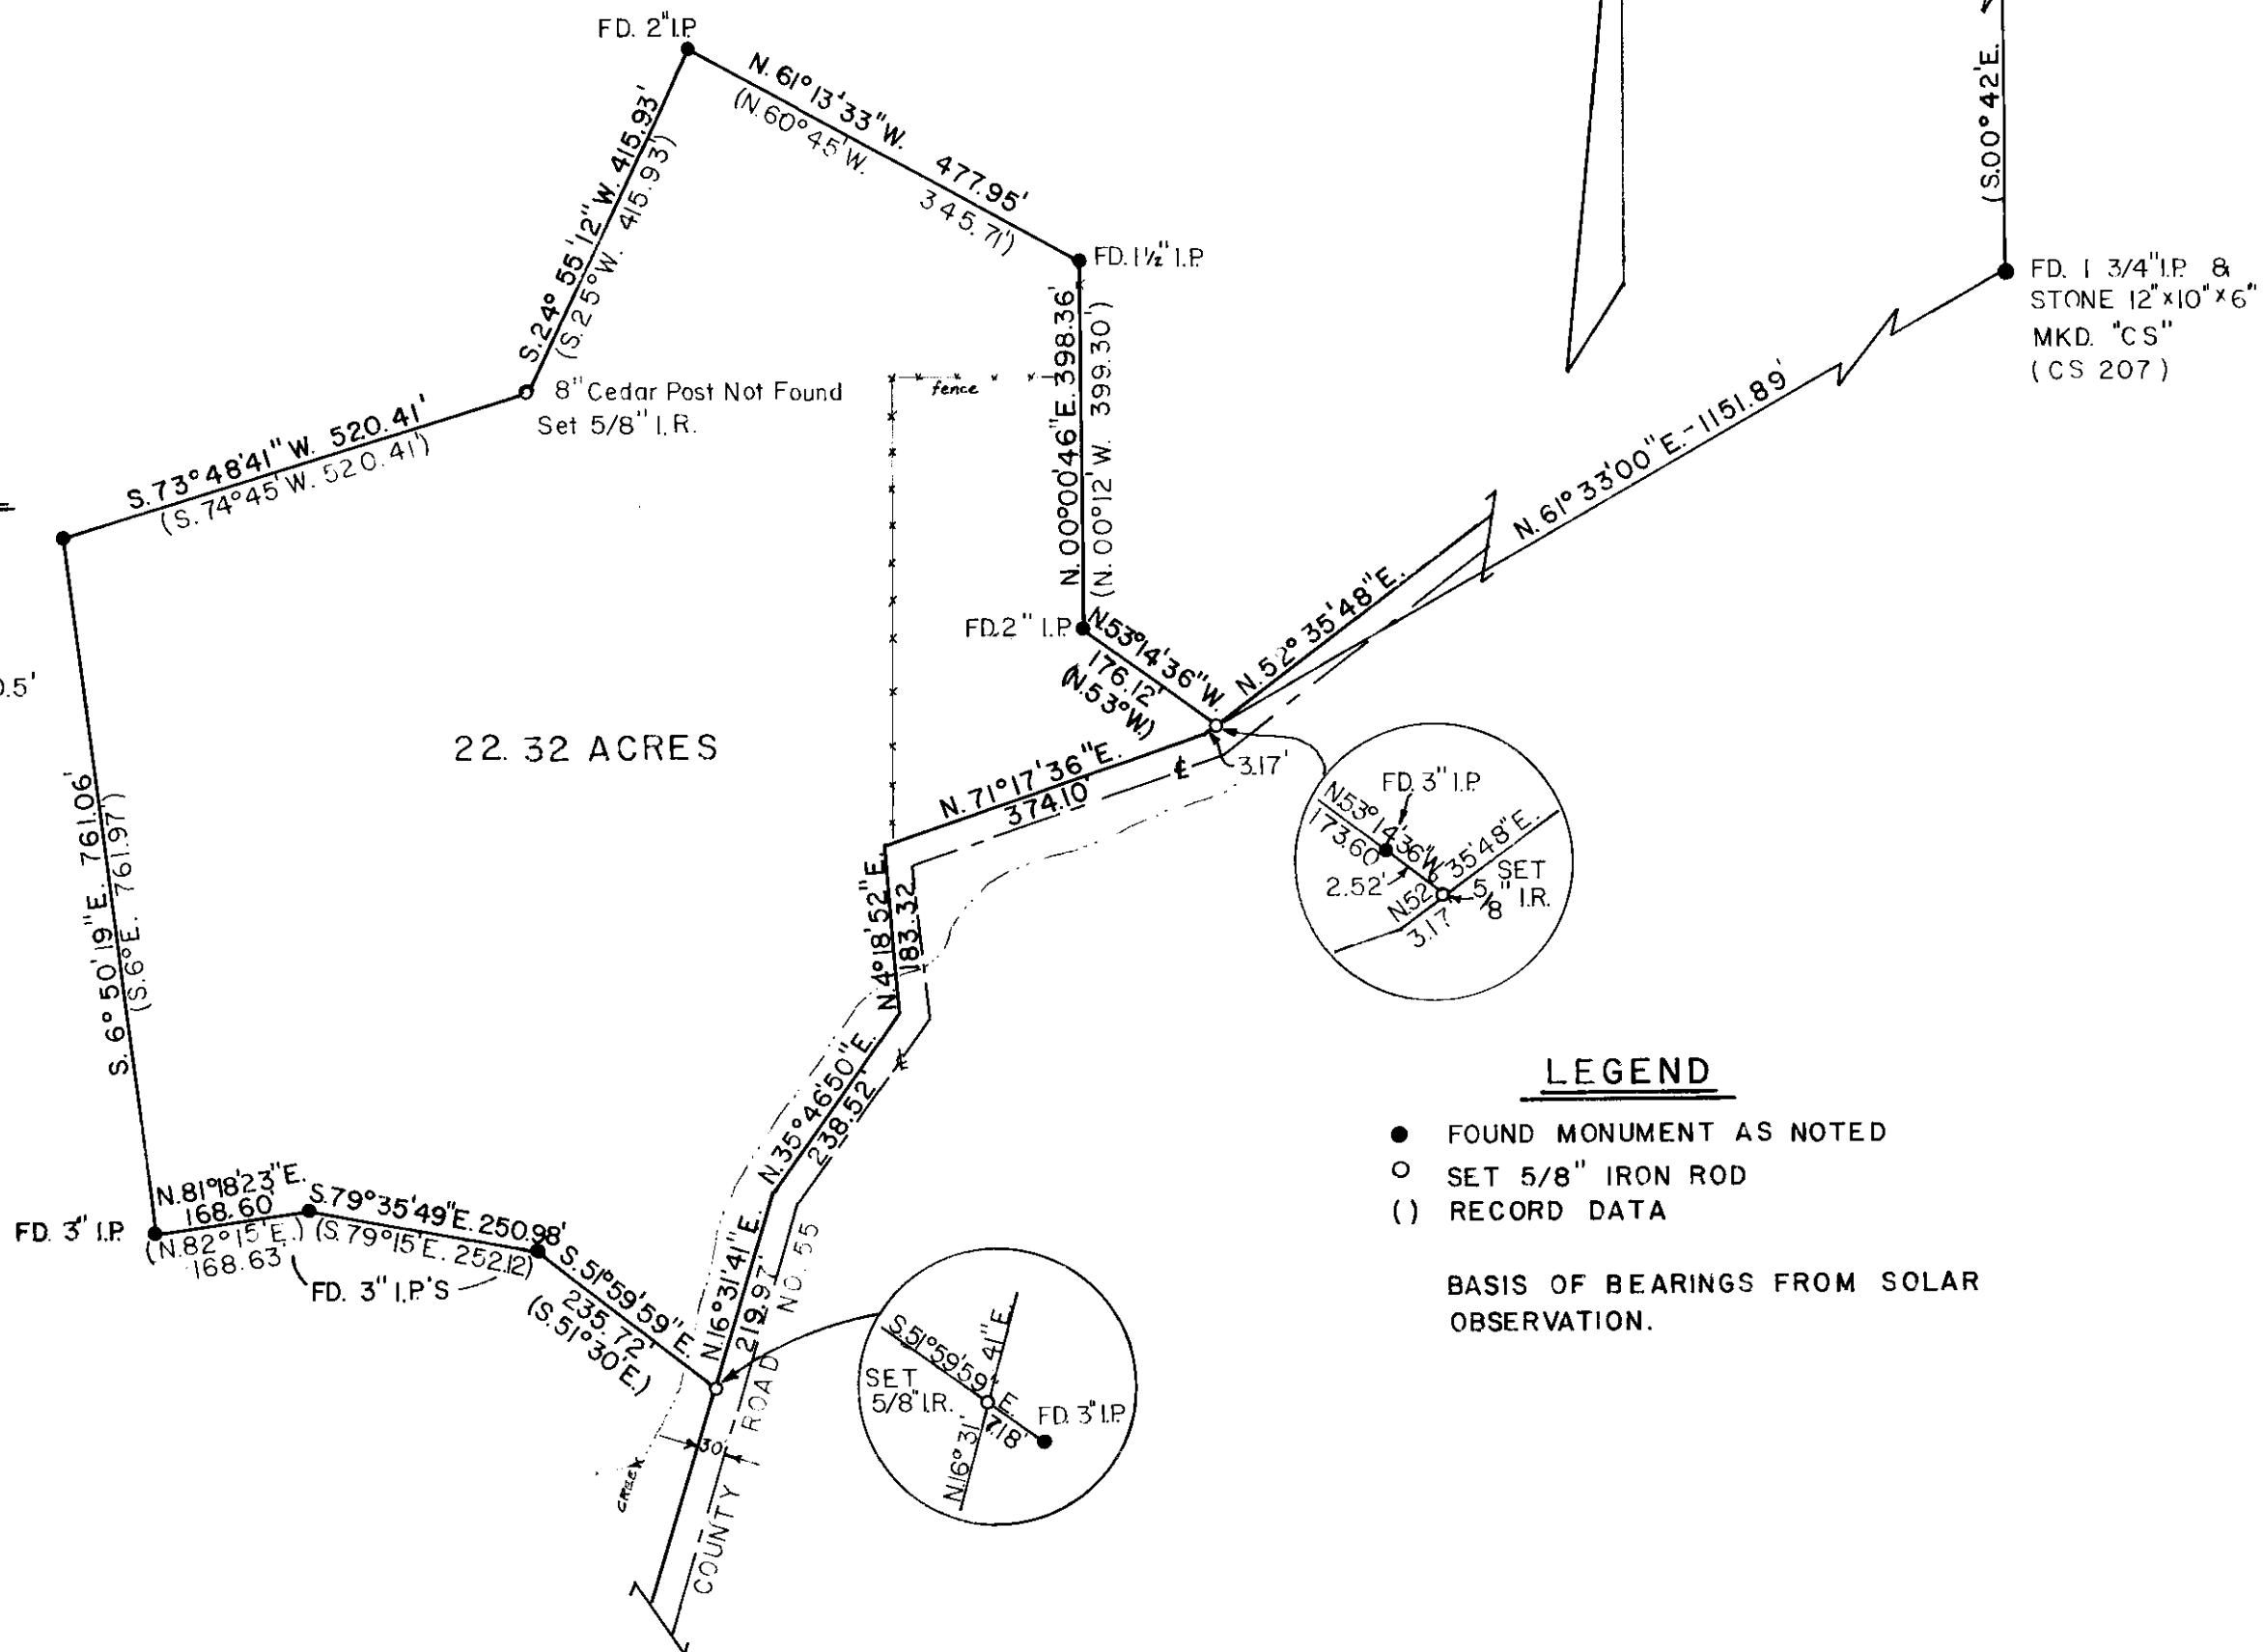

LEGEND

- FOUND MONUMENT AS NOTED
- SET 5/8" IRON ROD
- () RECORD DATA

BASIS OF BEARINGS FROM SOLAR OBSERVATION.

6832

6832