
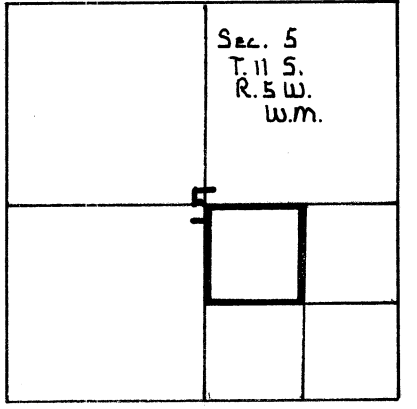


Benton Co. Surveyors Office
 C. & F. NO. 6855
 FILING DATE 3-14-79
 FILE SIZE 18"

MAP OF SURVEY
 FOR: JEROME & JACQUELINE DIETZ
 EMILE R. FETHERSTON
 IN THE NORTH WEST 1/4 OF THE SOUTH EAST 1/4
 OF SECTION 5
 TOWNSHIP 11 SOUTH, RANGE 5 WEST OF WIL. MER.
 BENTON COUNTY OREGON
 Scale 1" = 100' December 27, 1973
 (Revised 3-14-79)

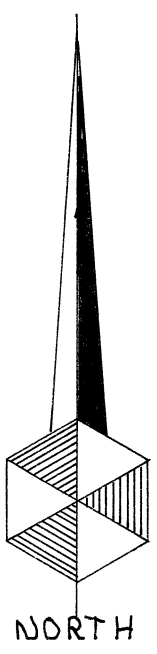

6855

6855