

RECORD OF SURVEY

for

GARY MINISZEWSKI


in

SW 1/4 SECTION 2, JOSEPH C. AVERY D.L.C. 41,

T12S., R.5W., WILLAMETTE MERIDIAN,

BENTON COUNTY, OREGON

MAY, 1979

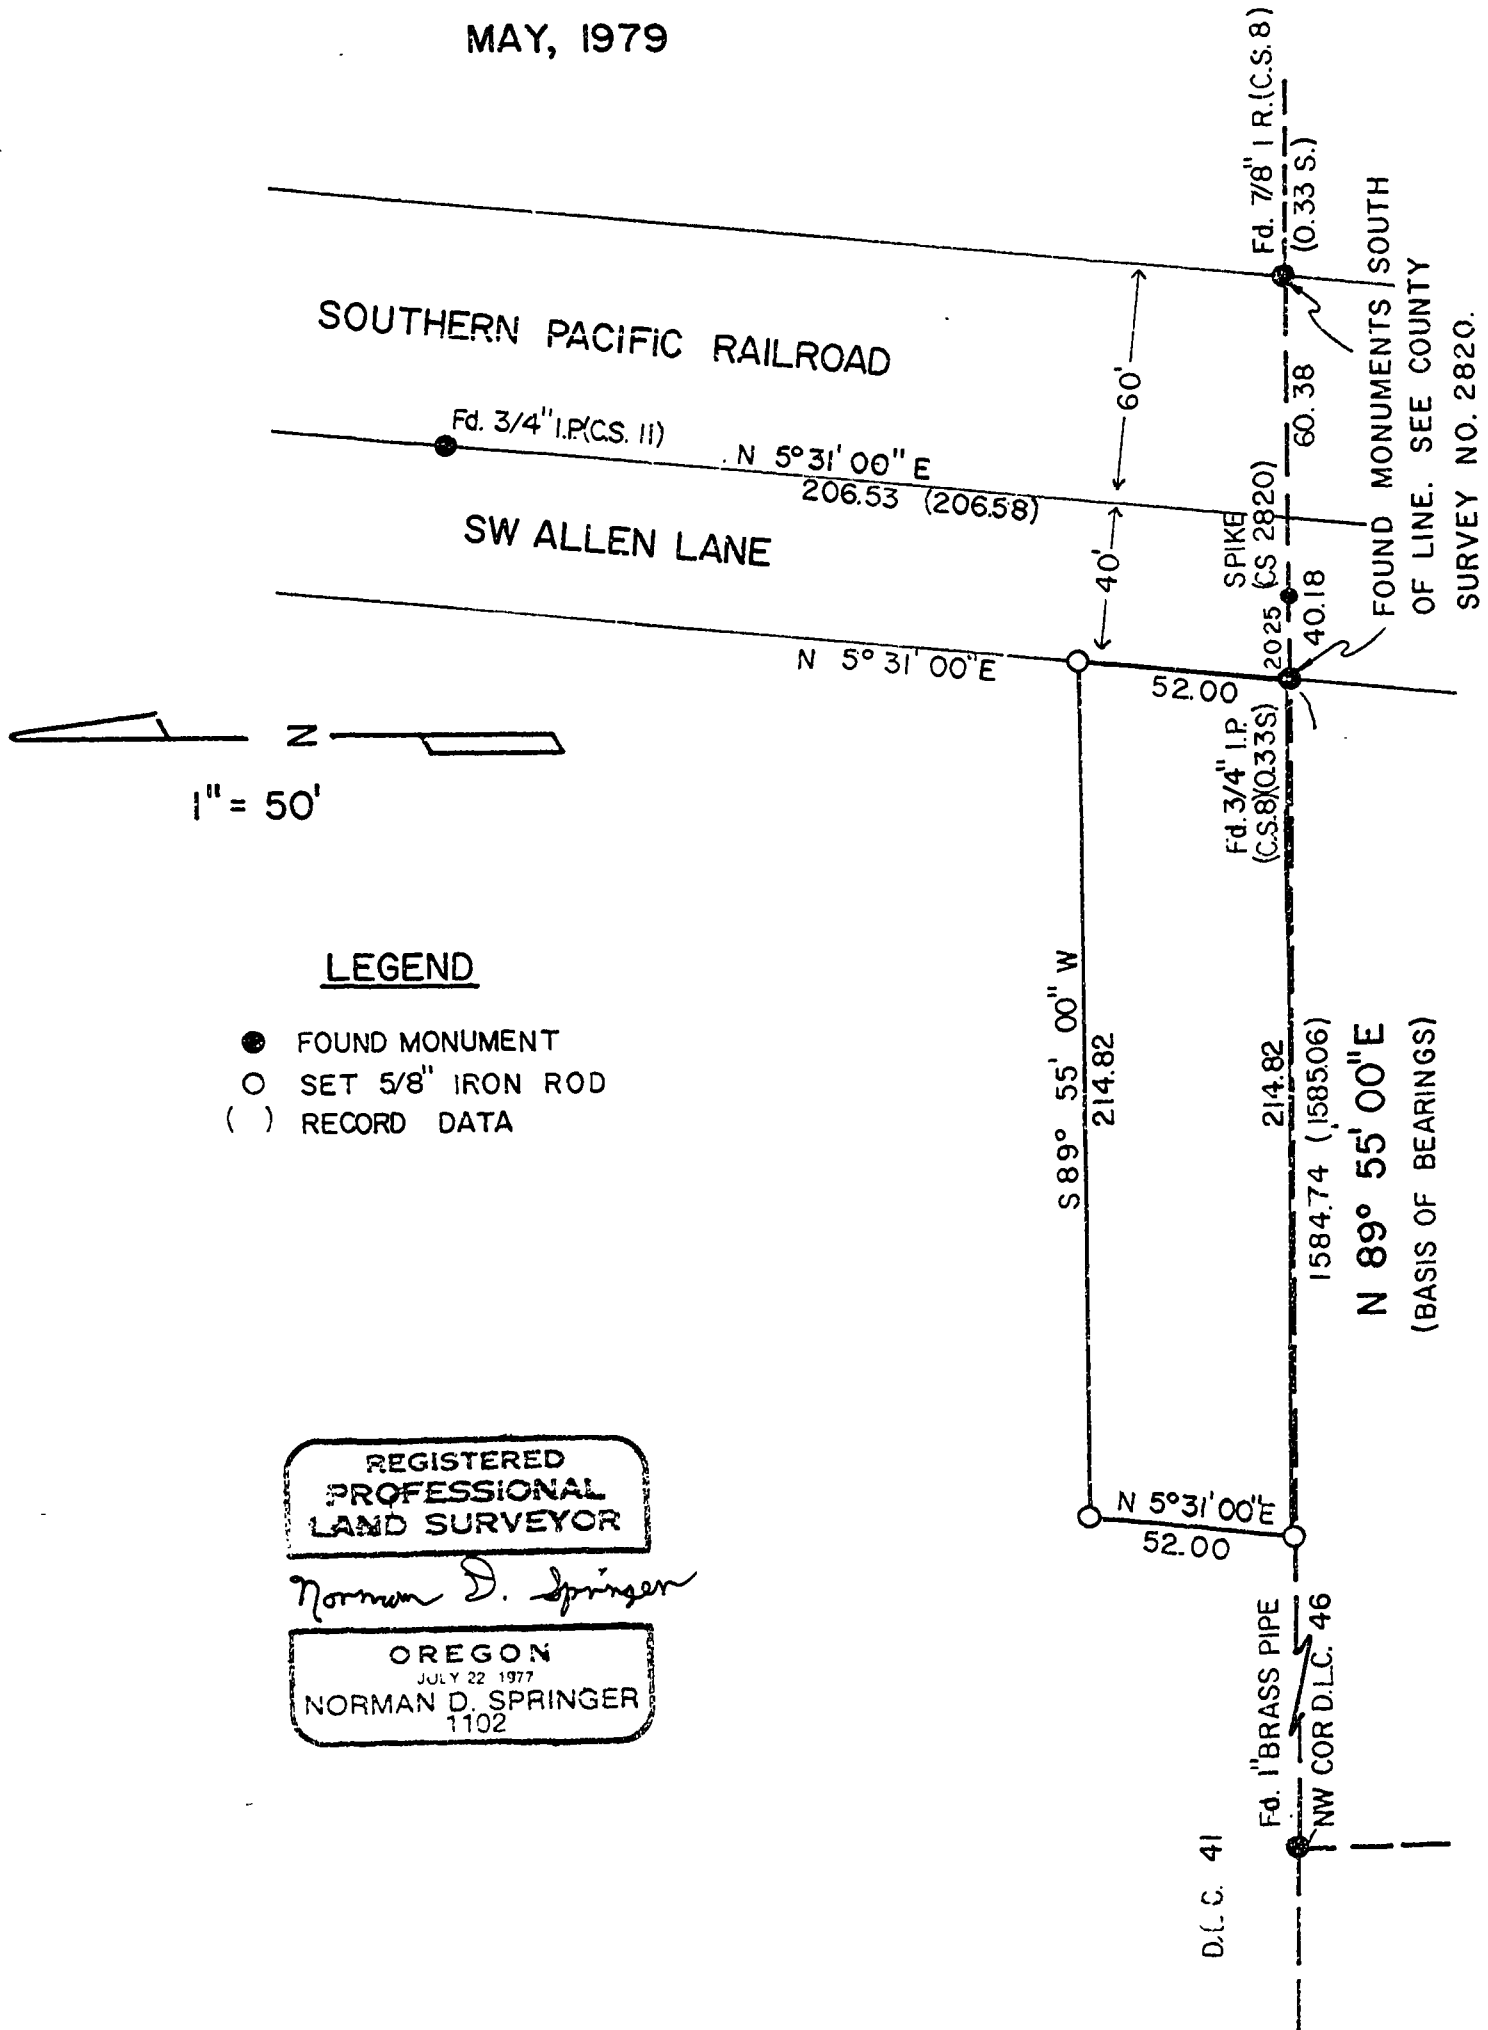

LEGEND

- FOUND MONUMENT
- SET 5/8" IRON ROD
- () RECORD DATA

REGISTERED
PROFESSIONAL
LAND SURVEYOR

Norman D. Springer

OREGON
JULY 22 1977
NORMAN D. SPRINGER
1102