

RECORD OF SURVEY
OF DRAINFIELD LOCATIONS
IN

RAINTREE ESTATES
IN THE N.E. 1/4 SECTION 2, ARNOLD FULLER
D.L.C. NO. 36, TOWNSHIP 11 SOUTH, RANGE
5 WEST, WILLAMETTE MERIDIAN, BENTON
COUNTY OREGON
SCALE: 1" = 100'

APRIL 12, 1979

COUNTY ROAD NO. 15035
N. W. MT. VIEW DRIVE


Benton Co. Surveyors Office
C. S. FILE NO. 6907
FILING DATE 6-7-79
FILE SIZE 18" x 24"

REGISTERED
PROFESSIONAL
LAND SURVEYOR
DARRELL W. HAMMS
1075

LEGEND

8-21-82
S 81 5/8" x 30" Iron Rod

CURVE	BEARING	DELTA	ARC	LONG CHORD
1	S 89° 42' 30" E	202.000	188.461	377.170
2	S 89° 42' 30" E	202.000	188.461	377.170
3	S 89° 42' 30" E	202.000	188.461	377.170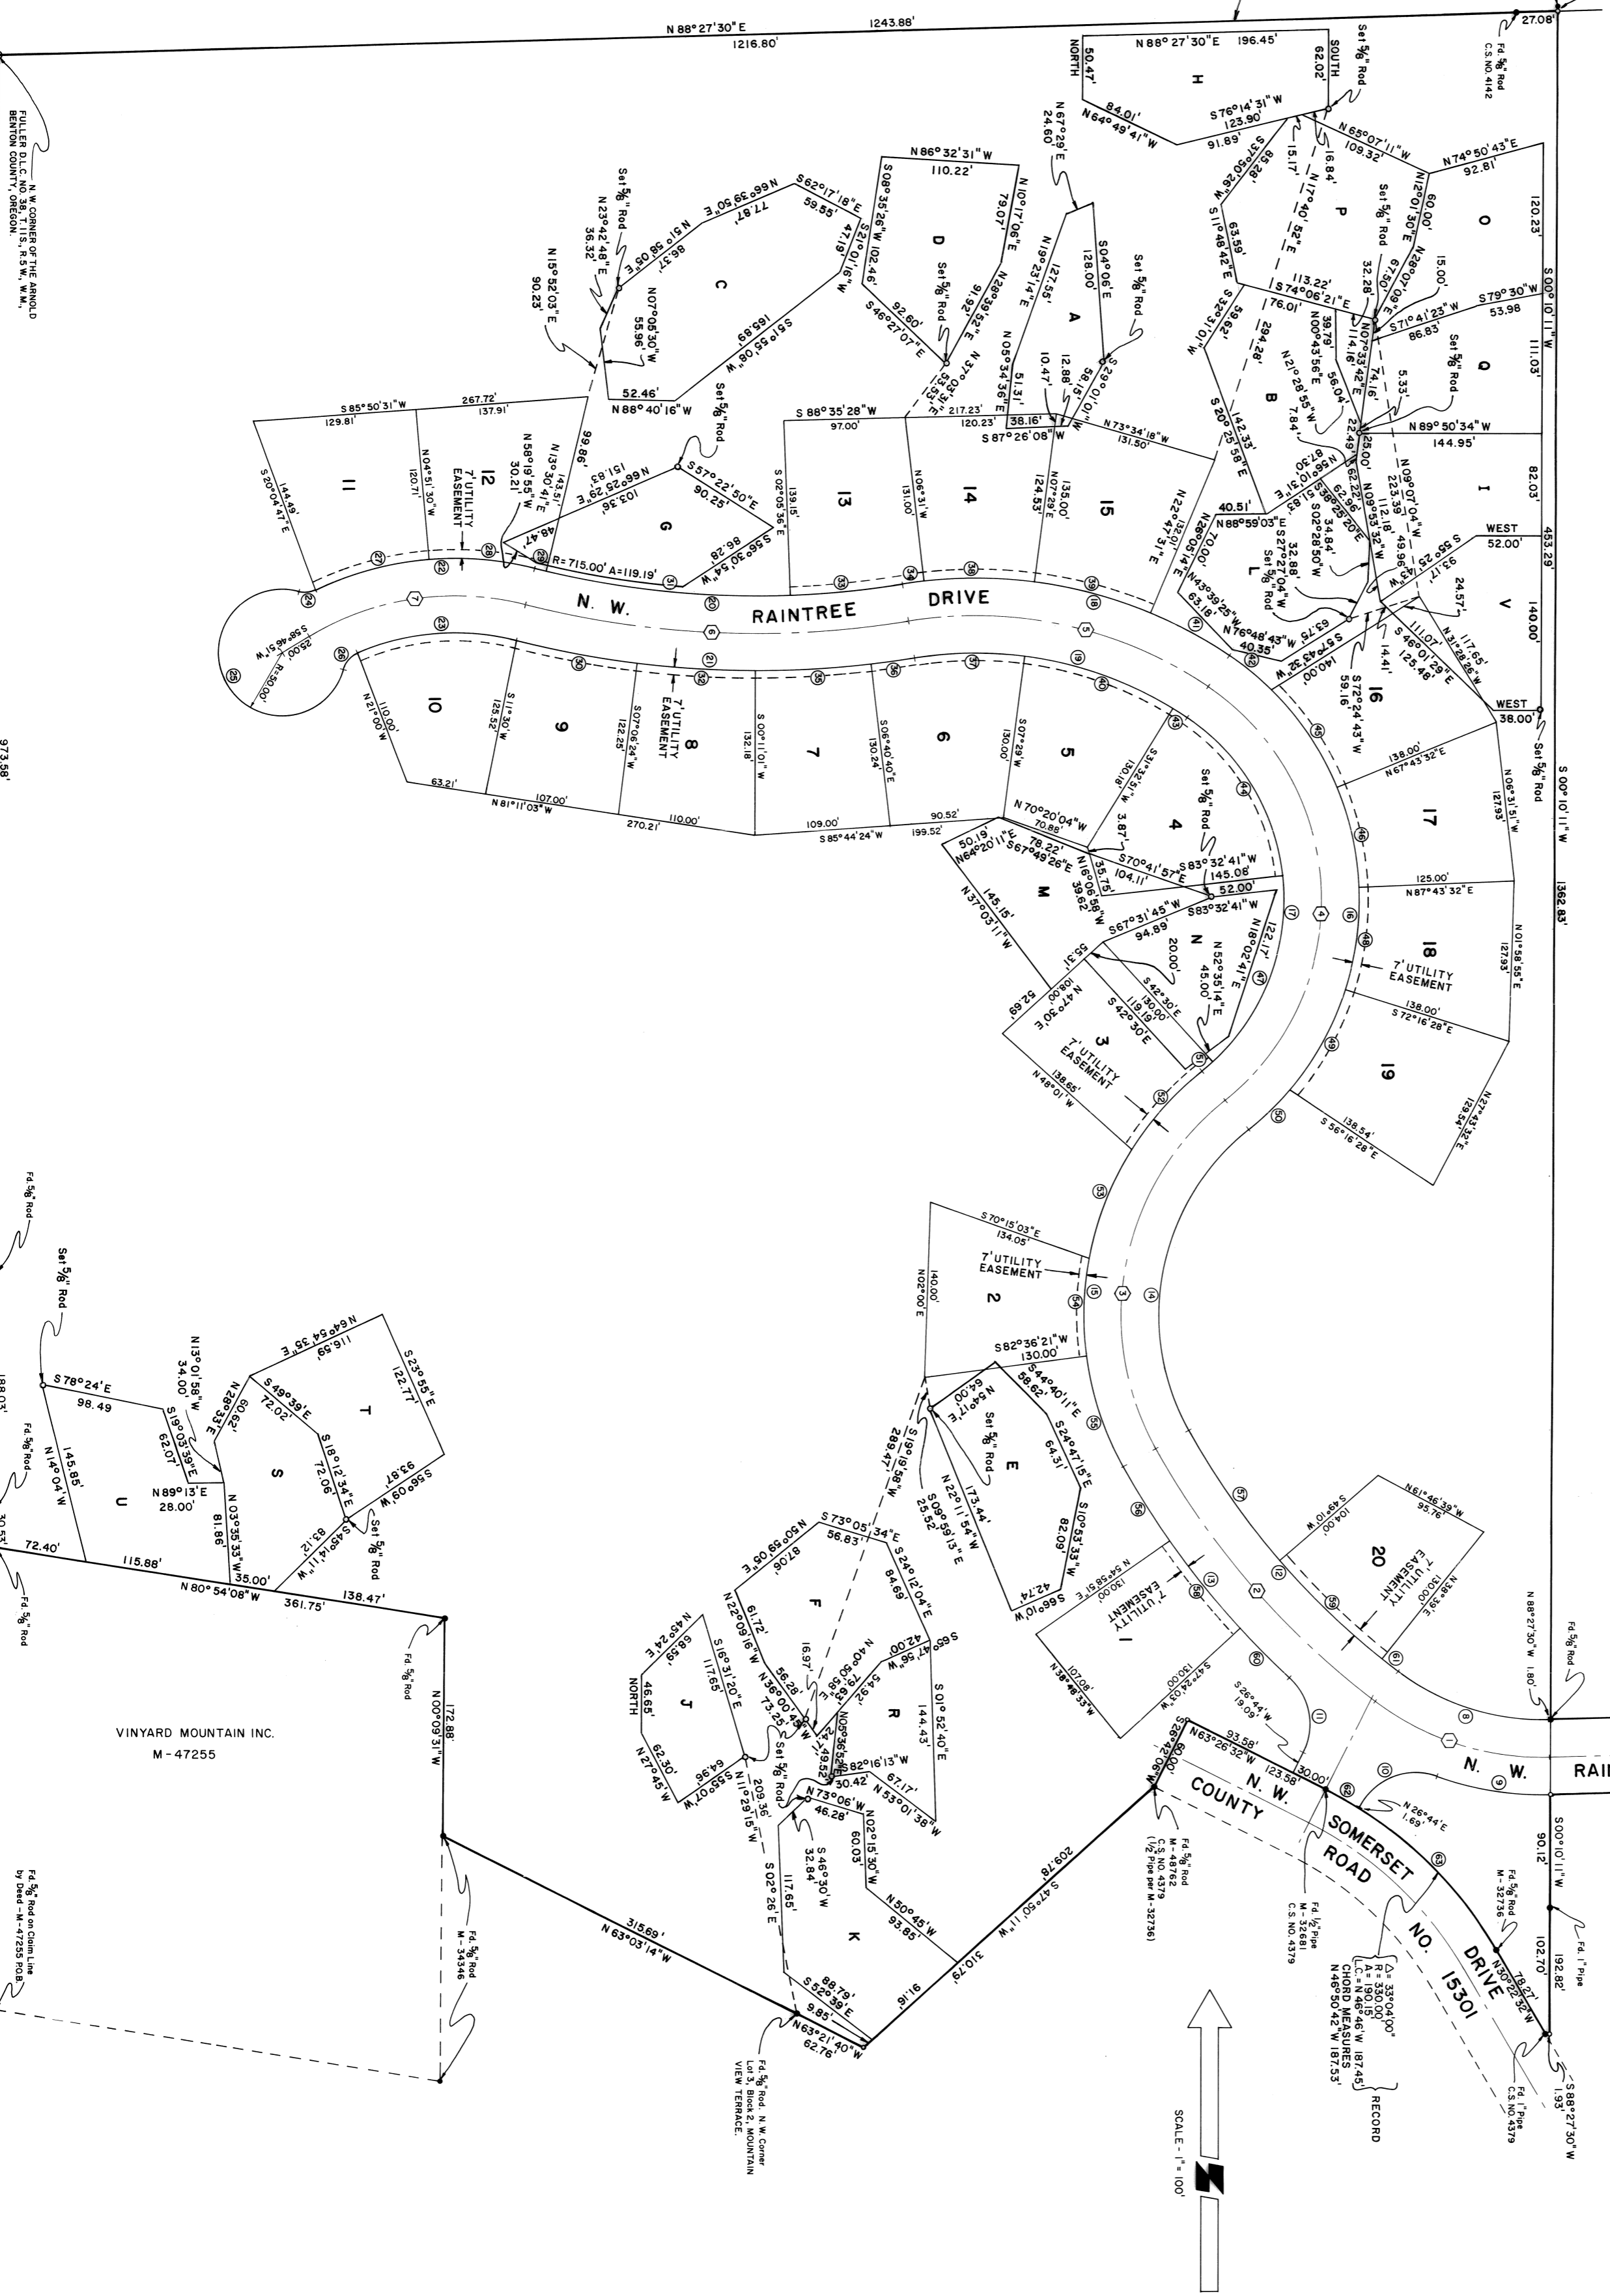
Benton Co. Surveyors Office
C. S. FILE NO. 6907
FILING DATE 6-7-79
FILE SIZE 18" x 24"