


RECORD OF SURVEY  
 for **JEFF UNTERSCHUETZ**  
 in **CRESCENT VALLEY HEIGHTS**  
**N.W. 1/4 SEC. 15, T. 11S., R. 5W., W. M.**  
**BENTON COUNTY, OREGON**  
 JUNE 1979  
 SCALE: 1"=50'

REGISTERED  
 PROFESSIONAL  
 LAND SURVEYOR

*Jack R. Burrell*

OREGON  
 JACK R. BURRELL  
 1630

- LEGEND**
- FOUND 5/8" IRON ROD
  - SET 5/8" IRON ROD
  - ( ) RECORD DATA

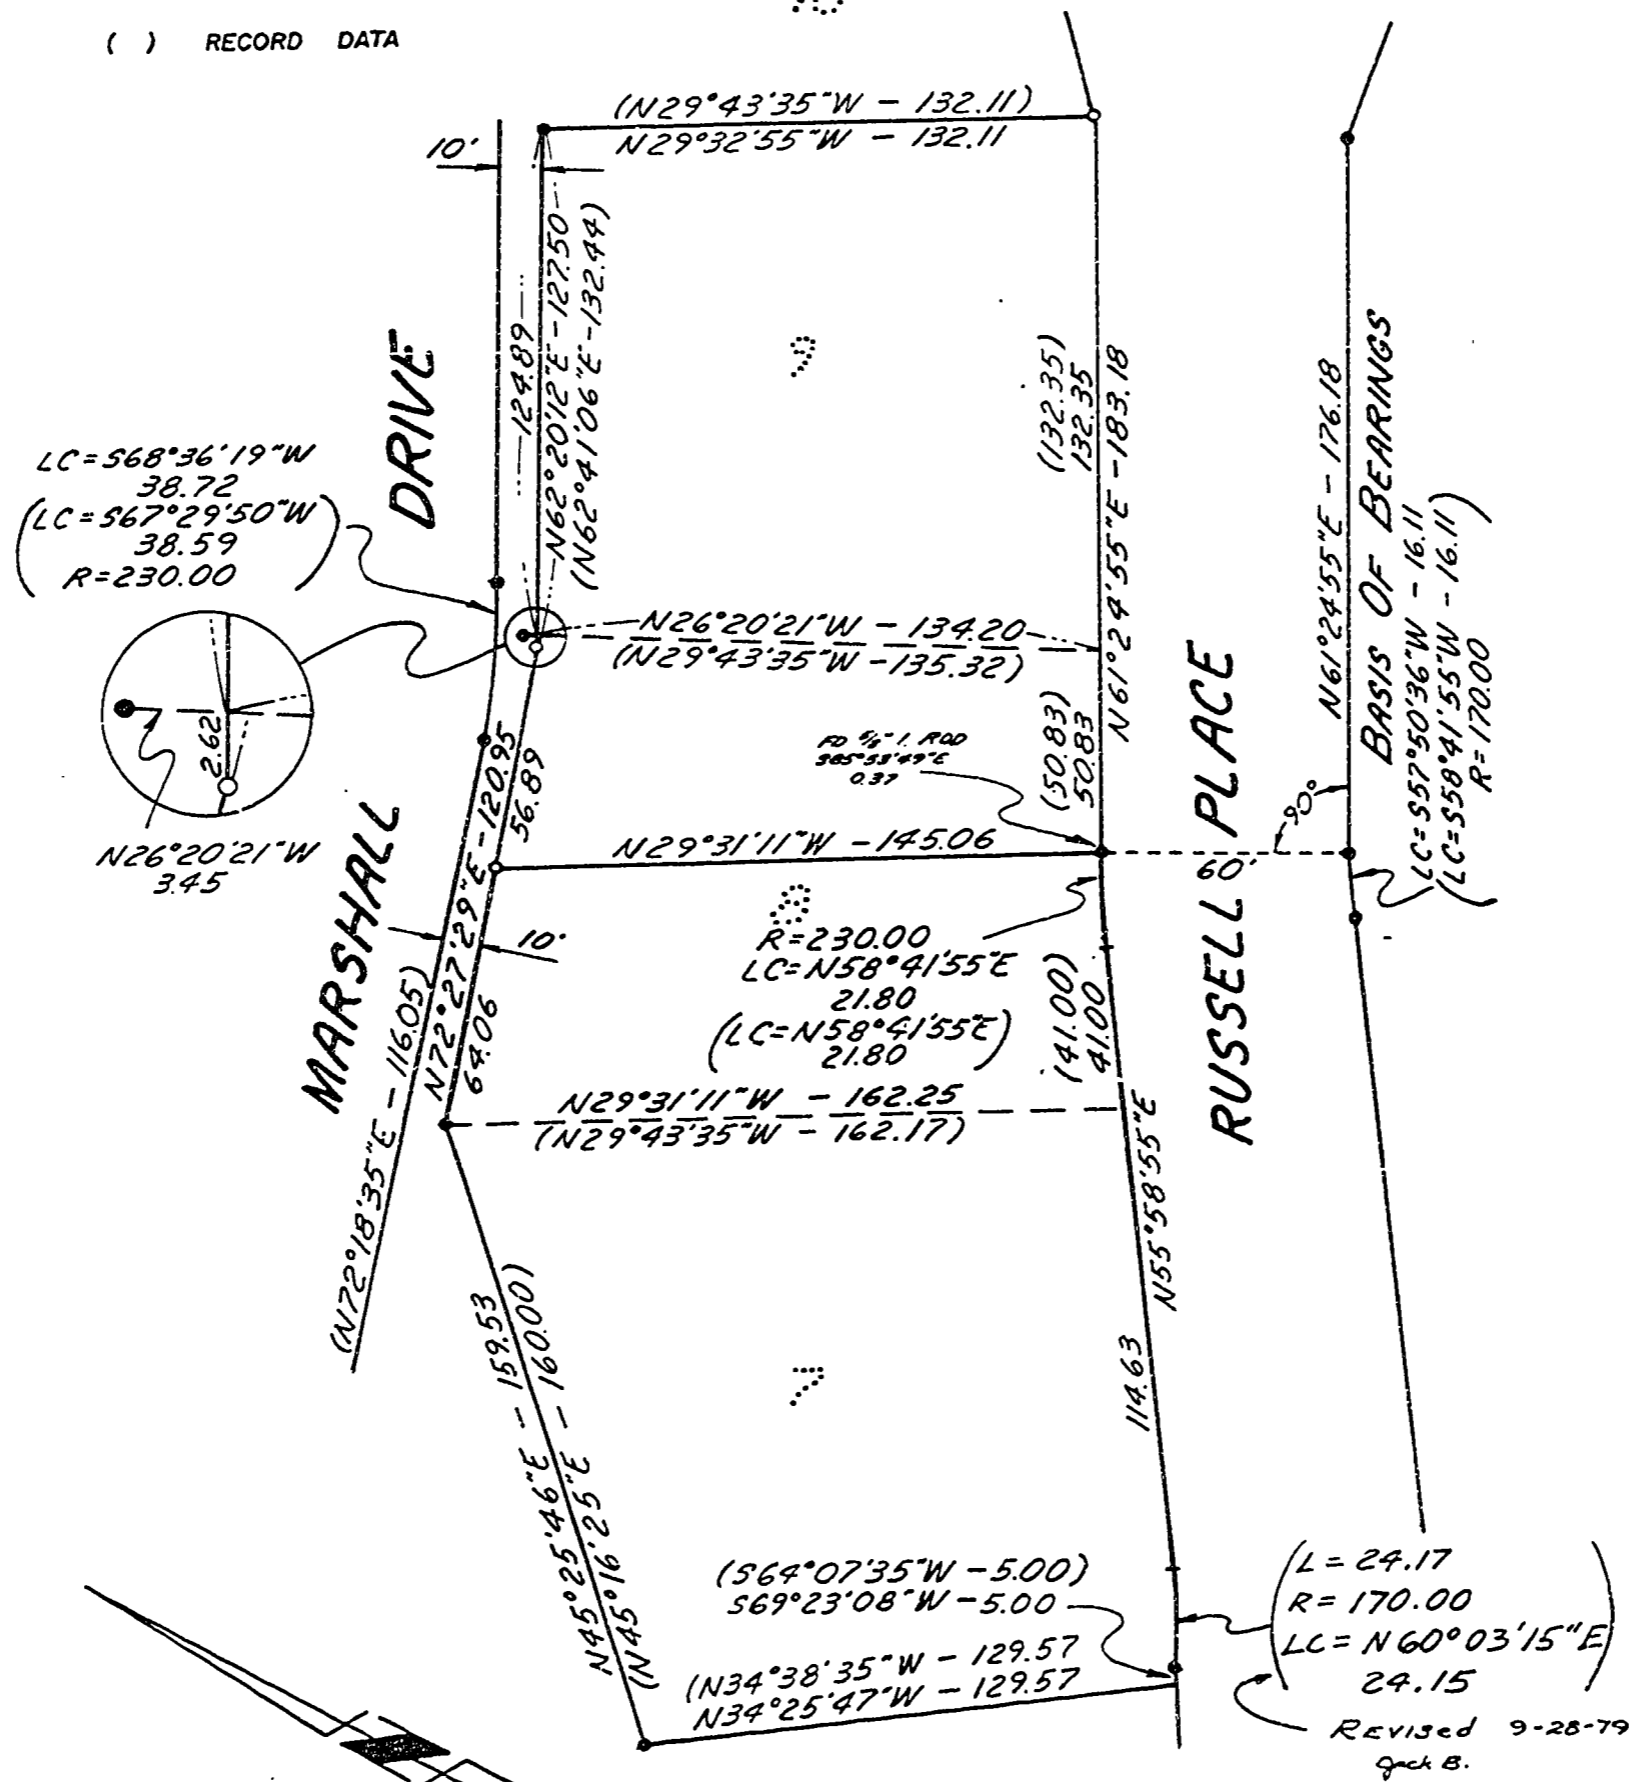

**Benton Co. Surveyors Office**  
 C. S. FILE NO. 6913  
 FILING DATE 6-18-79  
 FILE SIZE 8 1/2" x 14"