


SURVEY FOR T. R. GREGG

LOT 7 PLEASANT VIEW FRUIT FARMS
IN THE GEO. W. BEATHERS D.L.C. NO. 49
SW 1/4 SEC 9, T12S, R5W, WM, BENTON CNTY

JUNE 1, 1979

Benton Co. Surveyors Office
C.S. NO. 6922
FILING DATE 6-22-79
FILE SIZE 11" x 17" di

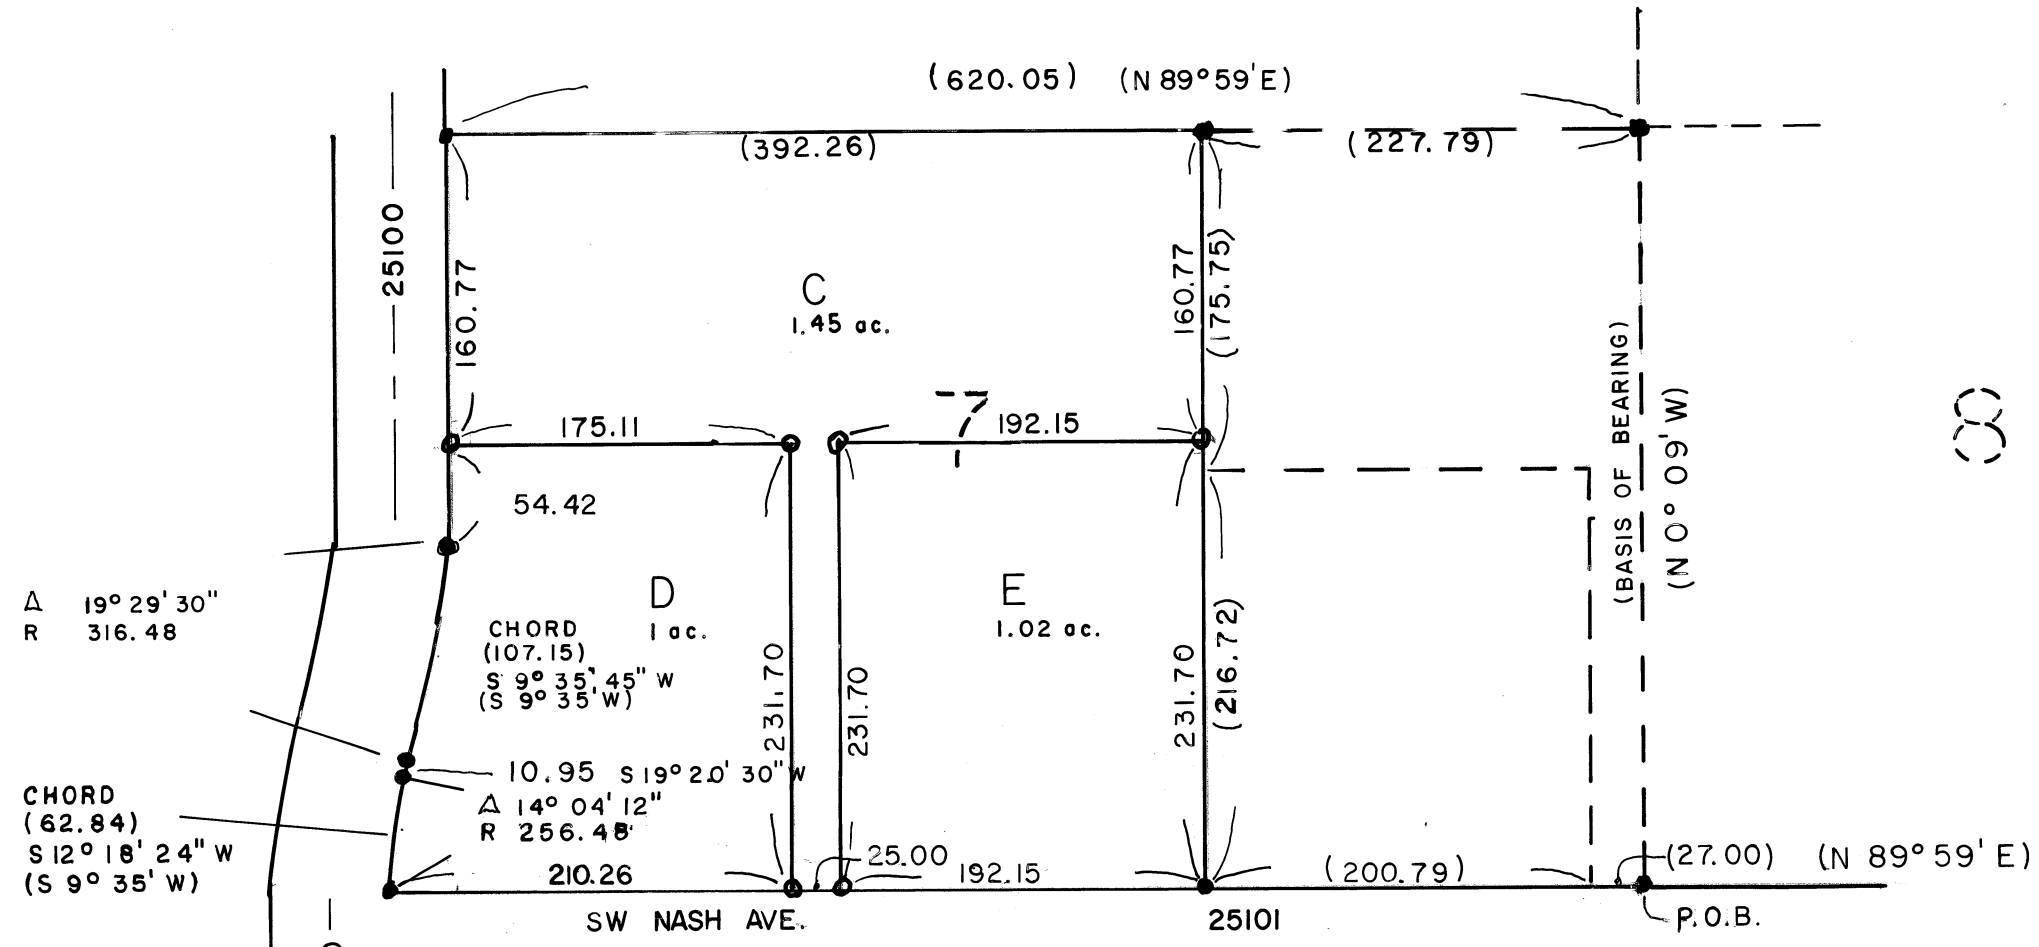

SCALE: 1" = 100'

BASIS OF BEARINGS
CS 4694

- DENOTES 3/4" PIPE SET
- DENOTES " " FOUND

REGISTERED
PROFESSIONAL
LAND SURVEYOR

OREGON
OCTOBER 20, 1967
WILLIAM C. FARLEY
482