


DENIS O'BRIEN

NW 1/4 SW 1/4 Sec. 36, T. 10 S., R. 4 W., W.M.
Benton County, Oregon

Scale: 1" = 100'

July 30, 1979

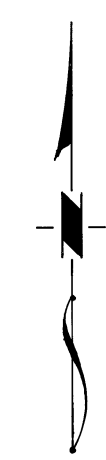

BASED ON BRADEN TRACTS
o Set 5/8" Iron Rod

NOTE: PROPERTY LINES FOR THIS PARCEL WERE ESTABLISHED AFTER A TITLE SEARCH REVEALED IT HAD SENIOR RIGHTS OVER THAT PROPERTY DESCRIBED IN V. 37, P. 293. WE ALSO FOUND AN APPARENT OVERLAP IN THE DEEDS RECORDED IN V. 32, P. 30 AND V. 48, P. 264. THIS WOULD AFFECT THE SOUTH LINE OF V. 32, P. 30 BY 35.64 FT.

Surveyors Office
FILE NO. 6961
FILING DATE 8-28-79
FILE SIZE 14" x 17"

TIMBERLAND SERVICES, INC.
1010 Airport Road P.O. Box 668
Albany Ore. 97321
Ph. (503) 926-9404
SURVEYING - ENGINEERING
LAND USE PLANNING
FORESTRY CONSULTING

REGISTERED
PROFESSIONAL
LAND SURVEYOR
Edgar R Cook
OREGON
JULY 30, 1976
EDGAR R. COOK
1073