


699

Apr. 8-20  
#18


3<sup>RD</sup> ST.

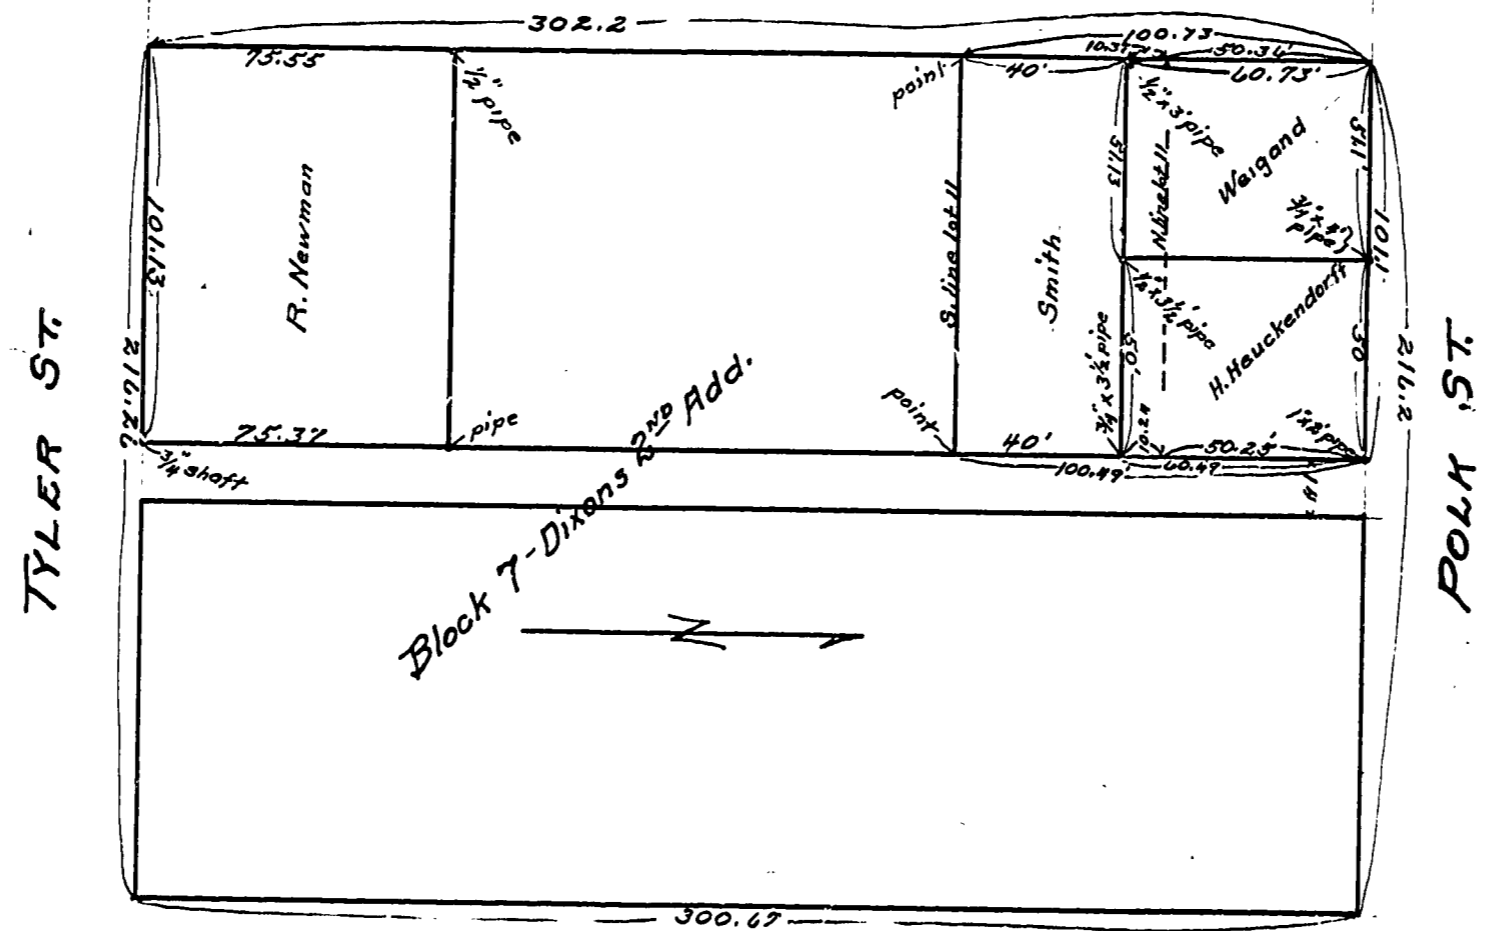

TYLER ST

POLK ST

Block 7 - Dixon's 2<sup>ND</sup> Add.

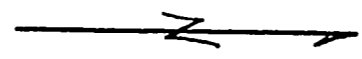

2<sup>ND</sup> ST.