


RECORD OF SURVEY
 for in **DYER LAND DEVELOPMENT, INC.**
 LOT 18, PIONEER VILLAGE II
 N.W. 1/4 SEC. 28, T. 12S., R. 6W. W. M.
 BENTON COUNTY, OREGON
 NOVEMBER 1979
 SCALE: 1"=40'

REGISTERED
 PROFESSIONAL
 LAND SURVEYOR

Jack R. Burrell

OREGON
 JACK R. BURRELL
 1630

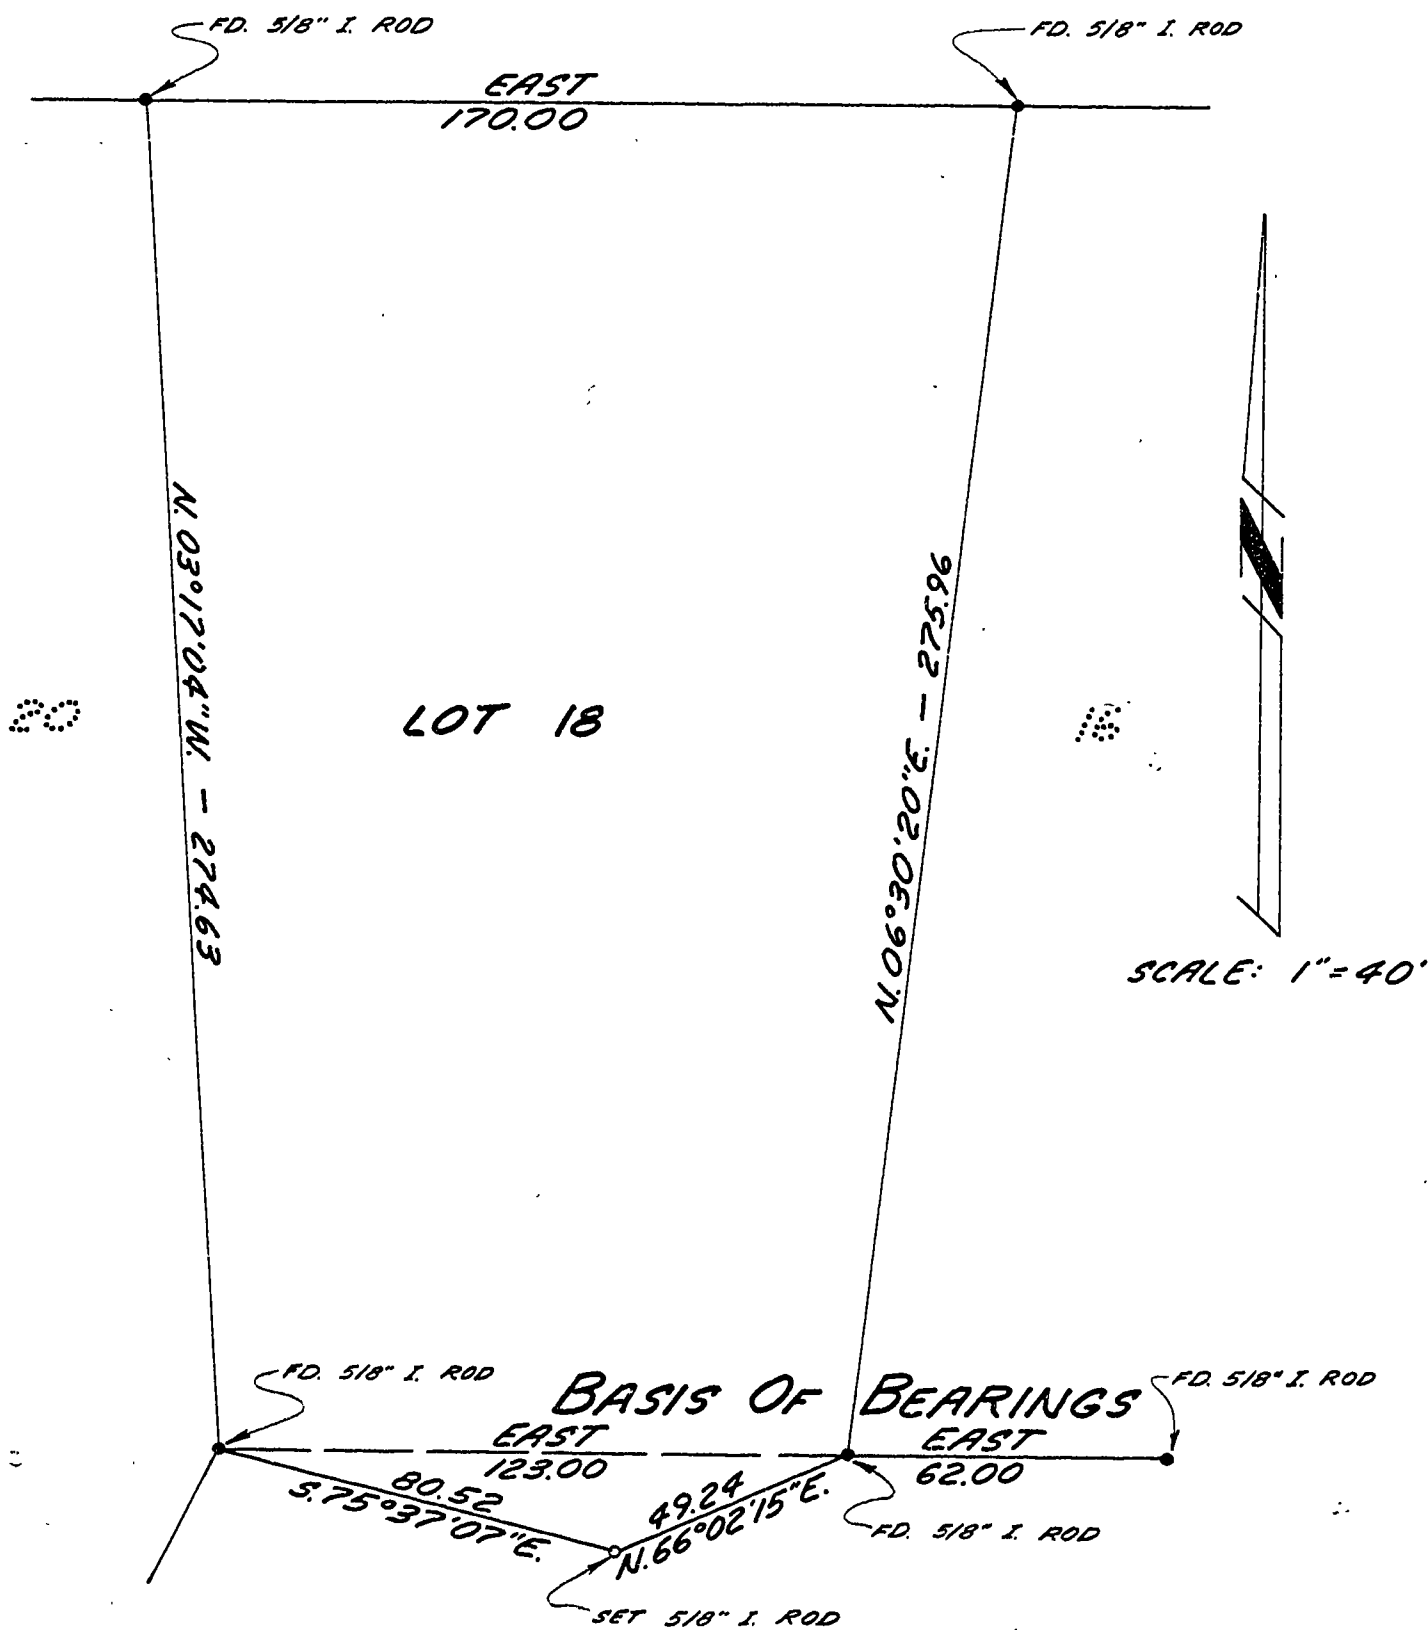

SCALE: 1"=40'

COMMON AREA TRACT "B"

Benton Co. Surveyors Office
 C. S. FILE NO. 7003
 FILING DATE 11-26-79
 FILE SIZE 8 1/2" x 14"
 ATTACHED NARRATIVE du

DRN. T.R.P.