


Benton County  
Surveyor's Office

C. S. FILE NO. 7048  
FILING DATE 3-6-80  
FILE SIZE 18" x 24"

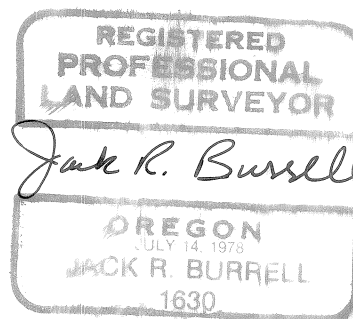

### RECORD OF SURVEY

FOR MCKENZIE HOMES

LOCATED IN THE NW 1/4 OF SEC. 11  
T. 12S, R. 5W, WM;  
JOSEPH C. ALEXANDER DONATION  
LAND CLAIM No. 46;

BENTON COUNTY, CORVALLIS, OREGON

DATE MARCH 1980

Scale  
1"=30'

#### LEGEND

- FOUND MONUMENT AS NOTED
- SET MONUMENT
- FENCE
- ( ) RECORD DATA

#### NARRATIVE:

MONUMENTS ARE SHOWN THAT WERE USED TO ESTABLISH THE RIGHT-OF-WAY LINES OF TUNISON STREET AND HIGHWAY 99 W. THESE RIGHT-OF-WAY LINES ESTABLISH THE NORTH AND EAST PROPERTY LINE OF LOT. THE MONUMENTS ON THE SOUTH LINE ARE UNRECORDED. BECAUSE A FENCE HAS BEEN ESTABLISHED BY THESE MONUMENTS AND ALSO BECAUSE THEY AGREE SO WELL WITH RECORD DATA, I HAVE HELD THESE MONUMENTS FOR LINE. THE SOUTHEAST CORNER WAS SET AT THE INTERSECTION OF R-O-W LINE OF 99 W AND SAID SOUTH LOT LINE. THE SOUTHWEST LOT CORNER WAS ESTABLISHED BY HOLDING THE FOUND MONUMENT TO SOUTH (AXLE) AND EXTENDING THE LINE NORTHERLY AND PARALLEL WITH THE R-O-W LINE OF HIGHWAY 99.

