


C.S. FILE NO. 7063
 FILING DATE 4-7-80
 FILE SIZE 14" x 17" di

7063

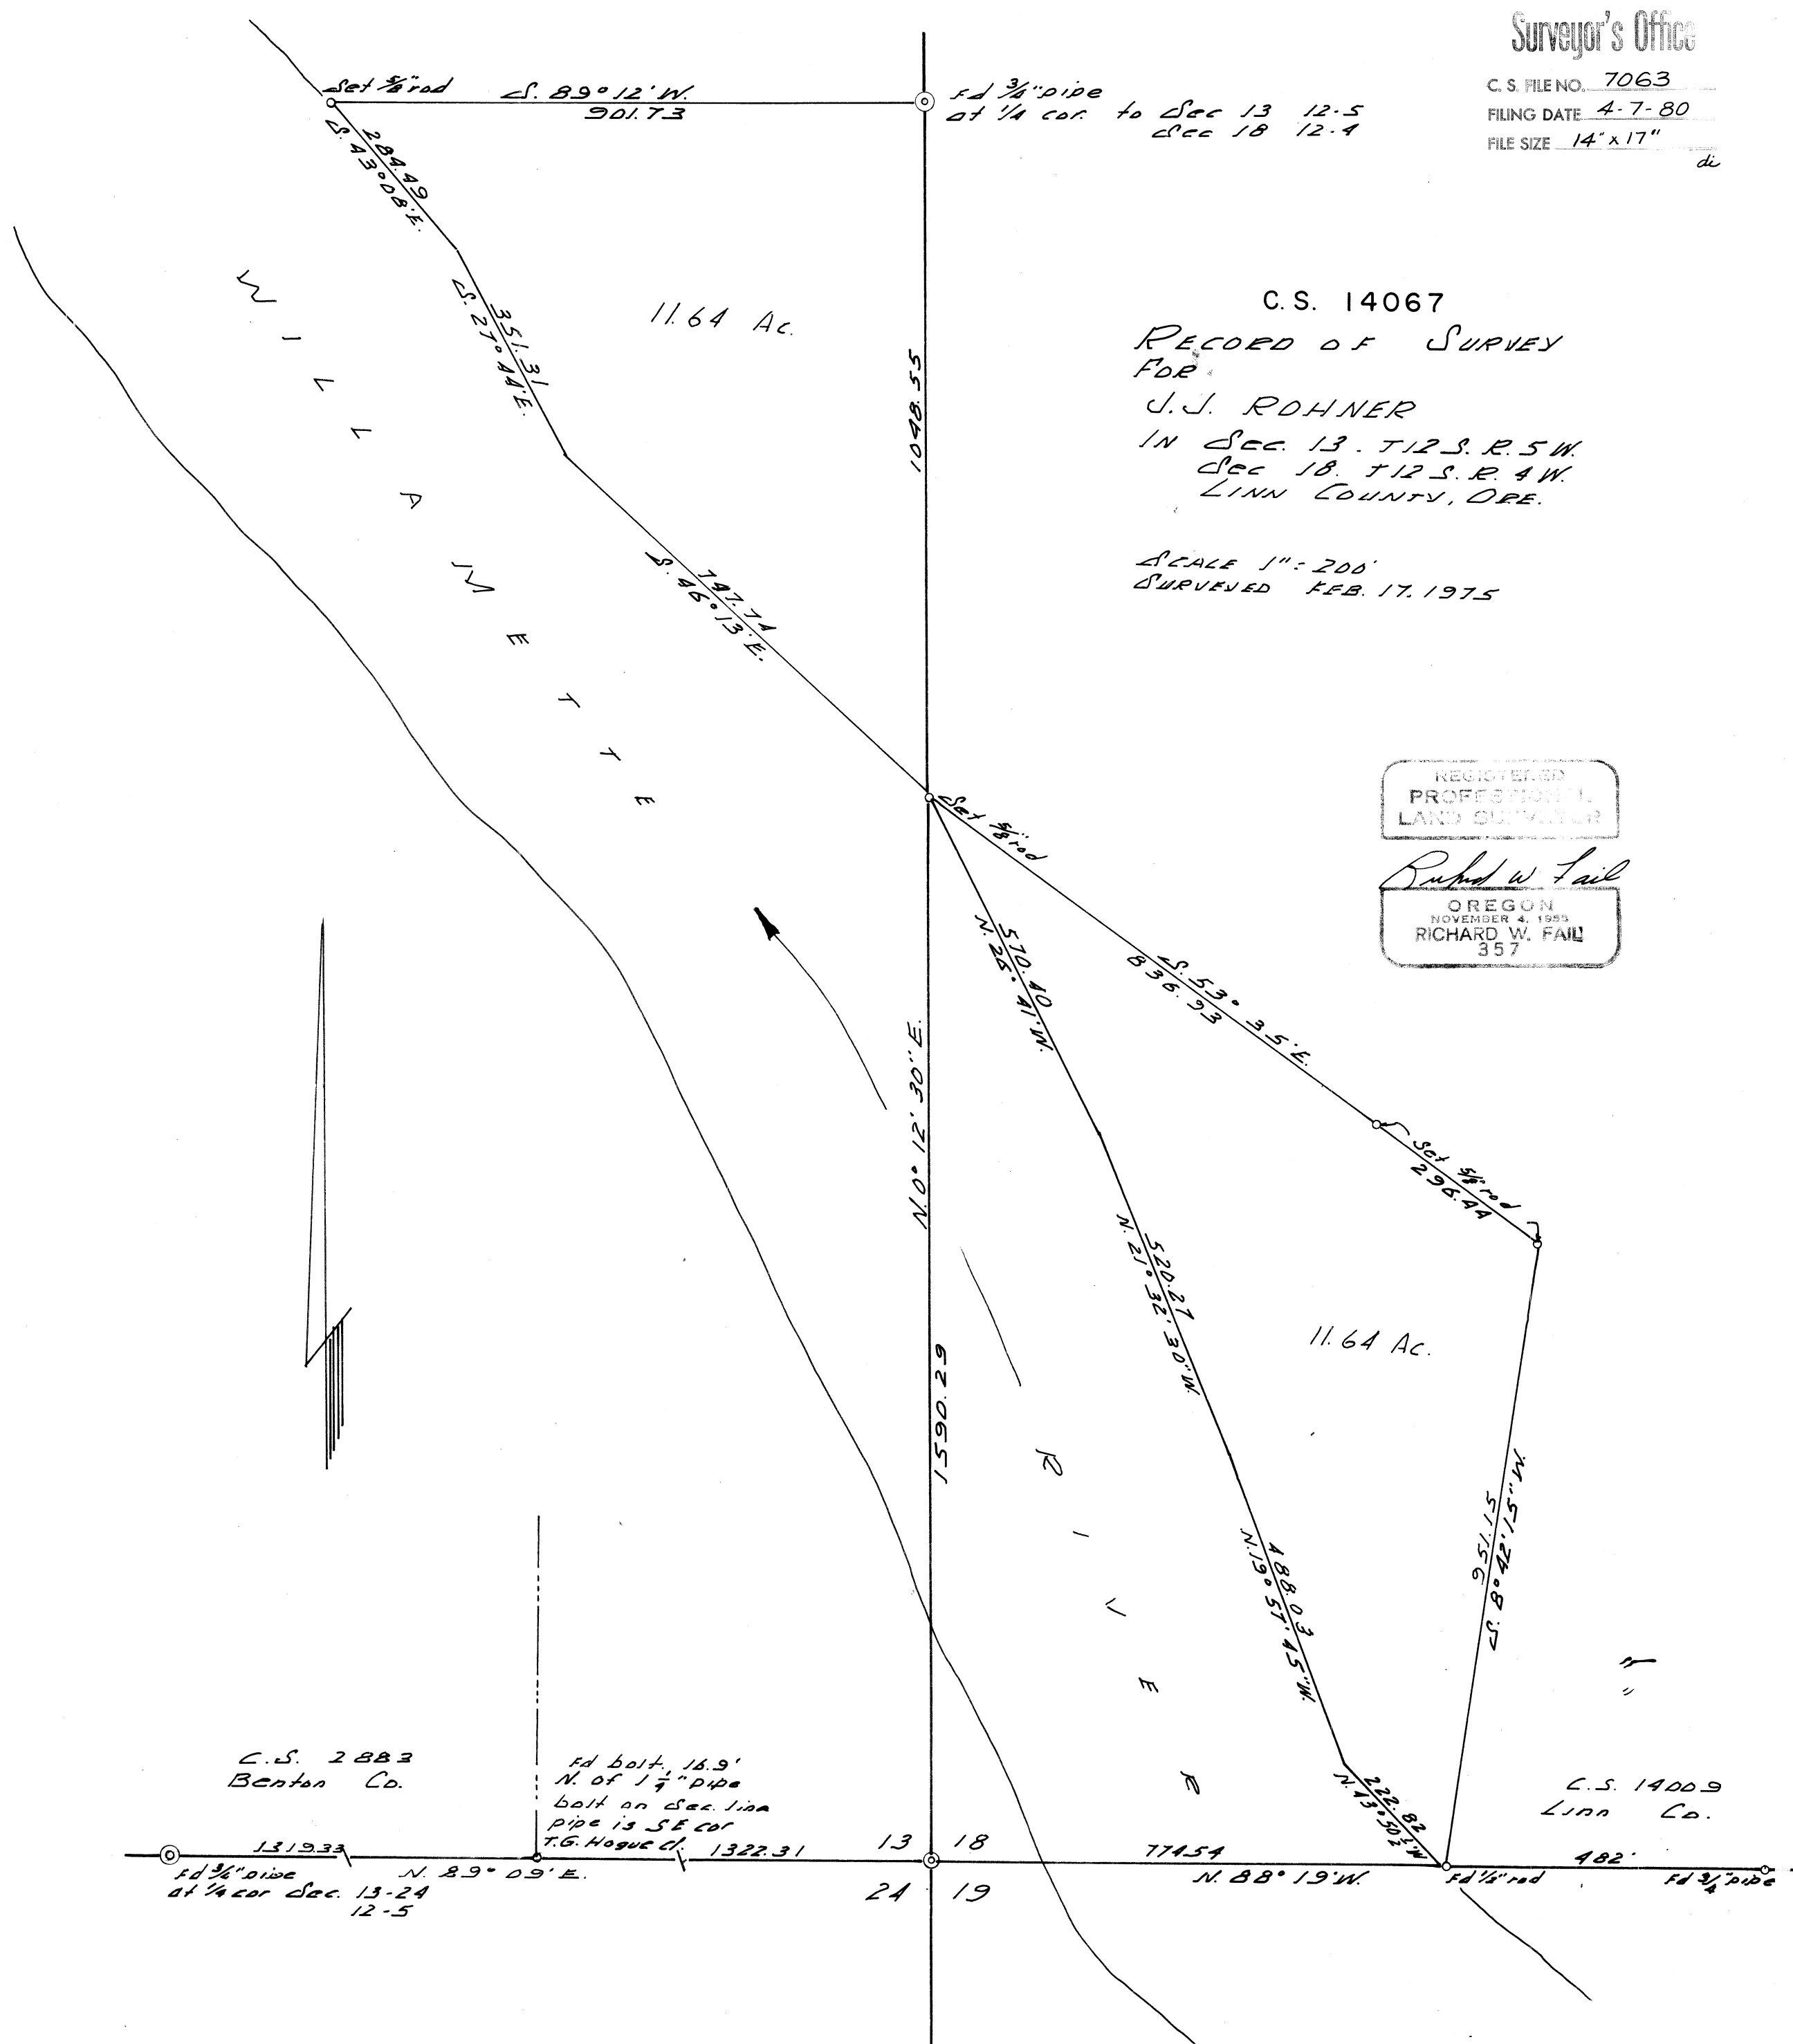

C.S. 14067
 RECORD OF SURVEY
 FOR
 J. J. ROHNER
 IN SEC. 13, T12S, R. 5W.
 SEC. 18, T12S, R. 4W.
 LINN COUNTY, ORE.
 SCALE 1" = 200'
 SURVEYED FEB. 17, 1975

REGISTERED
 PROFESSIONAL
 LAND SURVEYOR
 Richard W. Fall
 OREGON
 NOVEMBER 4, 1955
 RICHARD W. FALL
 357

C.S. 2883
 Benton Co.

fd bolt, 16.9'
 N. of 1 1/4" pipe
 bolt on sec. line
 pipe is SE cor
 T.G. Hogue d.

C.S. 14009
 Linn Co.

2-21-75
 IN LINN Co.

7063

7063

7063