


HOBIN LUMBER CO.
 SE 1/4, NE 1/4, SEC. 18, T. 14S., R. 7W., W.M.
 BENTON COUNTY, OREGON
 SCALE 1" = 300'
 SURVEYOR - BERT W. UDELL
 PARTY CHIEF - DICK FOUTS
 SEPT 30, 1980

REGISTERED
 PROFESSIONAL
 LAND SURVEYOR
Bert W. Udell
 EXPIRES
 OCTOBER 31, 1987
 BERT W. UDELL
 1365

BERT W. UDELL
 32308 Berlin Road
 Lebanon, OR 97355

REFERENCE SURVEYS:
 C.S. # 5216, 2574
 6947,

● CORNERS FOUND
 ○ CORNERS SET

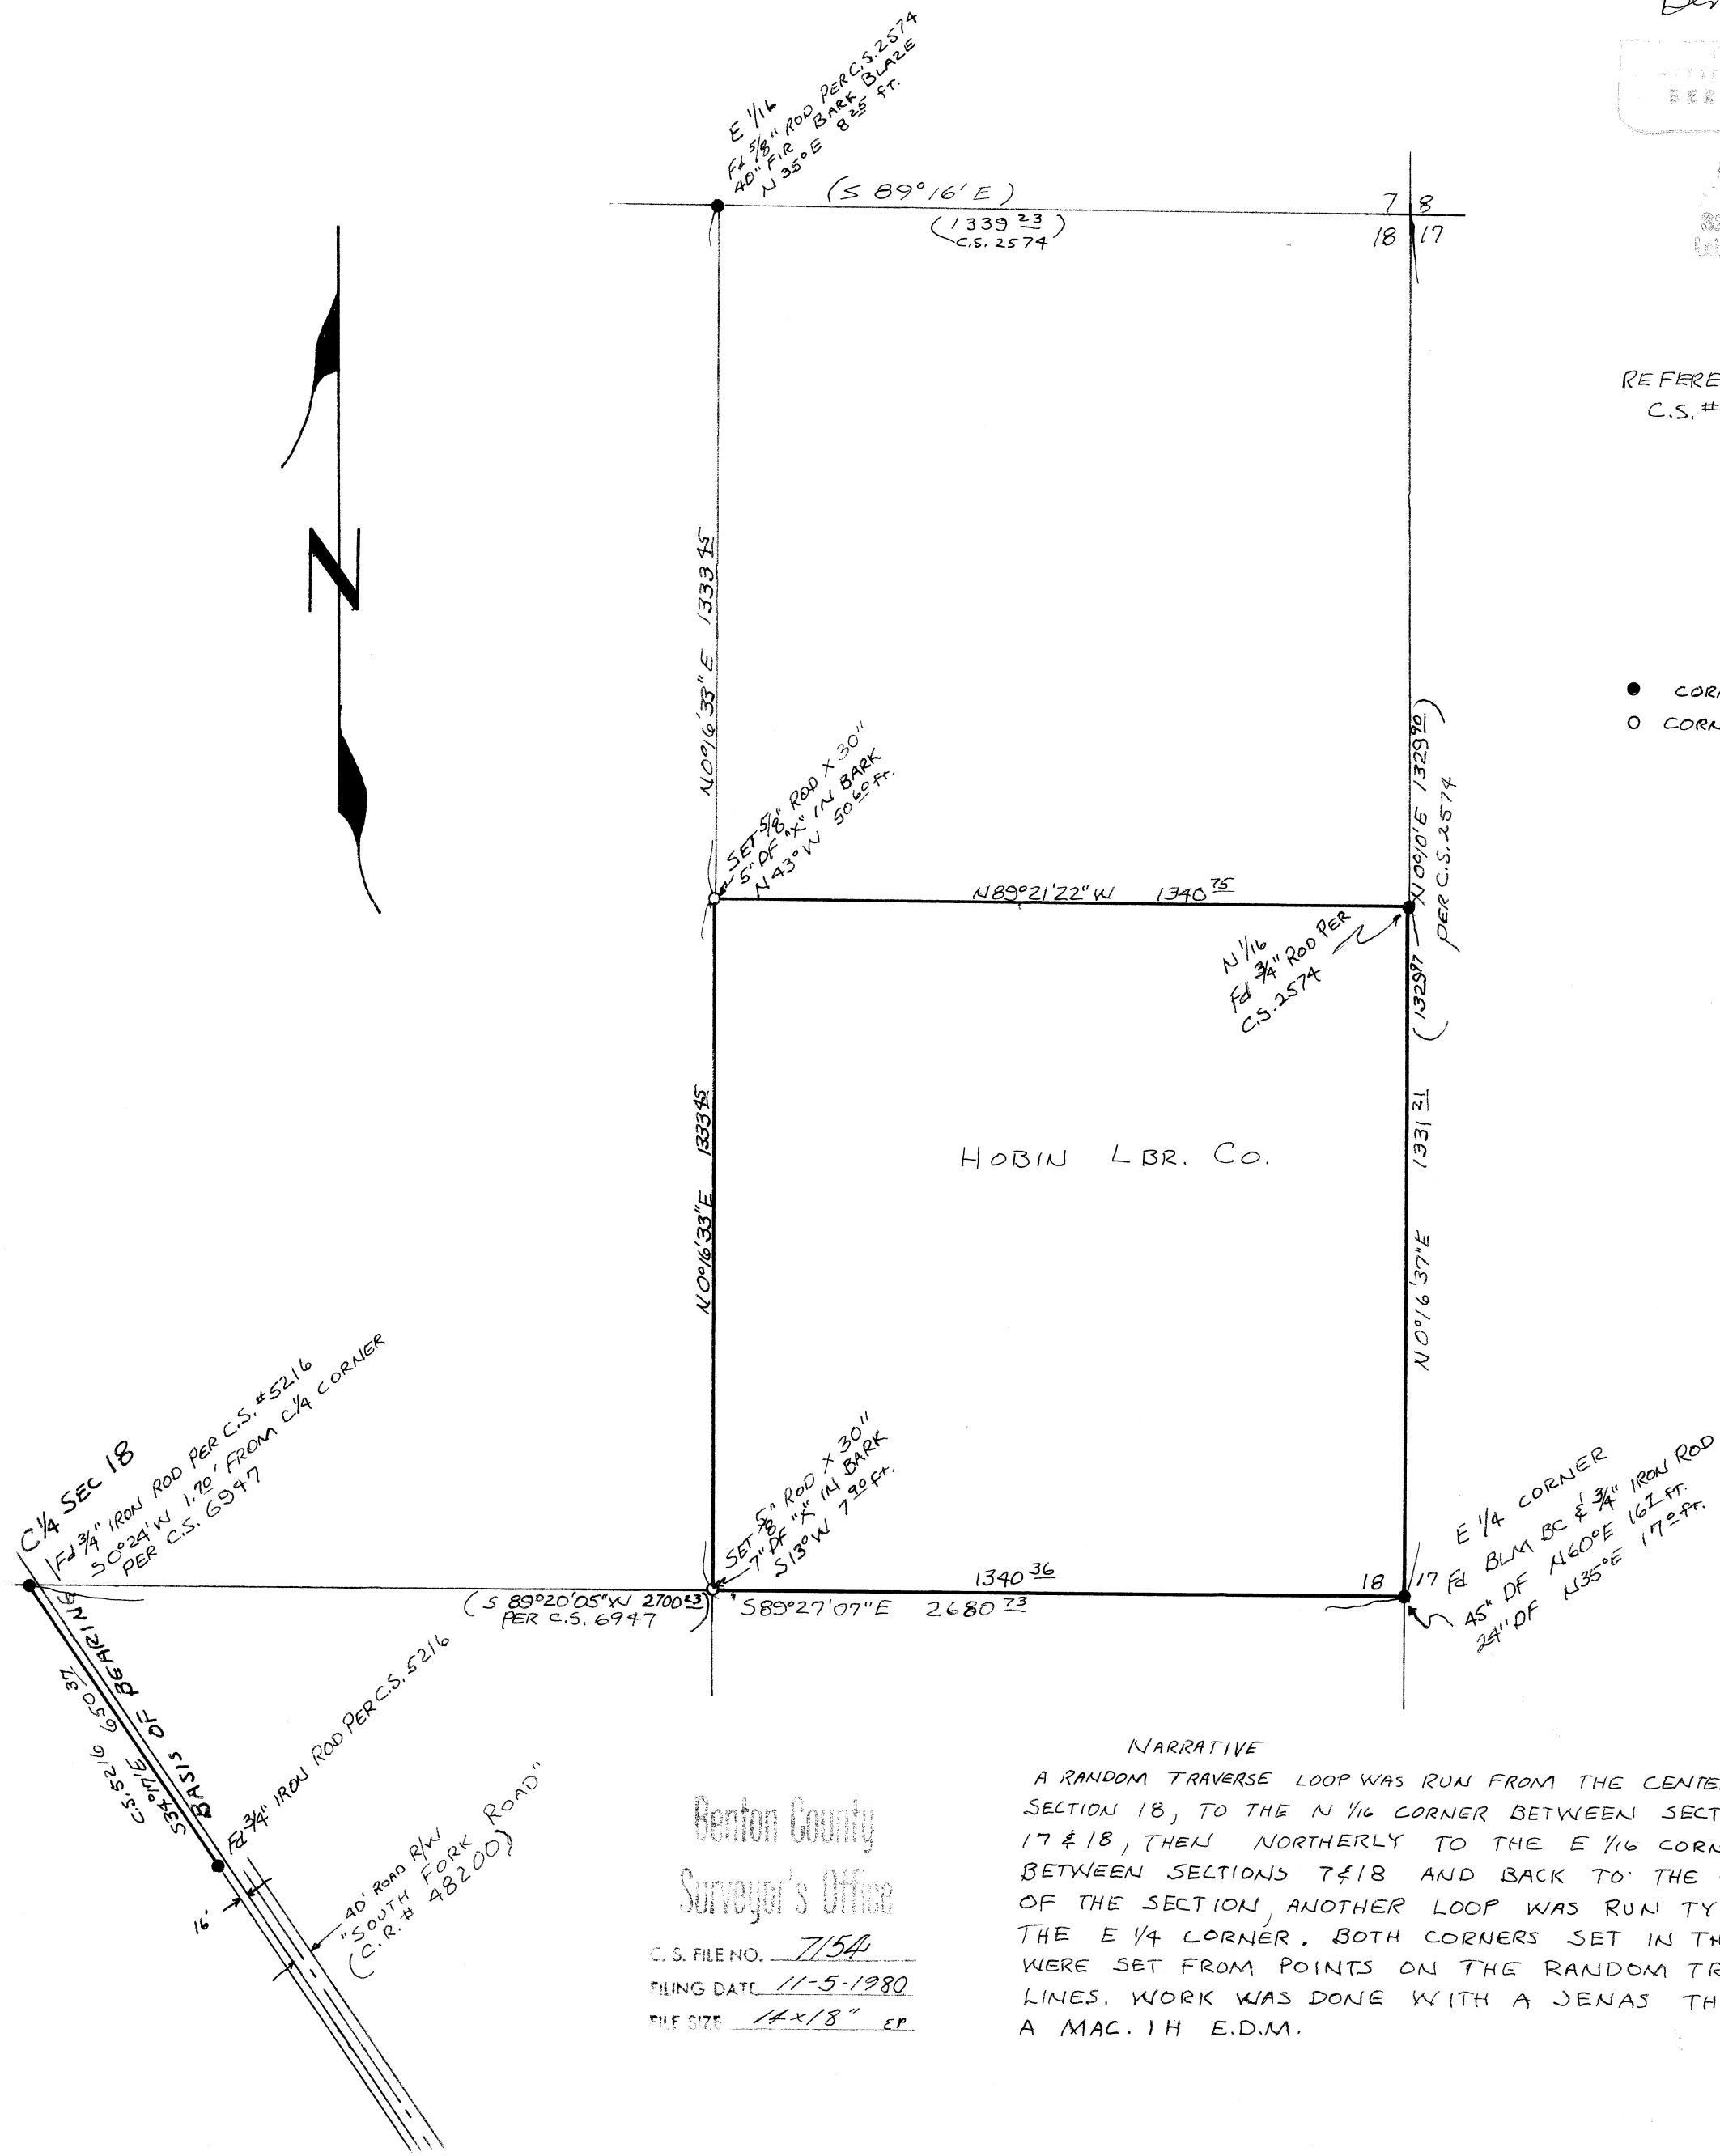

HOBIN LBR. CO.

Benton County
 Surveyor's Office

C.S. FILE NO. 7154
 FILING DATE 11-5-1980
 FILE SIZE 14x18" EP

NARRATIVE
 A RANDOM TRAVERSE LOOP WAS RUN FROM THE CENTER OF SECTION 18, TO THE N 1/16 CORNER BETWEEN SECTIONS 17 & 18, THEN NORTHERLY TO THE E 1/16 CORNER BETWEEN SECTIONS 7 & 18 AND BACK TO THE CENTER OF THE SECTION, ANOTHER LOOP WAS RUN TYING IN THE E 1/4 CORNER. BOTH CORNERS SET IN THIS SURVEY WERE SET FROM POINTS ON THE RANDOM TRAVERSE LINES. WORK WAS DONE WITH A JENAS THEO. AND A MAC. I H E.D.M.