

BARKER SURVEYING CO.

4145 SILVERTON ROAD N.E. • SALEM, OREGON 97303
PHONE 581-7833

PRINCIPALS

Clarence E. Barker, P.L.S.

Glen A. Richardson, P.L.S.

Record of Survey for Fox - Kittleson

October 27, 1980

Narrative

The Survey is located in the Northwest $\frac{1}{4}$ of the Northeast $\frac{1}{4}$ of Section 10, Township 11 South, Range 5 West of the Willamette Meridian in Benton County, Oregon.


Our Basis of Bearing was taken from the West line of the Northeast $\frac{1}{4}$ of Section 10 as shown in C. S. 167.

We ran a closed traverse beginning at a wagon skein marking the Northwest Corner of the Oscar Clark Donation Land Claim No. 42 and running North to the Southwest Corner of C. S. 06525 and thence East to the Southeast Corner of C. S. 06525, thence South along the West line of C.S. 4147 to Sulphur Springs Road, thence Westerly along said Roadway, thence Southwesterly to the point of beginning.

The new monuments were set by radial stakeout from the closed traverse.

All distances and angles were measured with a Hewlett-Packard 3810-A.

FILE SIZE	-----
FLING DATE	11-10-1980
C. S. FILE NO.	7160
Benton Co. Surveyors Office	

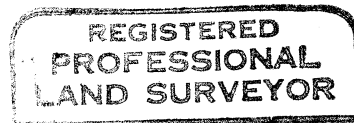

Clarence E. Barker

