


7555

7555

C.S. 7555

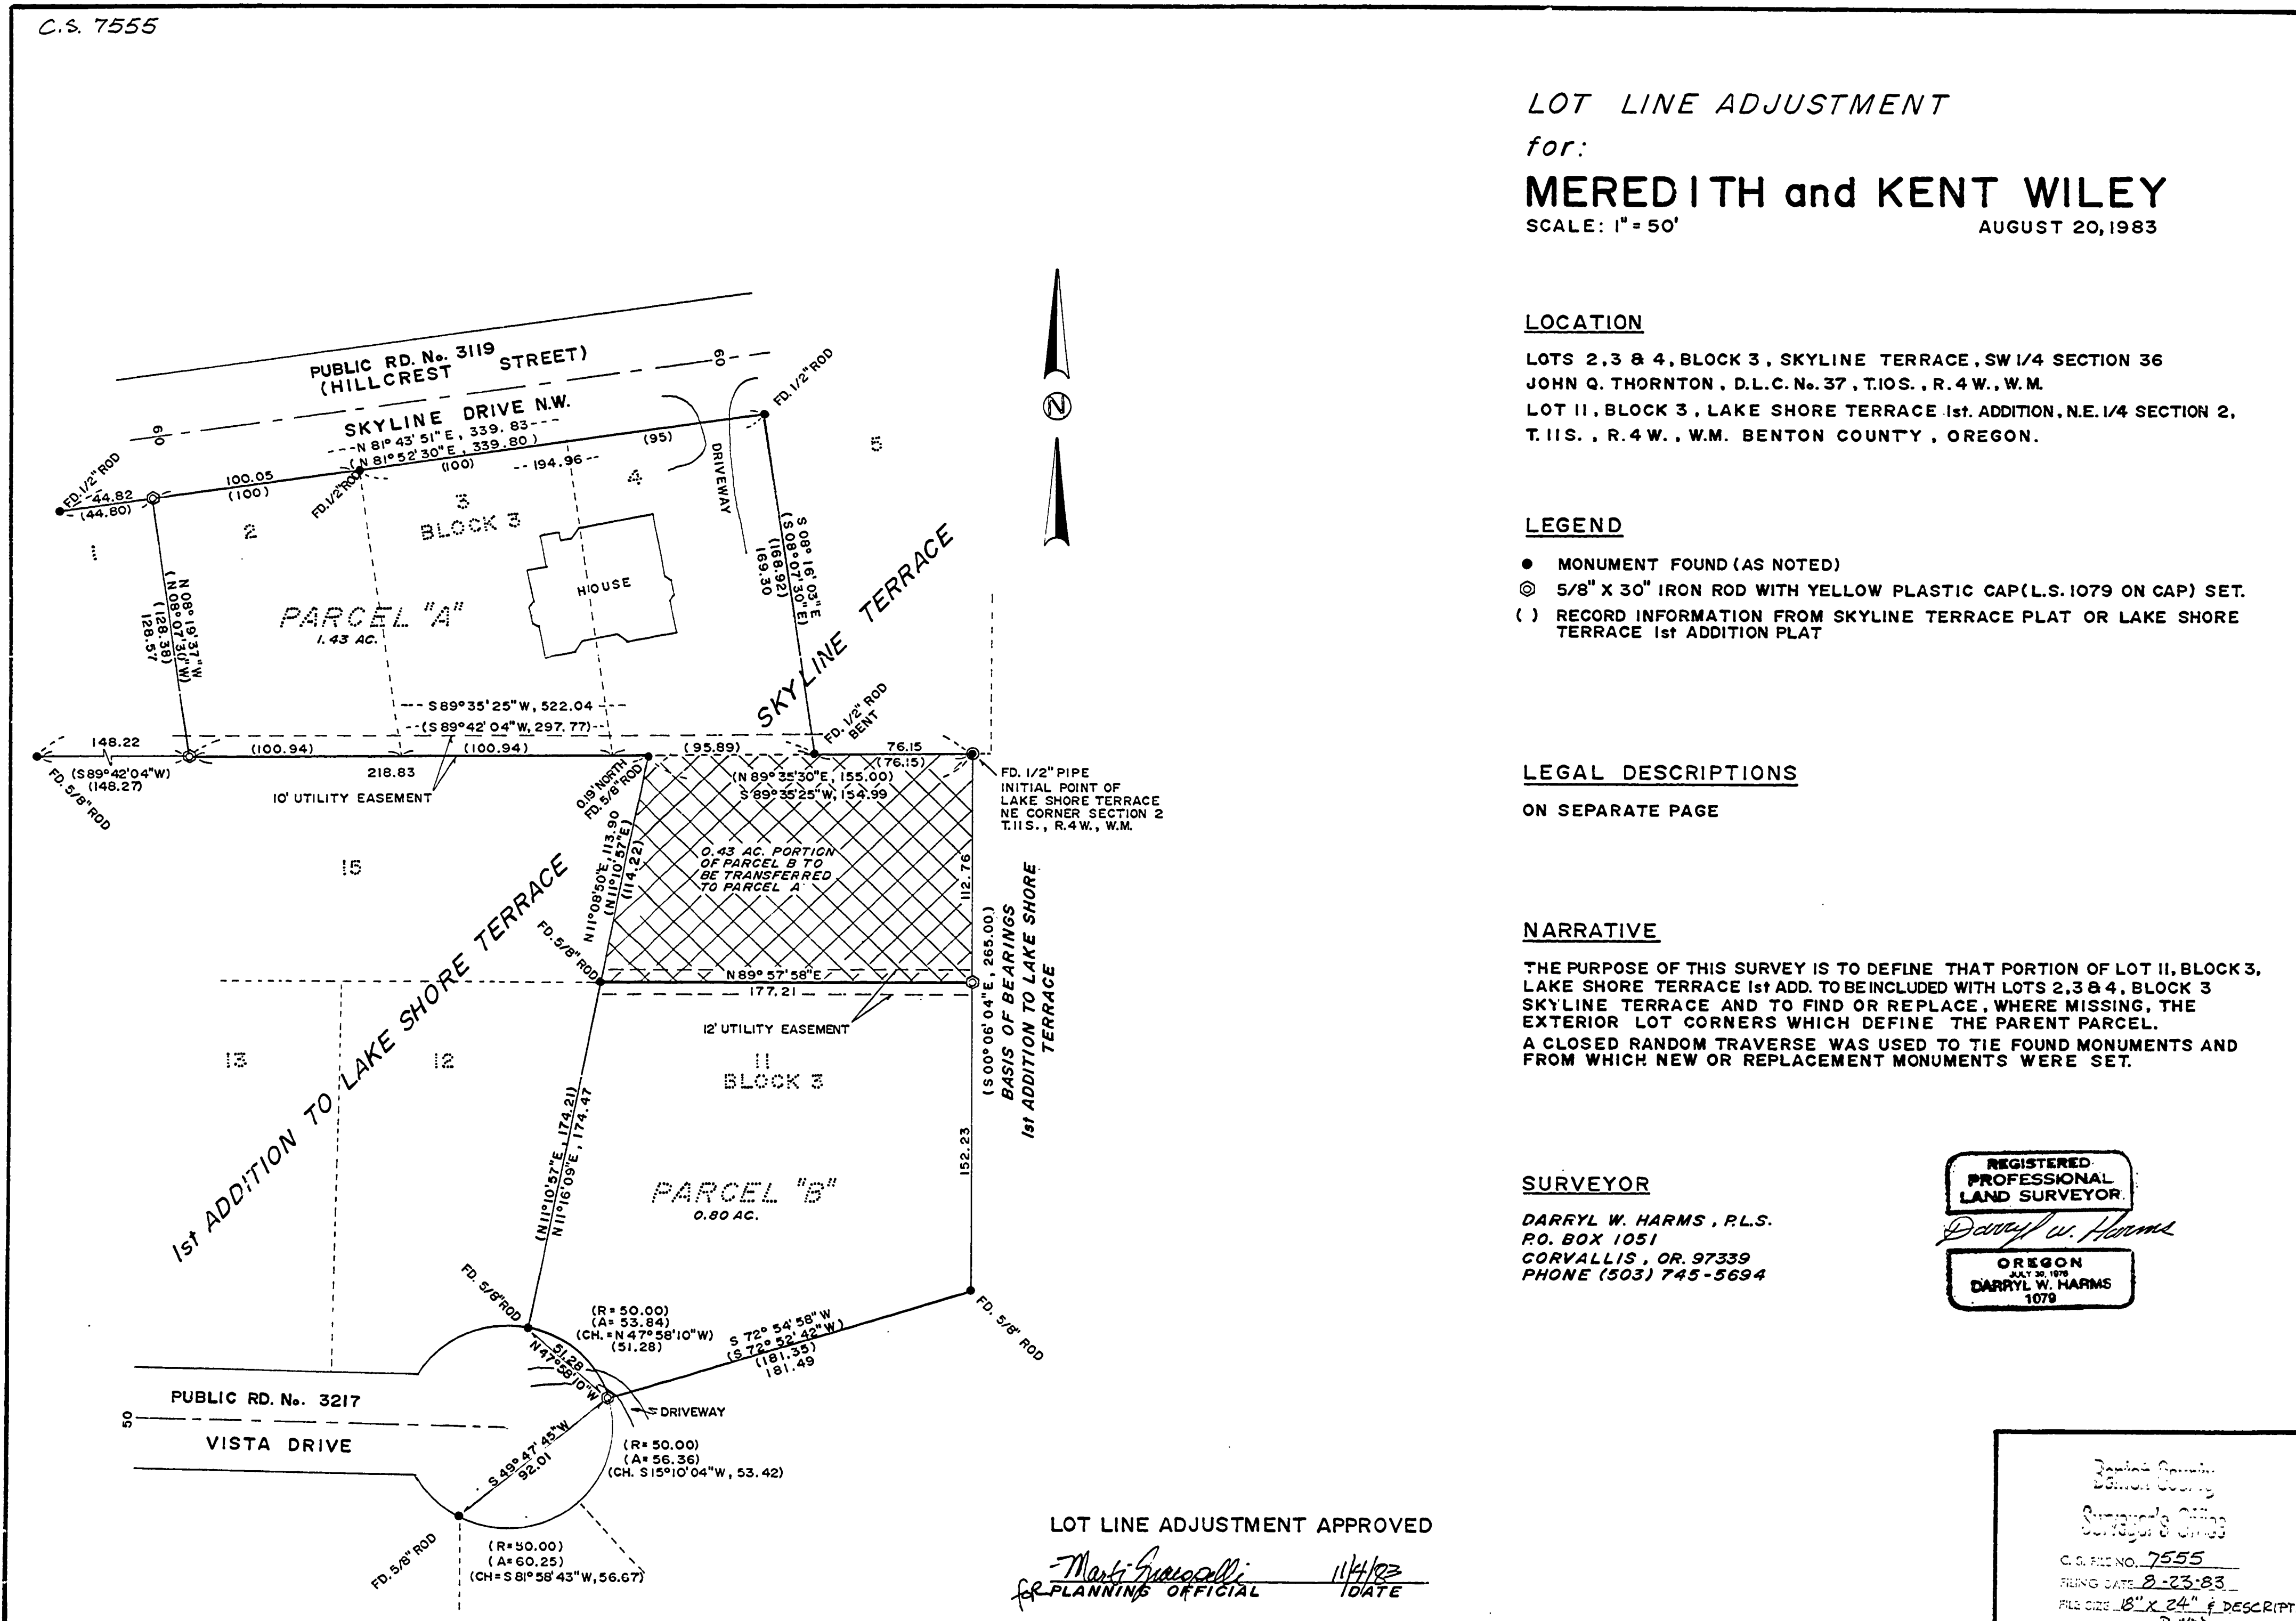

LOT LINE ADJUSTMENT

for:

MEREDITH and KENT WILEY

SCALE: 1" = 50'

AUGUST 20, 1983

LOCATION

LOTS 2, 3 & 4, BLOCK 3, SKYLINE TERRACE, SW 1/4 SECTION 36  
 JOHN Q. THORNTON, D.L.C. No. 37, T.10S., R. 4 W., W.M.  
 LOT 11, BLOCK 3, LAKE SHORE TERRACE 1st. ADDITION, N.E. 1/4 SECTION 2,  
 T. 11S., R. 4 W., W.M. BENTON COUNTY, OREGON.

LEGEND

- MONUMENT FOUND (AS NOTED)
- ⊙ 5/8" X 30" IRON ROD WITH YELLOW PLASTIC CAP (L.S. 1079 ON CAP) SET.
- ( ) RECORD INFORMATION FROM SKYLINE TERRACE PLAT OR LAKE SHORE TERRACE 1st ADDITION PLAT

LEGAL DESCRIPTIONS

ON SEPARATE PAGE

NARRATIVE

THE PURPOSE OF THIS SURVEY IS TO DEFINE THAT PORTION OF LOT 11, BLOCK 3, LAKE SHORE TERRACE 1st ADD. TO BE INCLUDED WITH LOTS 2, 3 & 4, BLOCK 3 SKYLINE TERRACE AND TO FIND OR REPLACE, WHERE MISSING, THE EXTERIOR LOT CORNERS WHICH DEFINE THE PARENT PARCEL. A CLOSED RANDOM TRAVERSE WAS USED TO TIE FOUND MONUMENTS AND FROM WHICH NEW OR REPLACEMENT MONUMENTS WERE SET.

SURVEYOR

DARRYL W. HARMS, P.L.S.  
 P.O. BOX 1051  
 CORVALLIS, OR. 97339  
 PHONE (503) 745-5694

REGISTERED  
 PROFESSIONAL  
 LAND SURVEYOR

*Darryl W. Harms*

OREGON  
 JULY 26, 1978  
 DARRYL W. HARMS  
 1079

LOT LINE ADJUSTMENT APPROVED

*Marta Surovelli* 11/1/83  
 PLANNING OFFICIAL DATE

Janice Conroy  
 Benton County  
 Surveyor's Office  
 C.S. FILE NO. 7555  
 FILING DATE 8-23-83  
 FILE SIZE 8" X 24" & DESCRIPT.  
 2, P.D.