


7574

7574

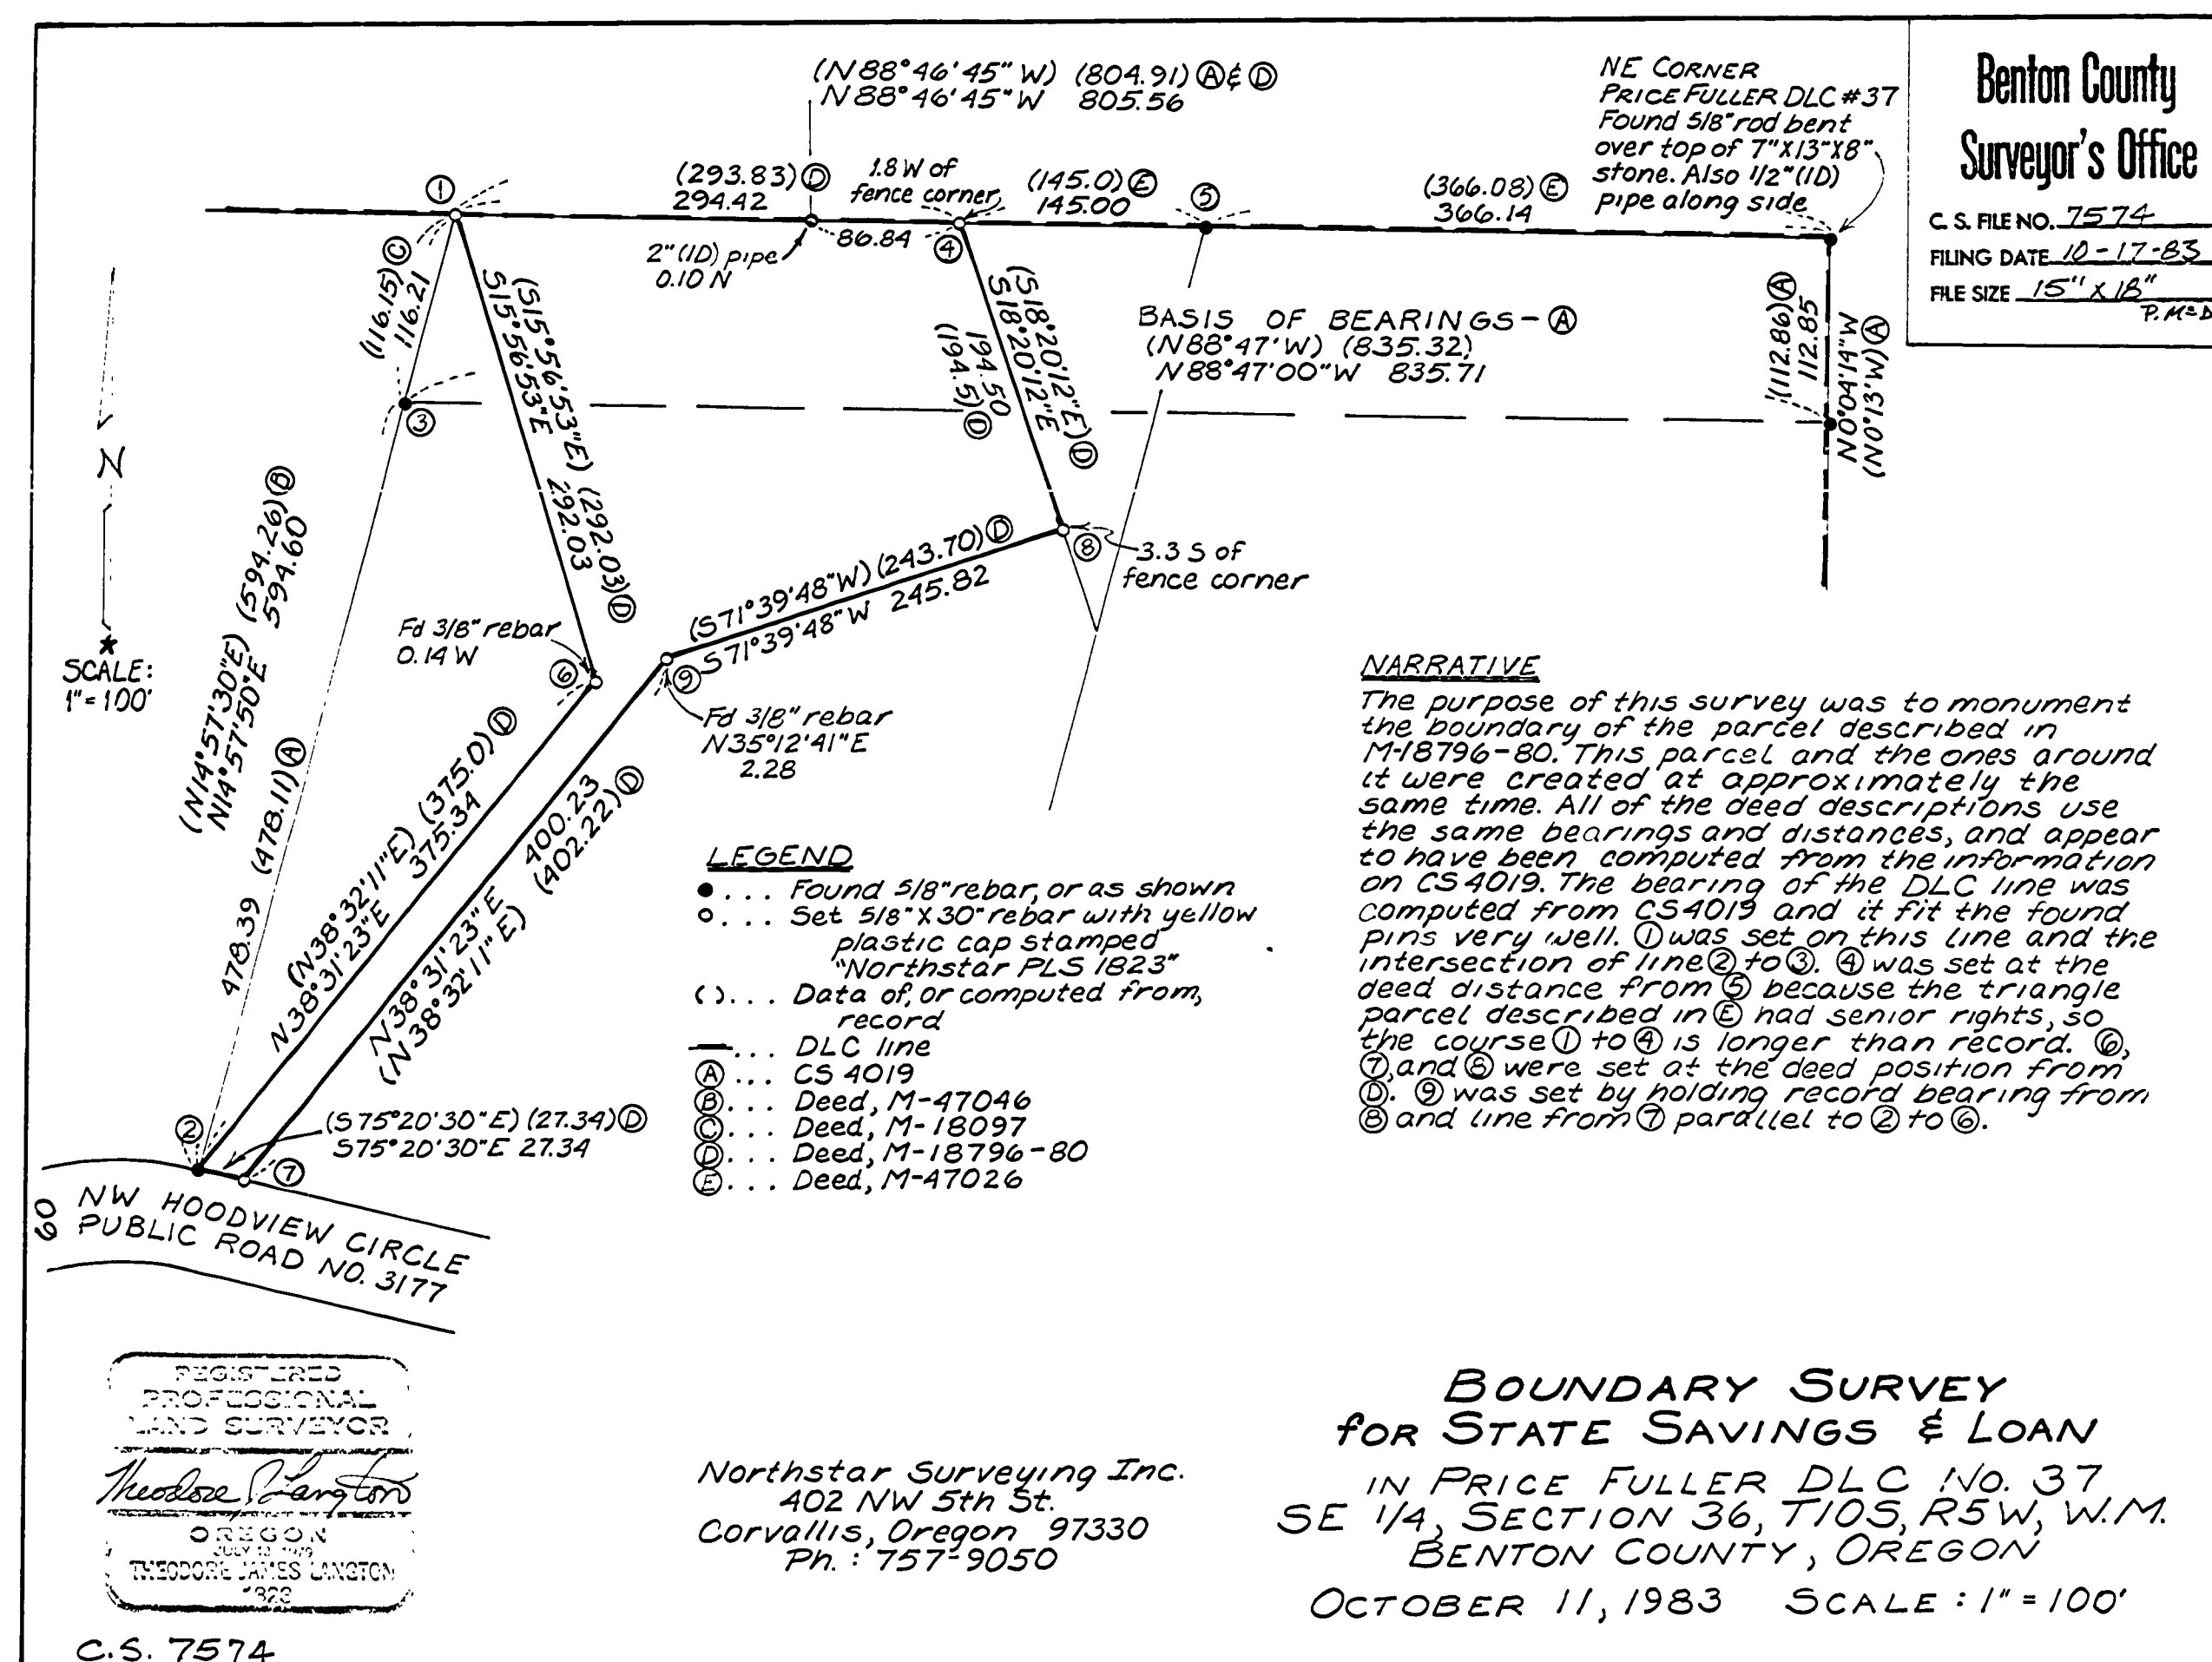

Benton County
Surveyor's Office
 C. S. FILE NO. 7574
 FILING DATE 10-17-83
 FILE SIZE 15" x 18" P.A.D.

NW HOODVIEW CIRCLE
 PUBLIC ROAD NO. 3177