


7632

7632

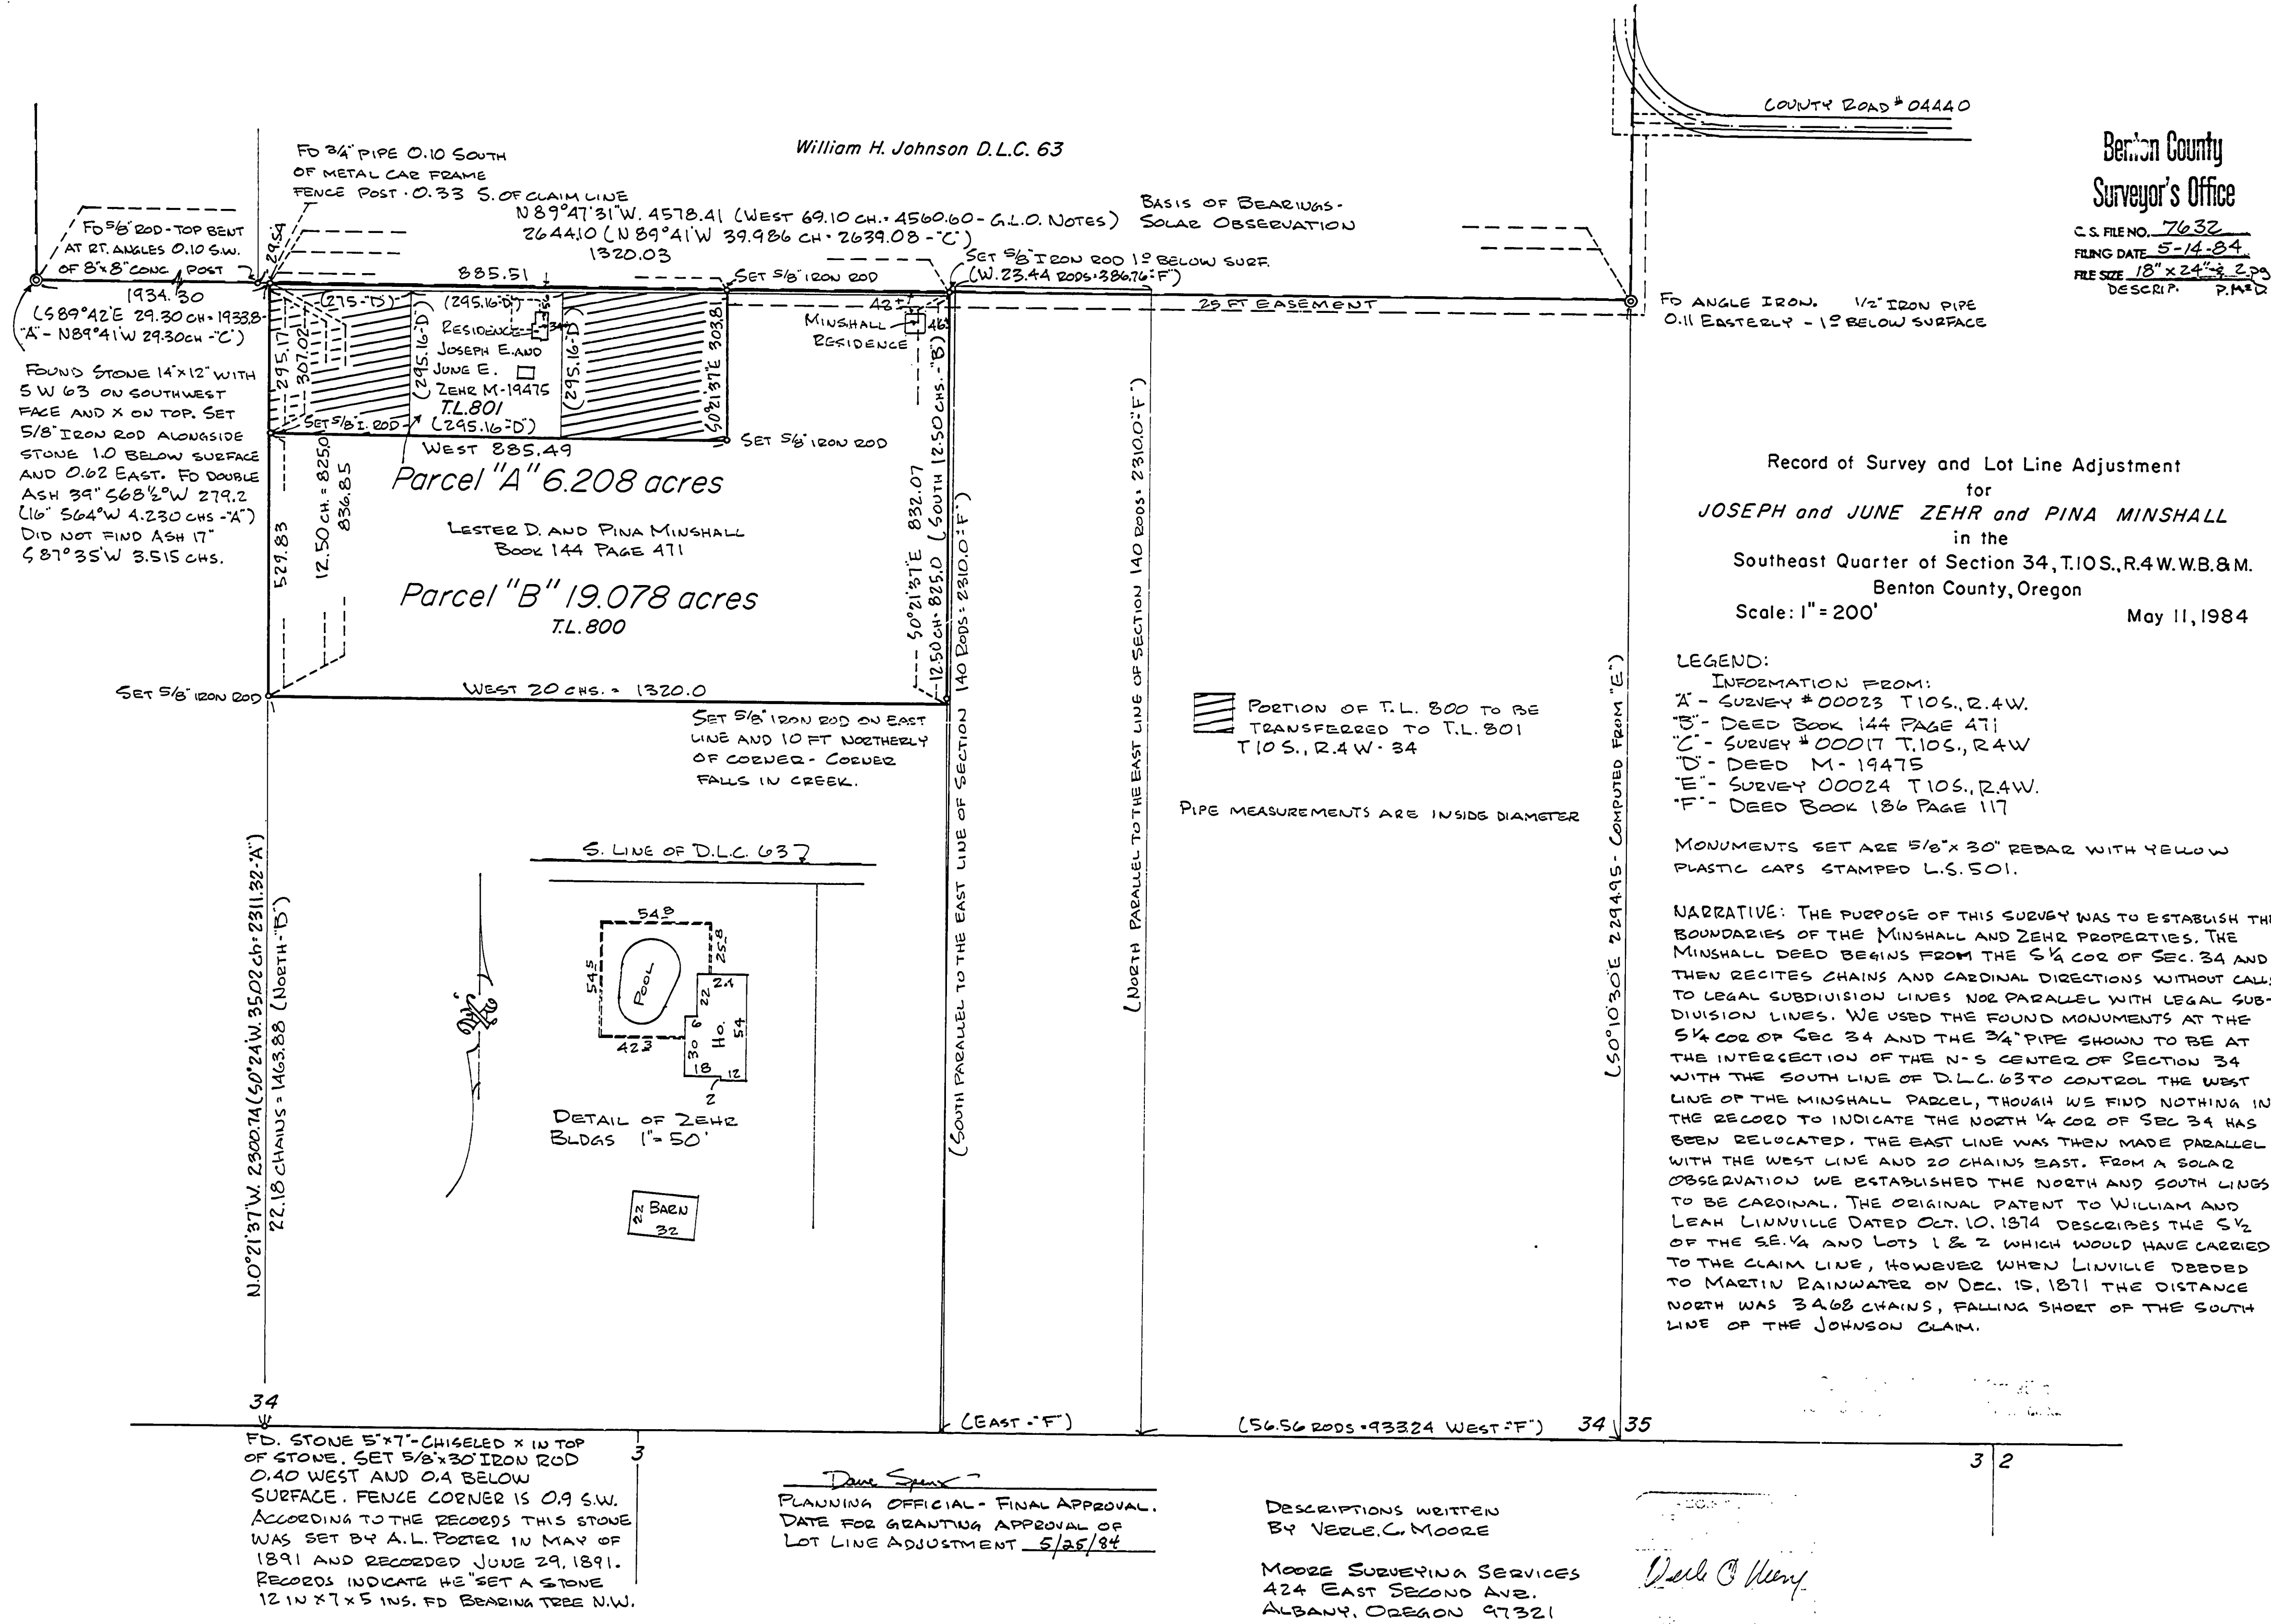

Benton County
Surveyor's Office
C.S. FILE NO. 7632
FILING DATE 5-14-84
FILE SIZE 18" x 24" x 2 ps
DESCRIP. P.M.A.D.

Record of Survey and Lot Line Adjustment
for
JOSEPH and JUNE ZEHR and PINA MINSHALL
in the
Southeast Quarter of Section 34, T.10S., R.4W. WB. & M.
Benton County, Oregon
Scale: 1" = 200' May 11, 1984