

LEGEND


INSTRUMENTS: NITE #1926
 300 FOOT CHANGERS TAP
 SWING BALANCE
 TANK THERMOMETER

DATUM = MEAN SEA LEVEL
 U.S. Coast & Geodetic Survey
 Reference 1932

EIMSTAD & ASSOCIATES
 1717 WASHINGTON
 EUGENE, OREGON
 DRAWN BY: [Signature] DATE: 11-25-84
 CHECKED BY: [Signature] DATE: 11-25-84
 WILLIAM E. EIMSTAD
 11-25-84
 3-7-7



APPROVAL	
SIGNATURE	DATE

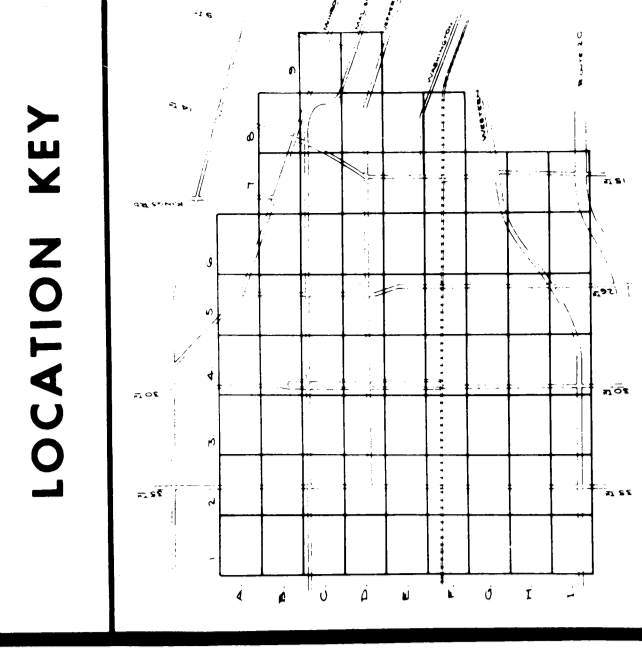

SHEET OF

SCALE 1" = 200'


BASE

NOTE: THIS SURVEY IS A PHOTO COPY OF THE ORIGINAL RECORD FILED IN BENTON COUNTY SURVEYOR'S OFFICE ON 12-11-84.

PLAT NO. 36, "X, 48"
 REC'D. 12-11-84

Benton County
 Surveyor's Office
 7705
 EUGENE, OREGON
 12-11-84

NOTE: THIS SURVEY IS A PHOTO COPY OF THE ORIGINAL RECORD FILED IN BENTON COUNTY SURVEYOR'S OFFICE ON 12-11-84.

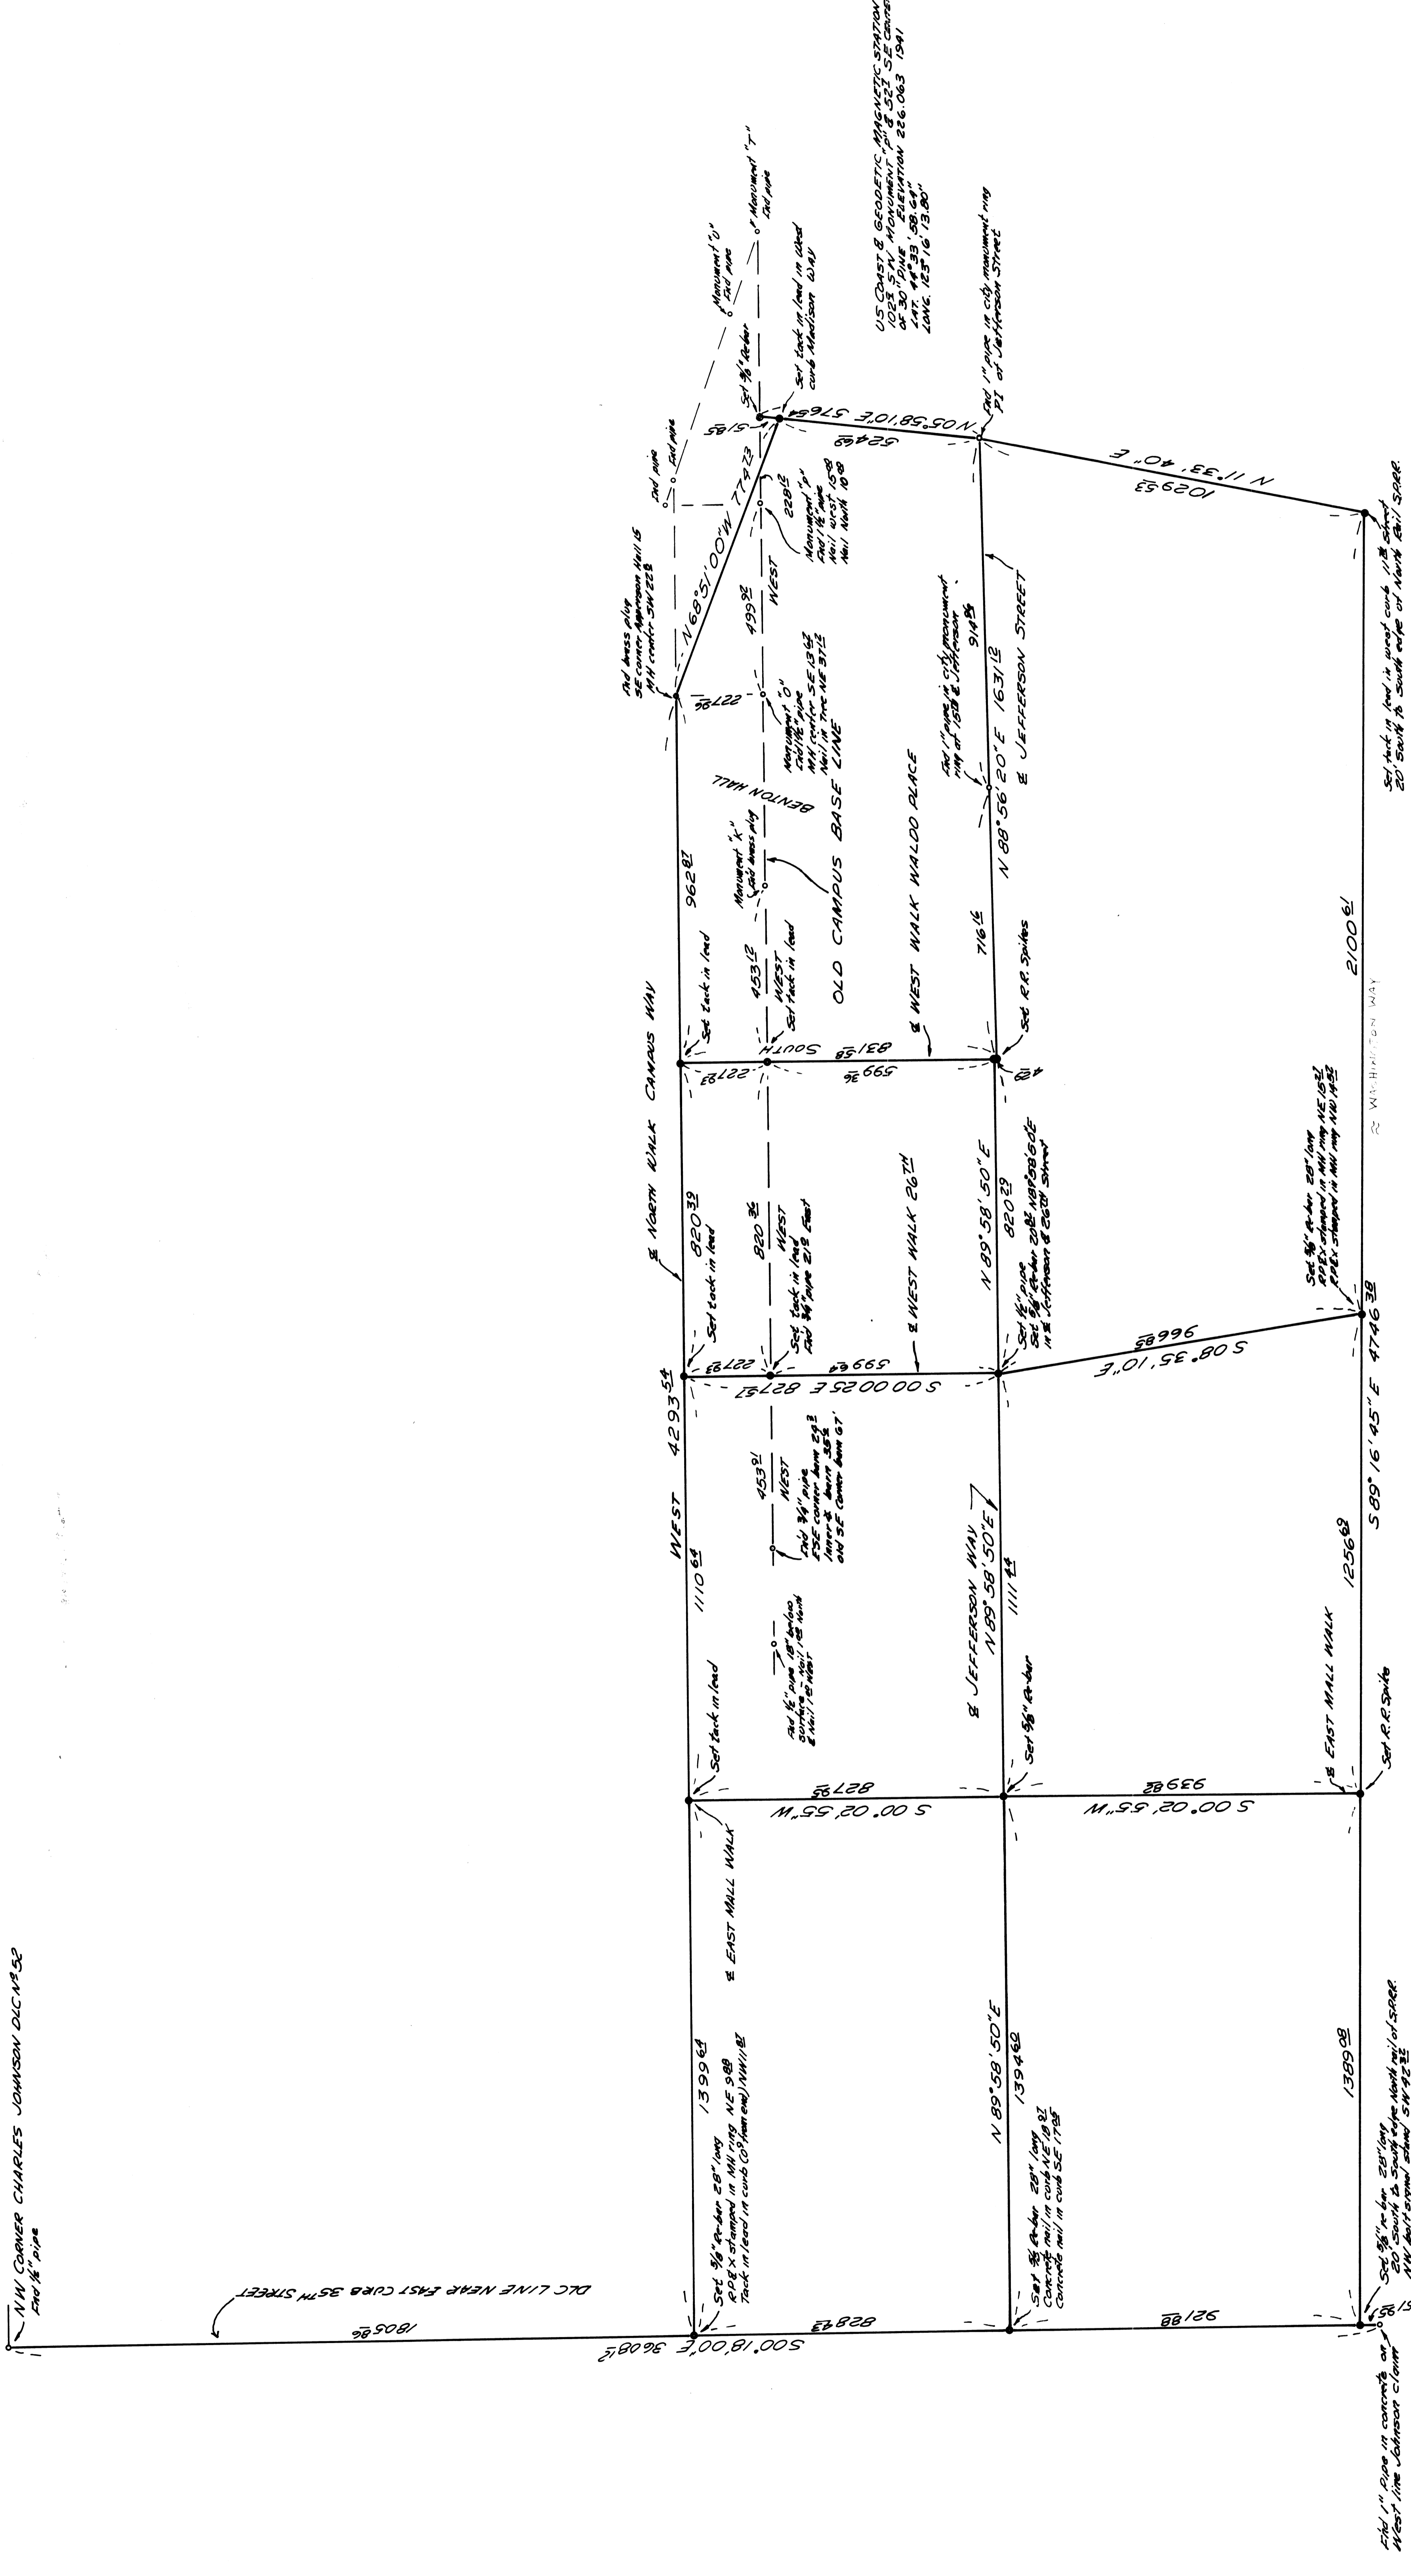

OREGON STATE UNIVERSITY
 CORVALLIS, OREGON

PHYSICAL PLANT DEPARTMENT

CAMPUS RECORD PLAN - BASE SURVEY

NO.	DATE	SIGNATURE	NO.	DATE	SIGNATURE	NO.	DATE	SIGNATURE	NO.	DATE	SIGNATURE	NO.	DATE	SIGNATURE	NO.	DATE	SIGNATURE