

ER
CALIFORNIA

DRAWING NUMBER
7822
PLAN HOLD CORPORATION • IRVINE, CALIFORNIA
REORDER BY NUMBER 075AR
POSITION EDGE OF PRINT ON THIS LINE

DRAWING NUMBER
7822
PLAN HOLD CORPORATION • IRVINE, CALIFORNIA
REORDER BY NUMBER 075AR
POSITION EDGE OF PRINT ON THIS LINE

PLAN HOLD

RECORD OF SURVEY/LOT LINE ADJUSTMENT

for PAUL LEE
in the SE 1/4 of SECTION 31, T.13S., R.5W.,
JACOB SLAGLE D.L.C. NO.62, W.M., BENTON COUNTY, OREGON
JULY 9, 1986

Benton County
Surveyor's Office
C.S. FILE NO. 7822
FILING DATE 7-11-1986
PLS. SIZE 15" x 18"



SCALE 1"=200'

LEGEND

- FOUND 3" BRASS CAP ON 3" CONCRETE POST, EXCEPT AS NOTED
- SET 3/8" X 30" IRON ROD WITH YELLOW PLASTIC CAP MARKED LS 1102
- () DATA OF RECORD
- FENCE

NARRATIVE

THIS SURVEY WAS DONE TO MONUMENT 10 ACRES AS SHOWN, AT THE REQUEST OF PAUL LEE. THE SOUTHWEST CORNER OF D.L.C. NO. 62 WAS DETERMINED 20 FEET SOUTH OF THE FOUND IRON PIPES AND AT INTERSECTION OF AN OLD FENCE GOING NORTHERLY. C.S. 3941 USED THIS FENCE AS THE D.L.C. LINE ALSO. THE SURVEY WAS PERFORMED WITH A 10" TOTAL STATION.


REGISTERED PROFESSIONAL LAND SURVEYOR

Norman D. Springer

OREGON
JULY 22, 1977
NORMAN D. SPRINGER
1102

SPRINGER SURVEYING
37056 MASS ROCK DR.
CORVALLIS, OR 97330
745-5778

APPROVED

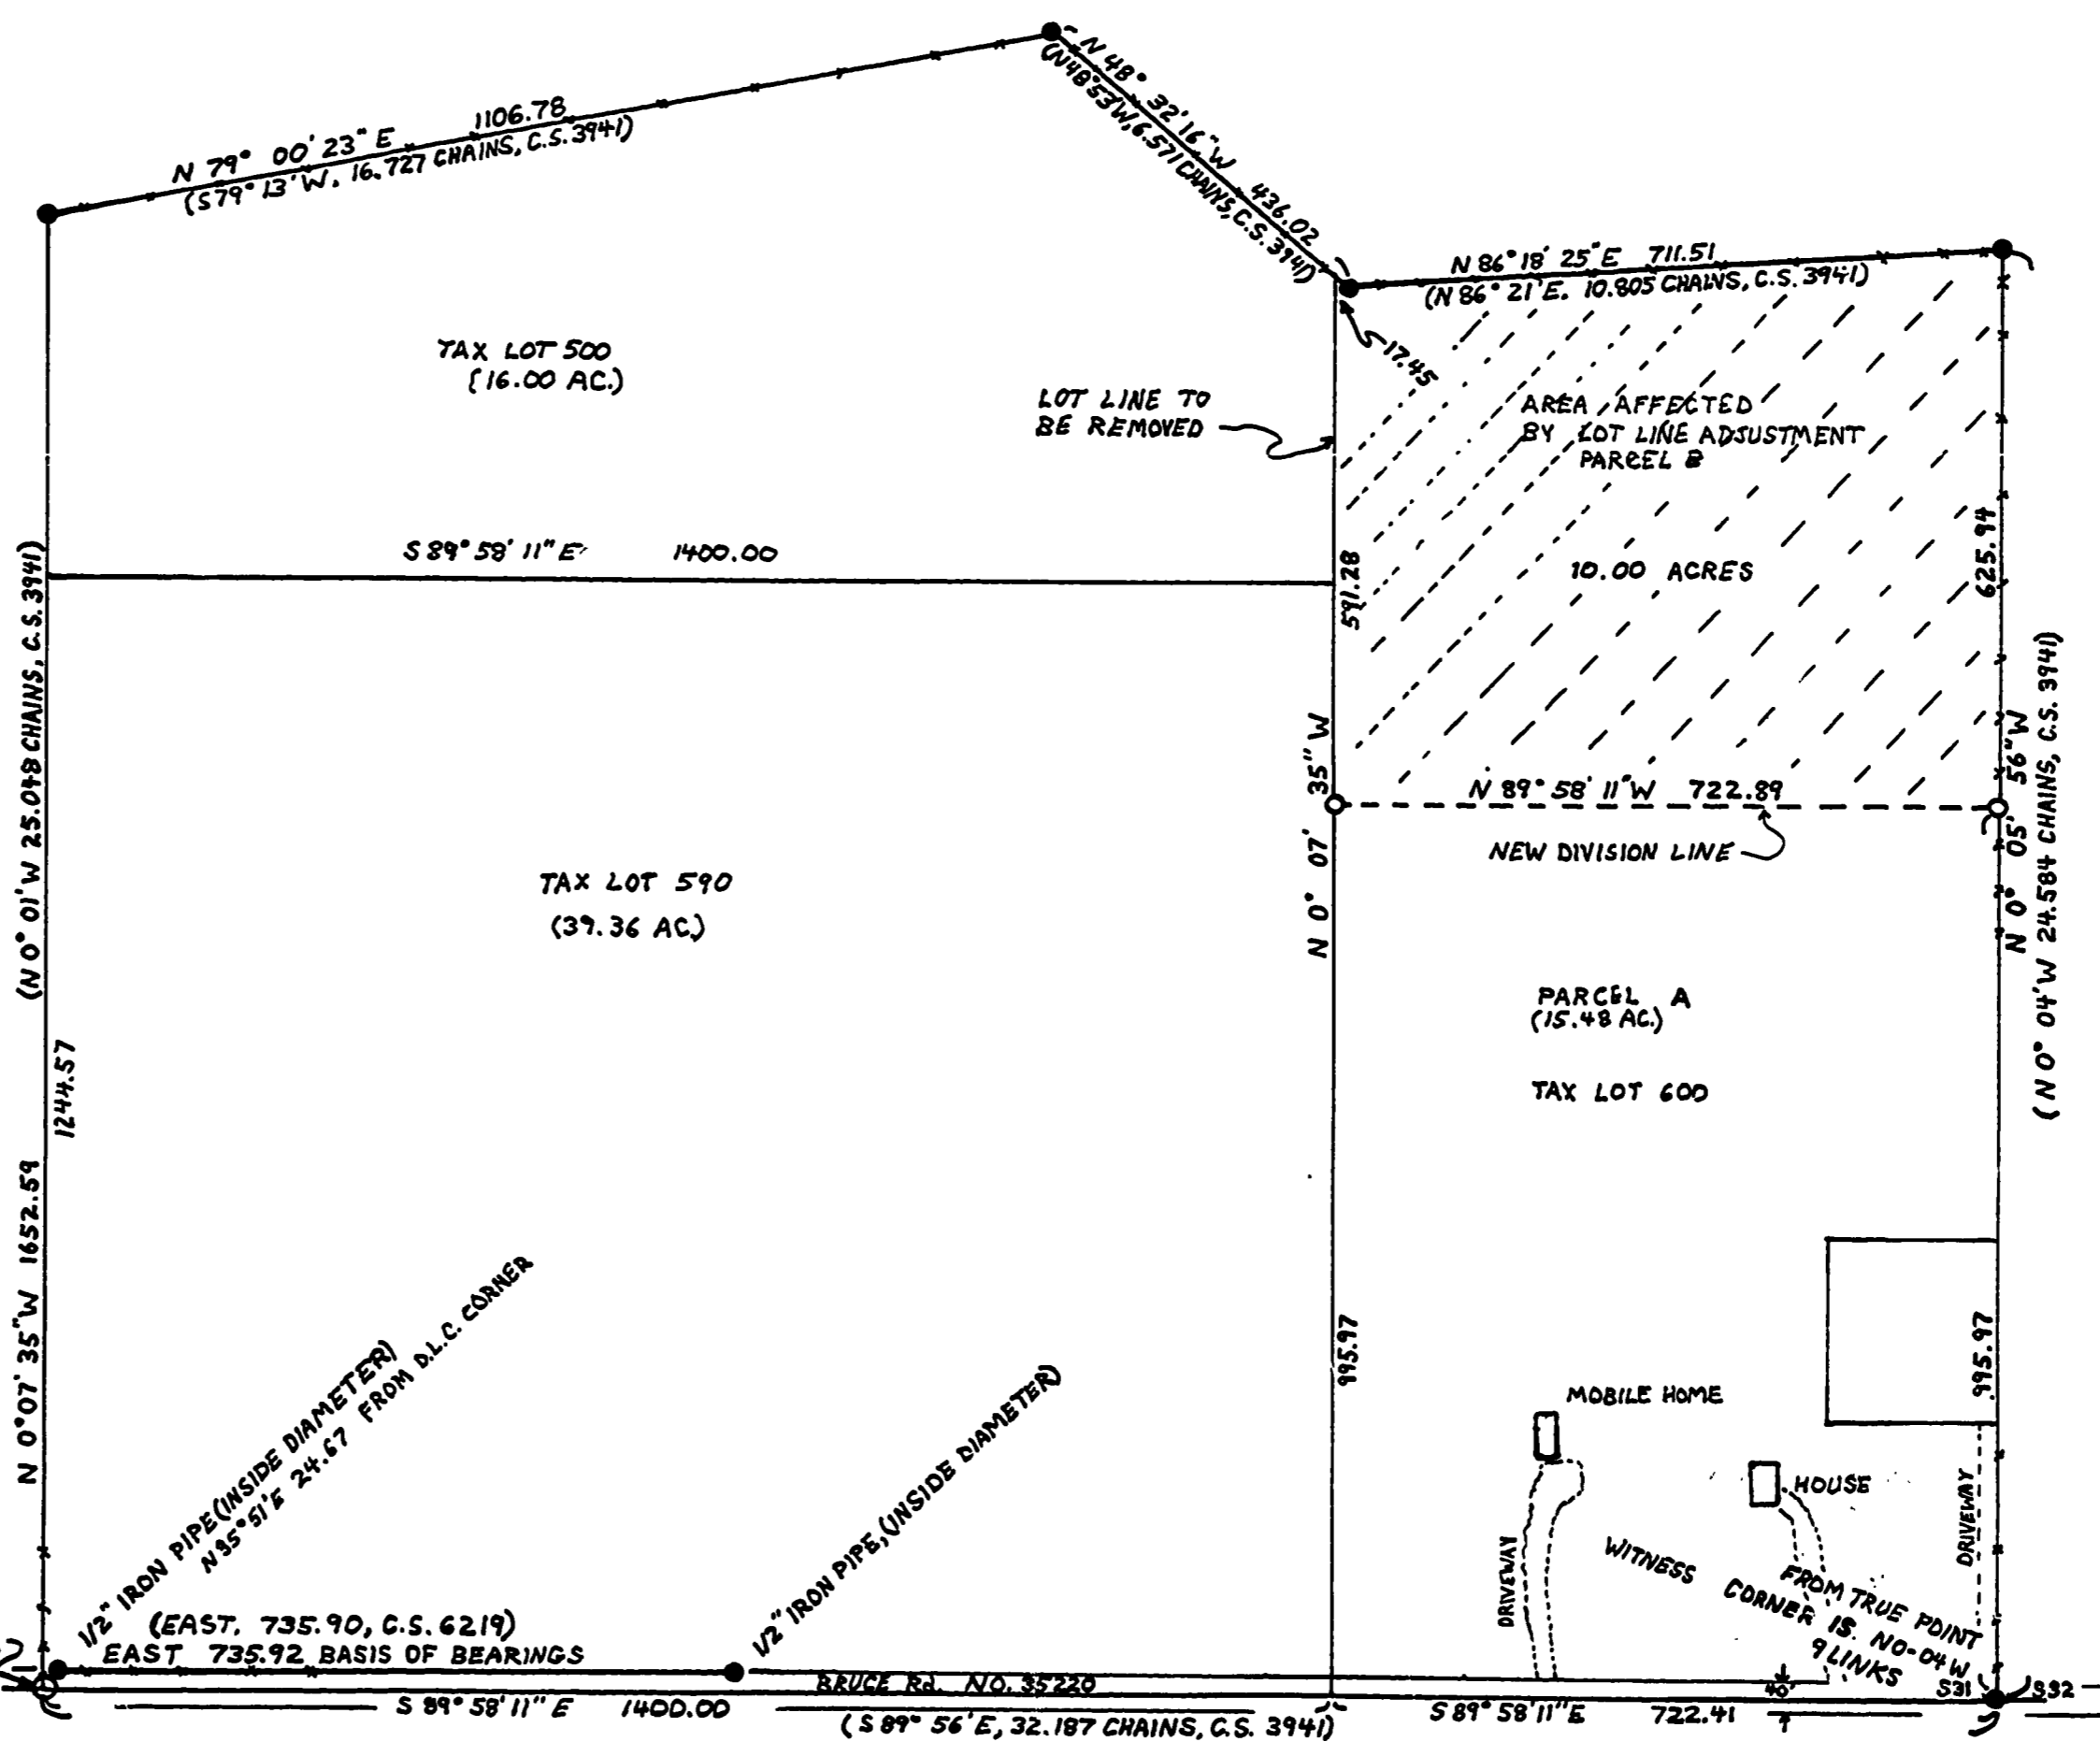

C.S. 7822