

B - 124

THIS SURVEY RECEIVED OCT. 1986
FROM LINN CO. SURVEYORS OFFICE

DENVER UNRUH


Lot 6, Bl. 3, Rolling Green
Benton County, Oregon

Scale: 1" = 30'

April 6, 1971

Orris A. Carnegie, Reg. Ore. Land Surveyor

By: Frank Howe

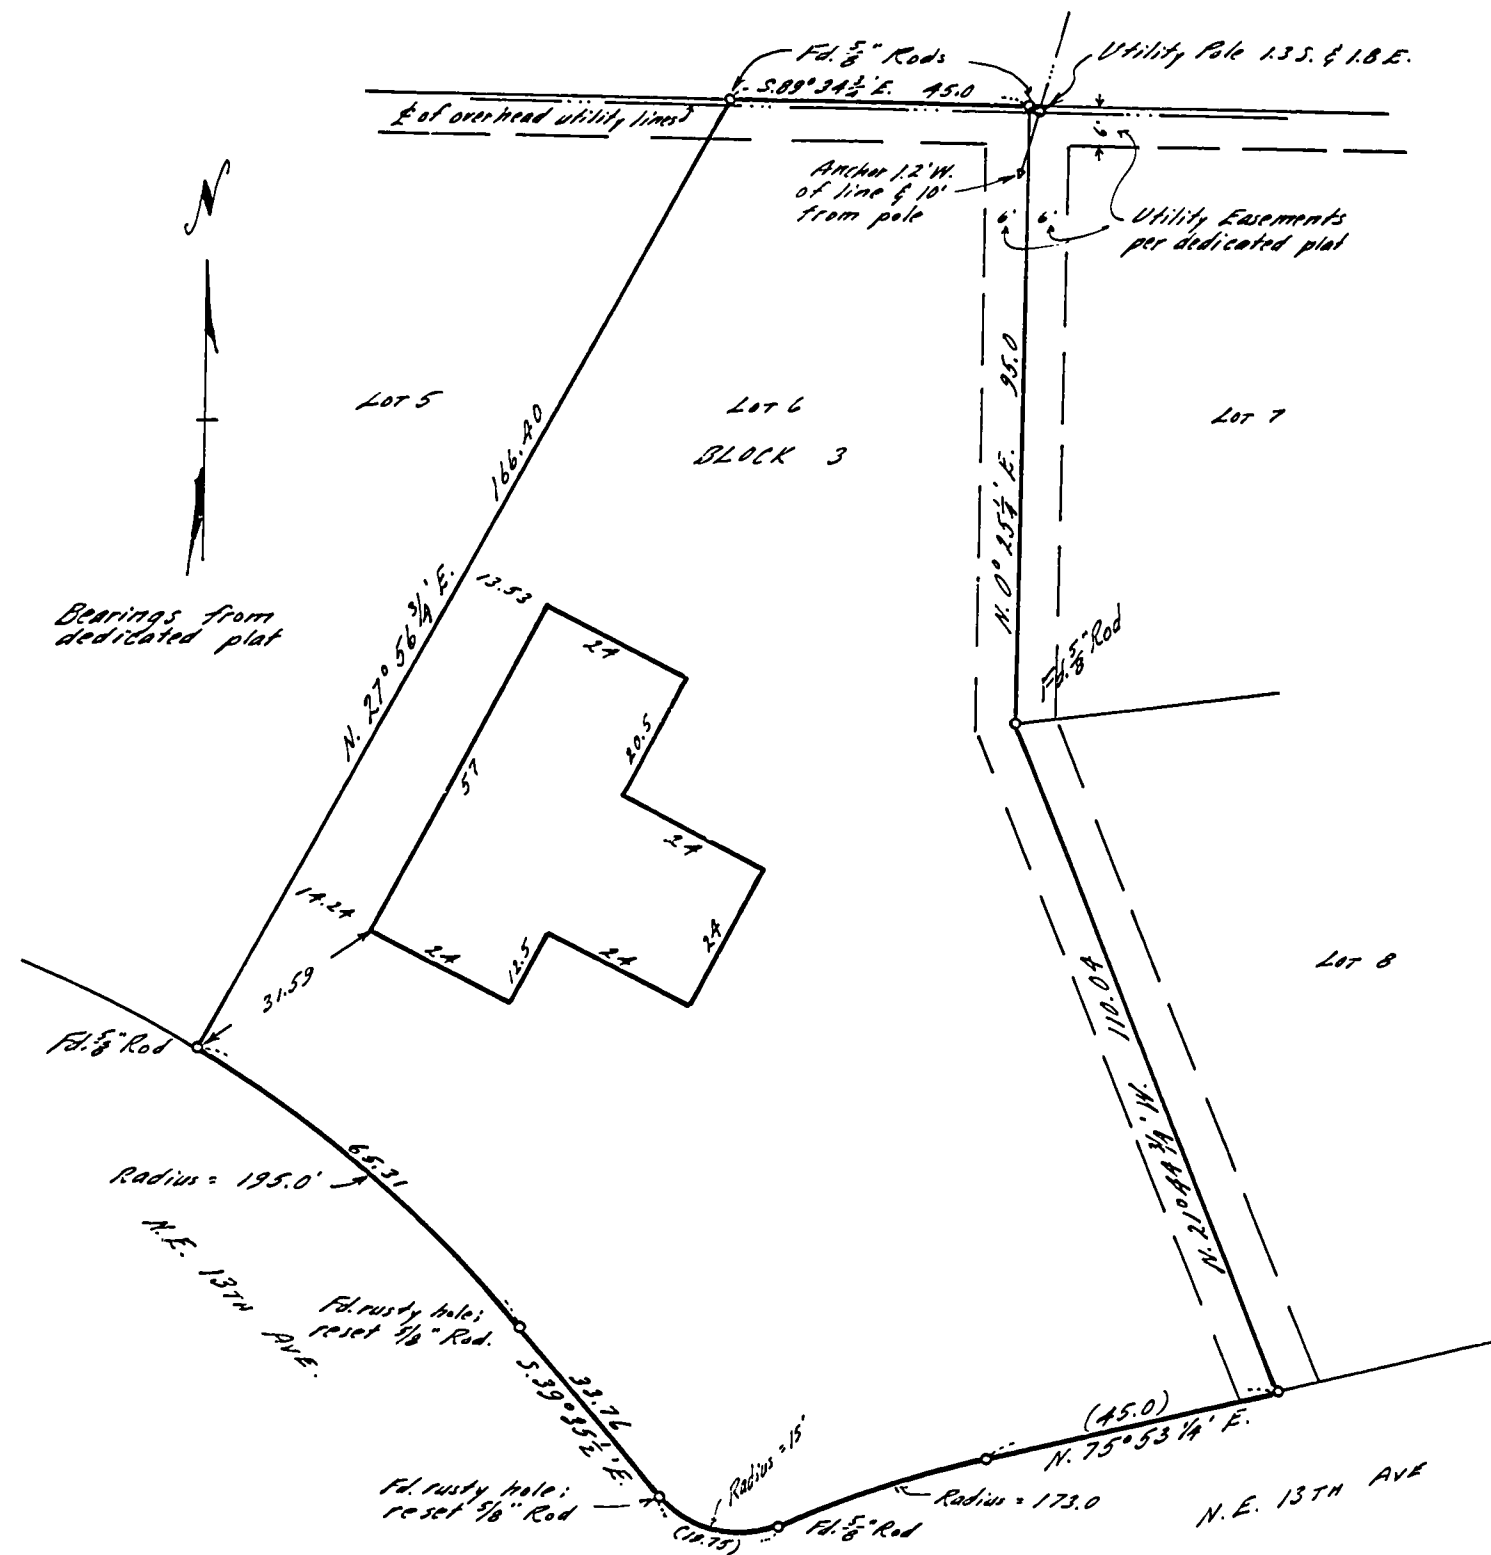

Description: Lot 6, Block 3, ROLLING GREEN in Benton County, Oregon.

Certificate: I certify that the herein described property was surveyed under my immediate supervision and that the improvements shown were found to be on the premises in question and that they do not overlap or encroach on the property adjacent thereto.

Benton County
Surveyor's Office

C. S. FILE NO. 7825
FILING DATE 7-14-86
FILE SIZE 8 1/2 x 14

REGISTERED
OREGON
LAND SURVEYOR

Orris A. Carnegie
MAY 9, 1947
ORRIS A. CARNEGIE
213

DECI 10 EDAME 0 4 1