


MICHAEL J. & EILEEN B. CORSO

Lot 8, Bl. 3, Riverview Heights Subdivision  
Benton County, Oregon

Scale: 1" = 30' May 25, 1972  
Orris A. Carnegie  
Reg. Professional Land Surveyor  
By: Frank Howe

1st Revision May 30, 1972

Bearings from  
dedicated plat

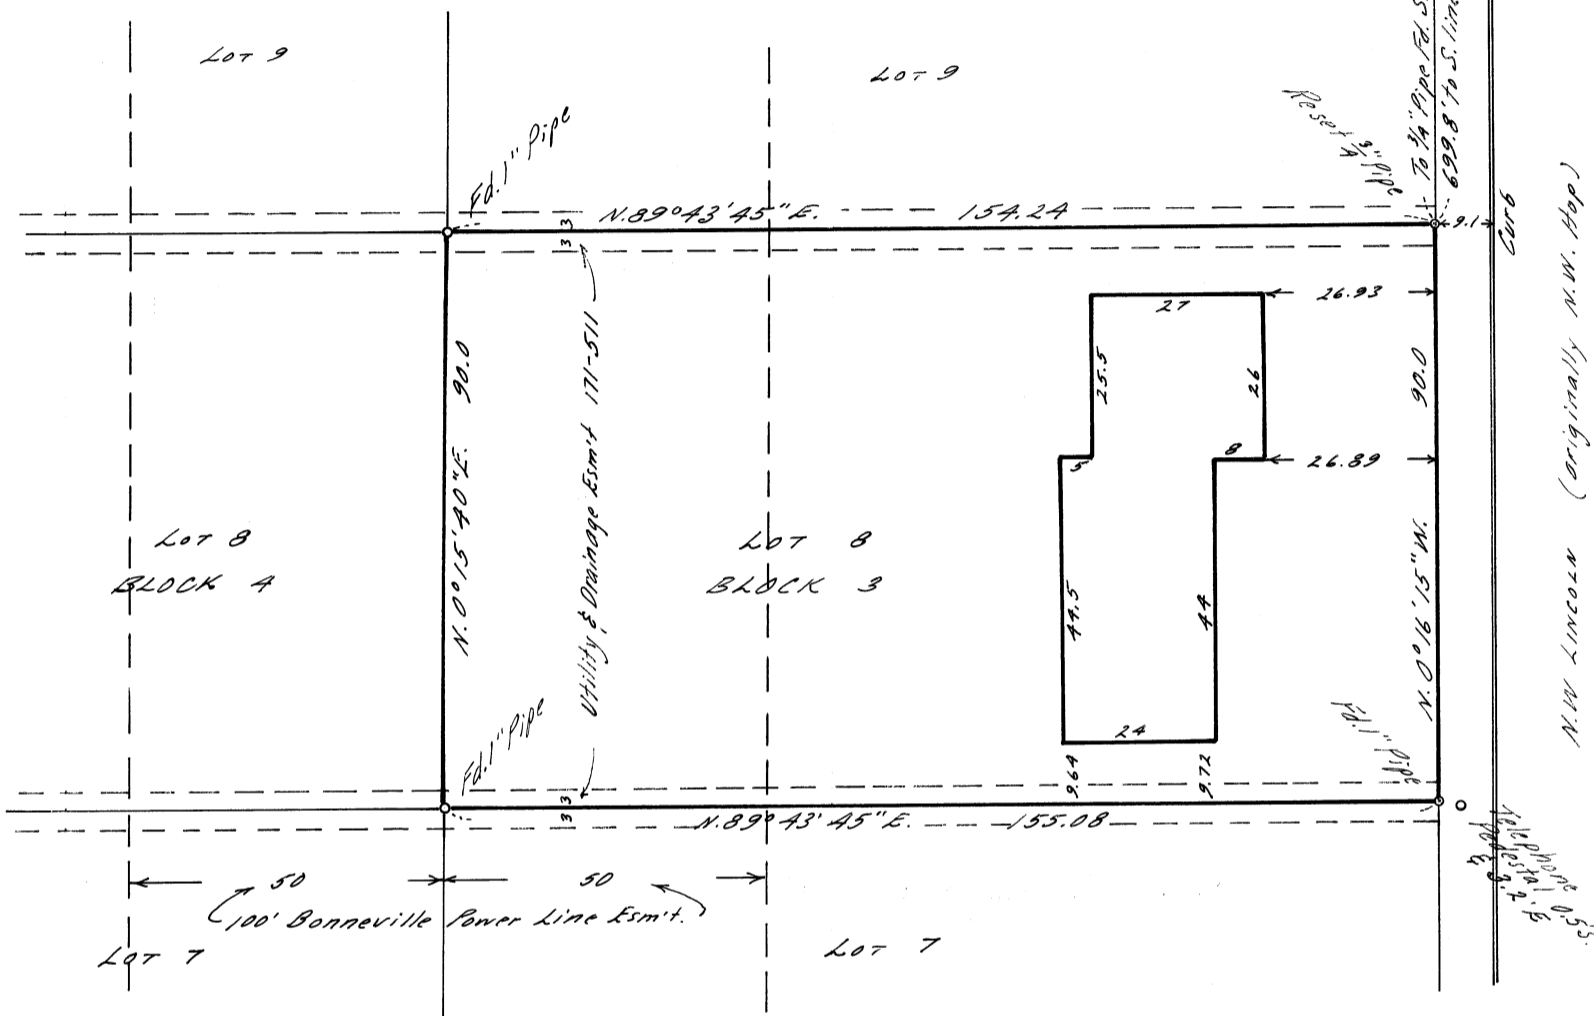

Address: 1724 N. W. Lincoln, Albany, Oregon.

Description: Lot 8, Block 3, RIVERVIEW HEIGHTS SUBDIVISION, in the County of Benton and State of Oregon.

Certificate: I certify that the herein described property was surveyed under my immediate supervision and that the improvements shown were found to be on the premises in question and that they do not overlap or encroach on the property adjacent thereto.

Benton County  
Surveyor's Office

C. S. FILE NO. 7831  
FILING DATE 7-14-86  
FILE SIZE 8 1/4 X 14

REGISTERED  
PROFESSIONAL  
LAND SURVEYOR

Orris A. Carnegie

OREGON  
JULY 19, 1947  
ORRIS A. CARNEGIE  
213

Printed at Albany, Oregon 5-26-72