



B - 122

DENVER UNRUH


Lot 7, Bl. 3, Rolling Green  
Benton County, Oregon

Scale: 1" = 30'

March 8, 1971

Crris A. Carnegie  
Reg. Ore. Land Surveyor  
By: C. W. Strandt

Bearings from  
dedicated plat

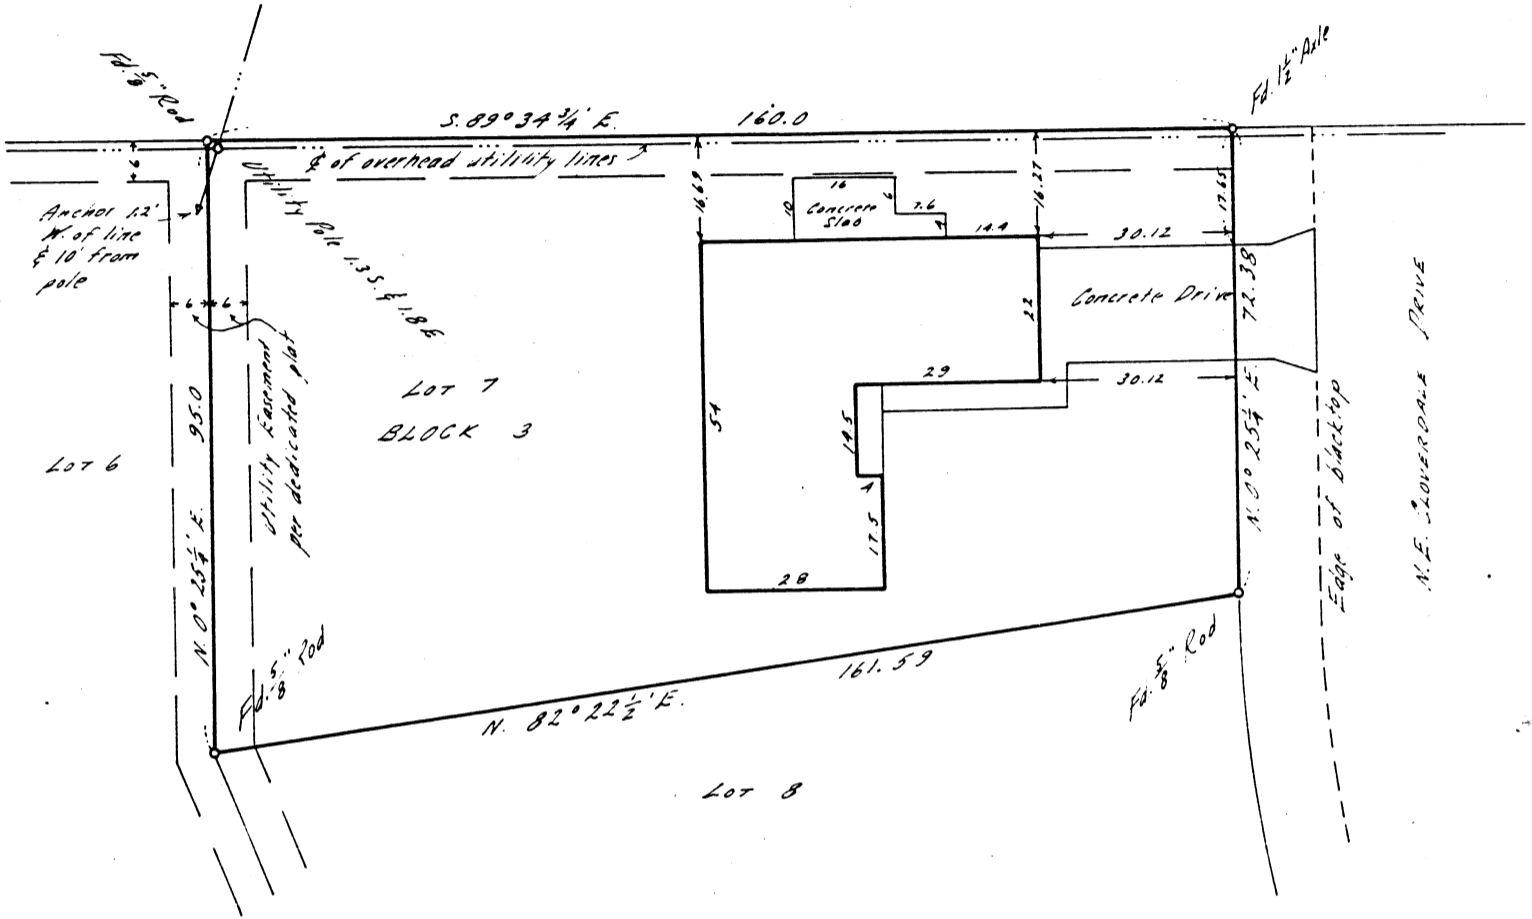

Description: Lot 7, Block 3, ROLLING GREEN in Benton County, Oregon.

Certificate: I certify that the herein described property was surveyed under my immediate supervision and that the improvements shown were found to be on the premises in question and that they do not overlap or encroach on the property adjacent thereto.

THIS SURVEY RECEIVED OCT. 1985  
FROM LINDA CO. SURVEYORS OFFICE

RECORDED  
ON  
MAR 12 1971

*Crris A. Carnegie*

CARRIS A. CARNEGIE  
REG. ORE. LAND SURVEYOR

**Benton County**  
**Surveyor's Office**

C. S. FILE NO. 7899  
FILING DATE 7-21-86  
FILE SIZE 8 1/2 x 14