



12-22-86

C.S. 7955

REGISTERED
PROFESSIONAL
LAND SURVEYOR

Theodore Langton

OREGON
JULY 1971
THEODORE JAMES LANGTON
1823

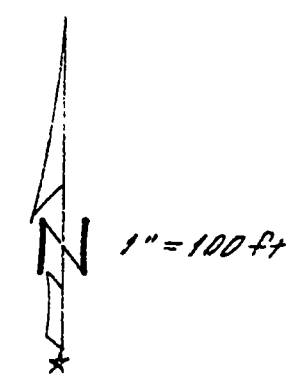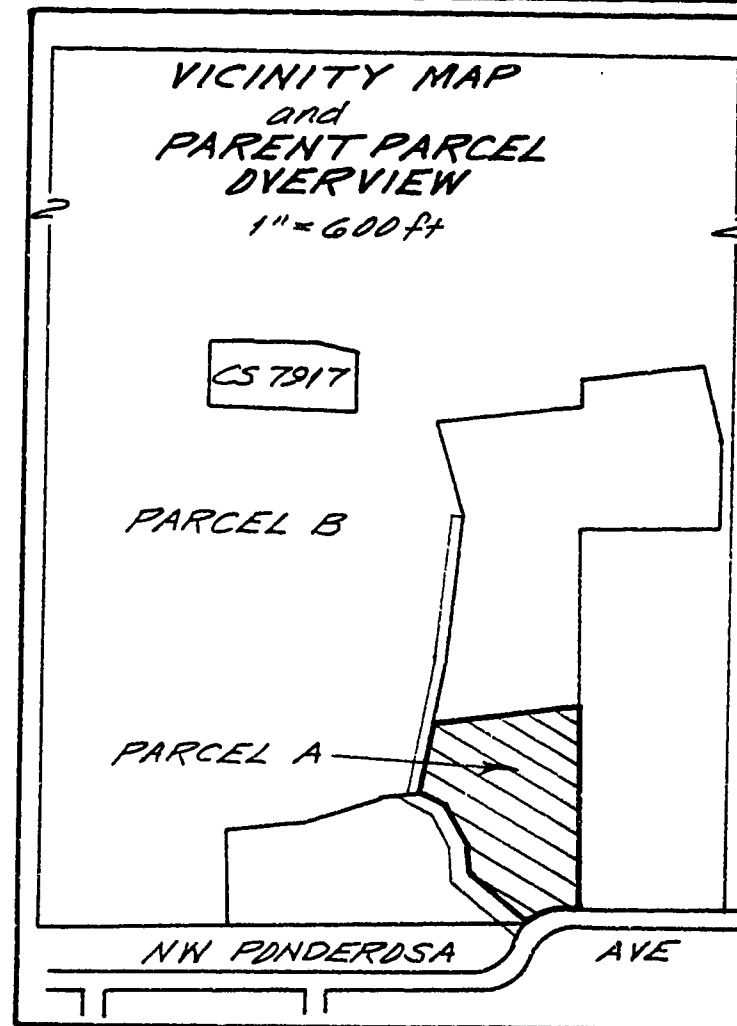

Benton County
Surveyor's Office

C.S. FILE NO. 7955

RECORDING DATE 12-22-86


PLAT SIZE 15 1/2" x 18"

1pg DESCRIPTION

MINOR LAND PARTITION SURVEY
for
THE GRANT DECKER ESTATE
SE 1/4 SEC. 20, T11S, R5W, W.M.
BENTON COUNTY, OREGON
DECEMBER 13, 1986

MINOR LAND PARTITION APPROVED

Dave Spurr 2/9/87
planning official date

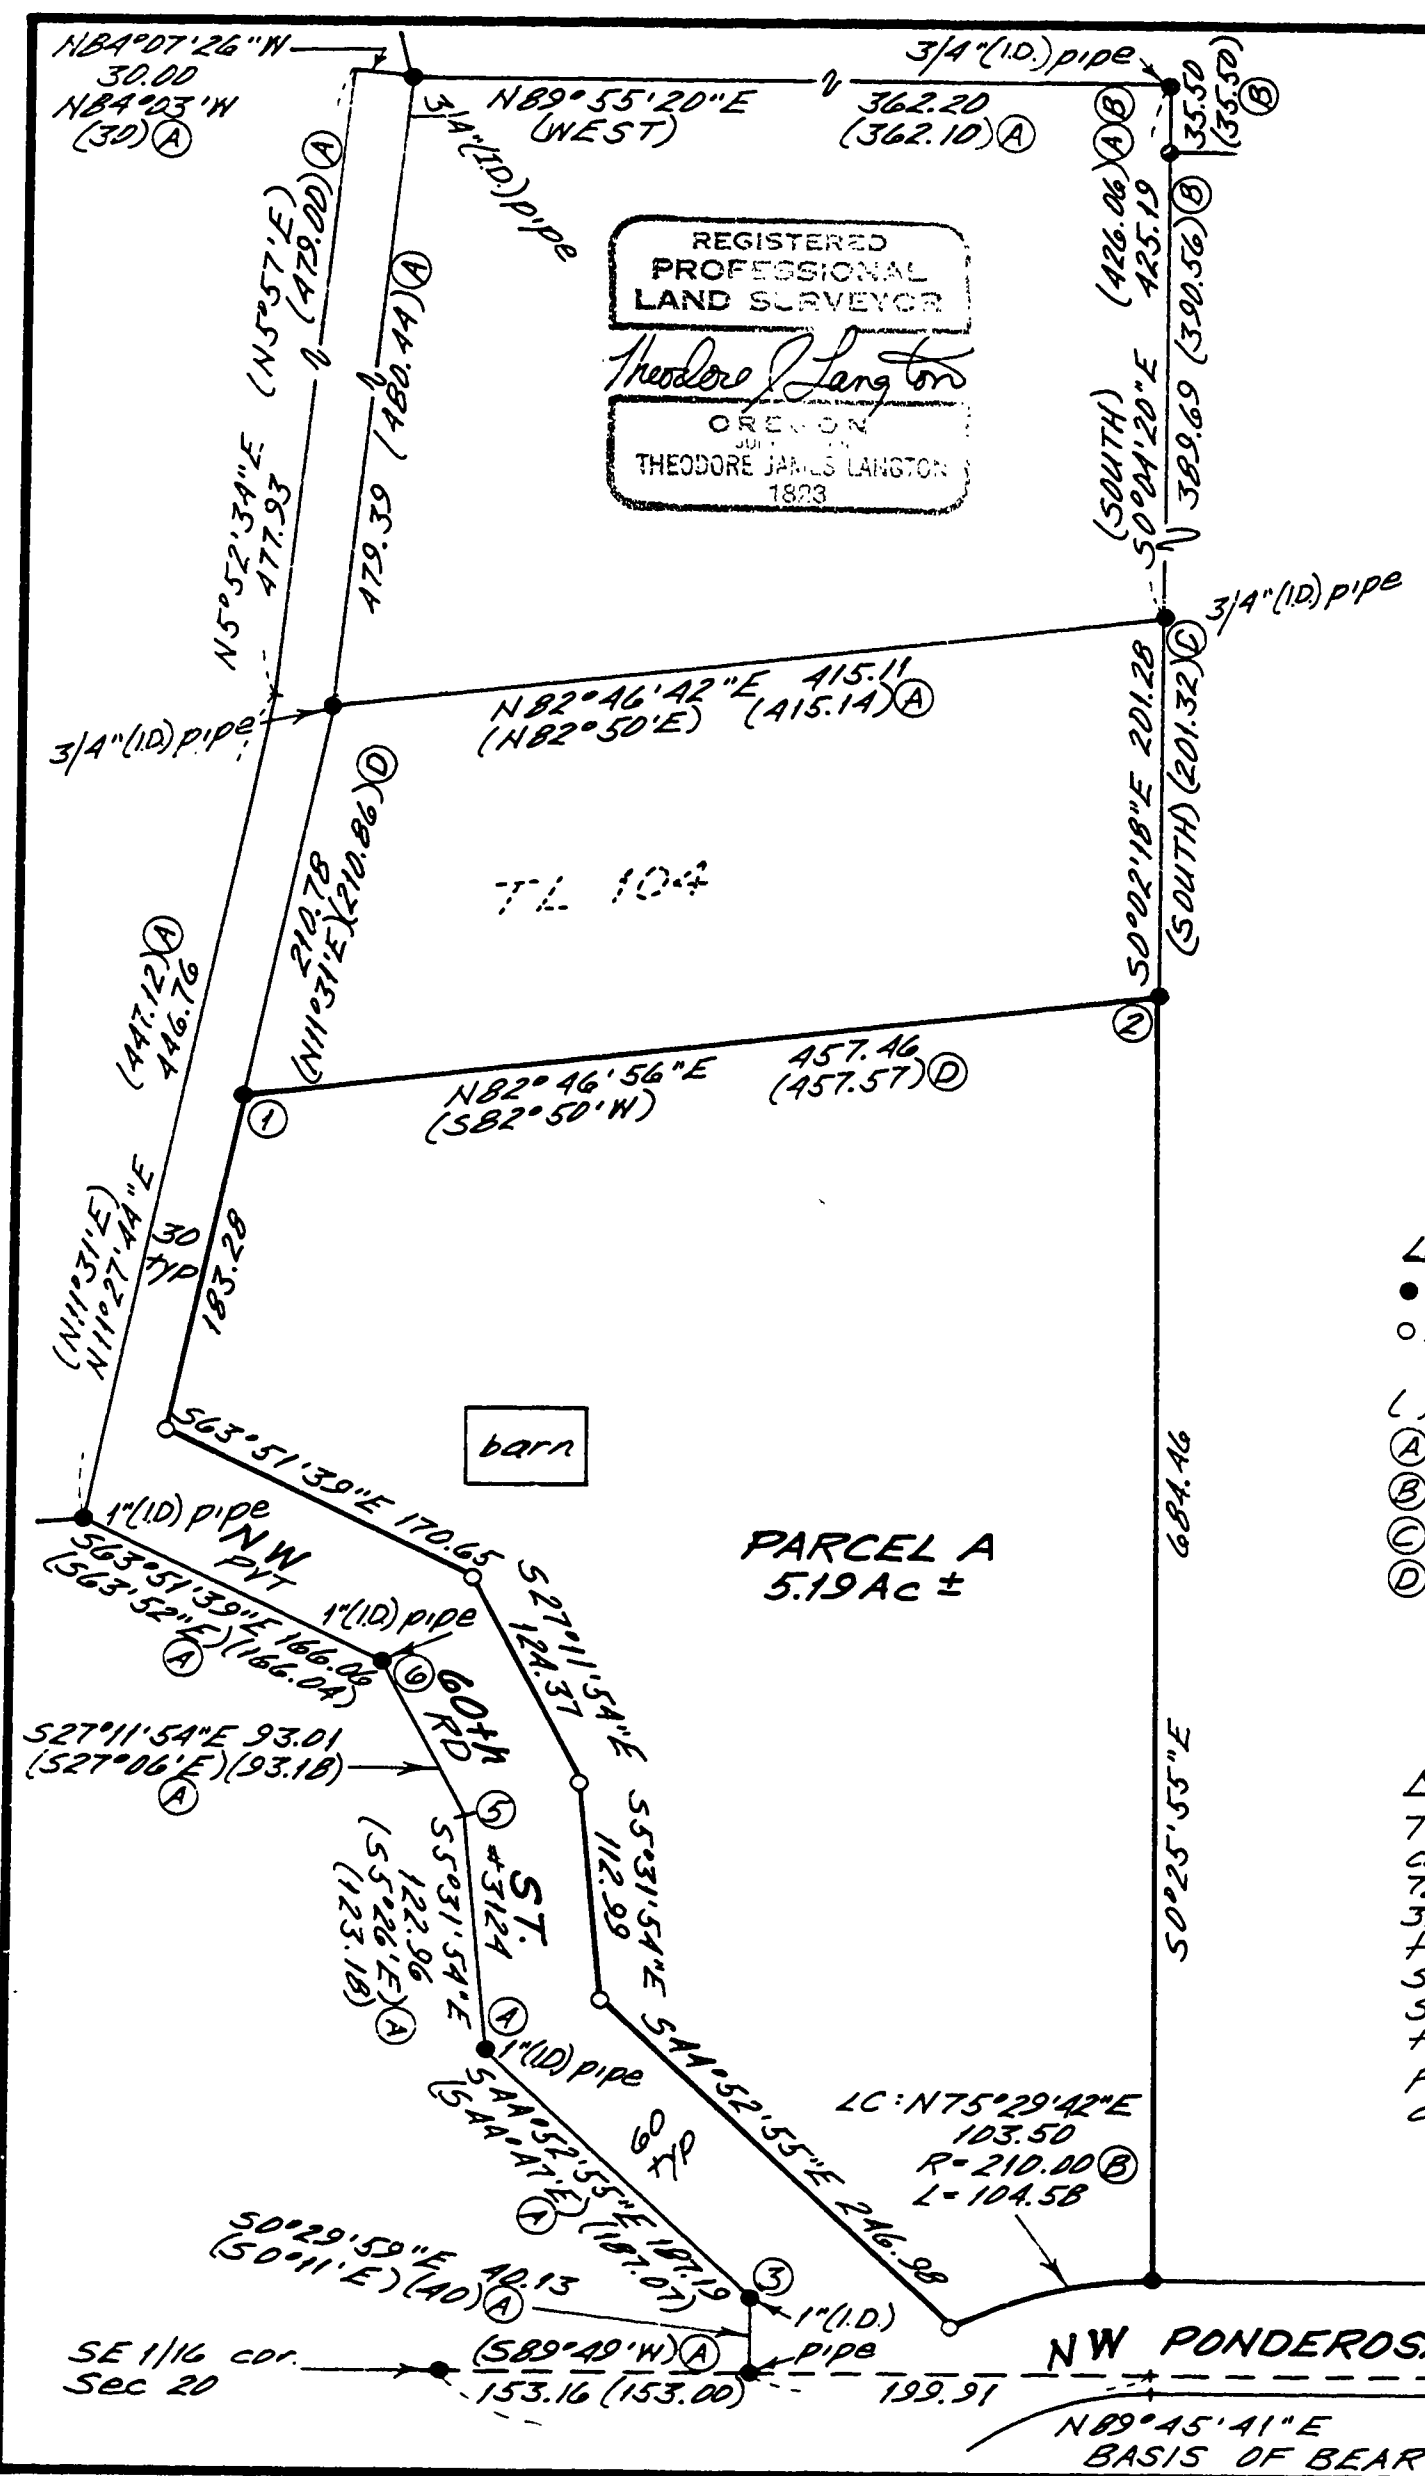

By: Northstar Surveying Inc.
402 NW 5th St.
Corvallis, Oregon, 97330
Ph: 757-9050