



7996 5-14-87

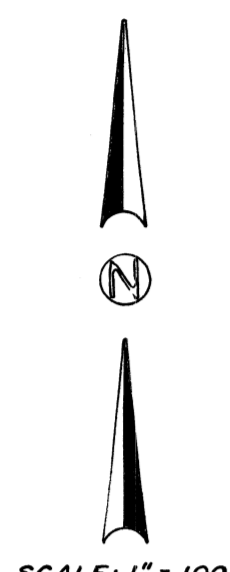

SCALE: 1" = 100'

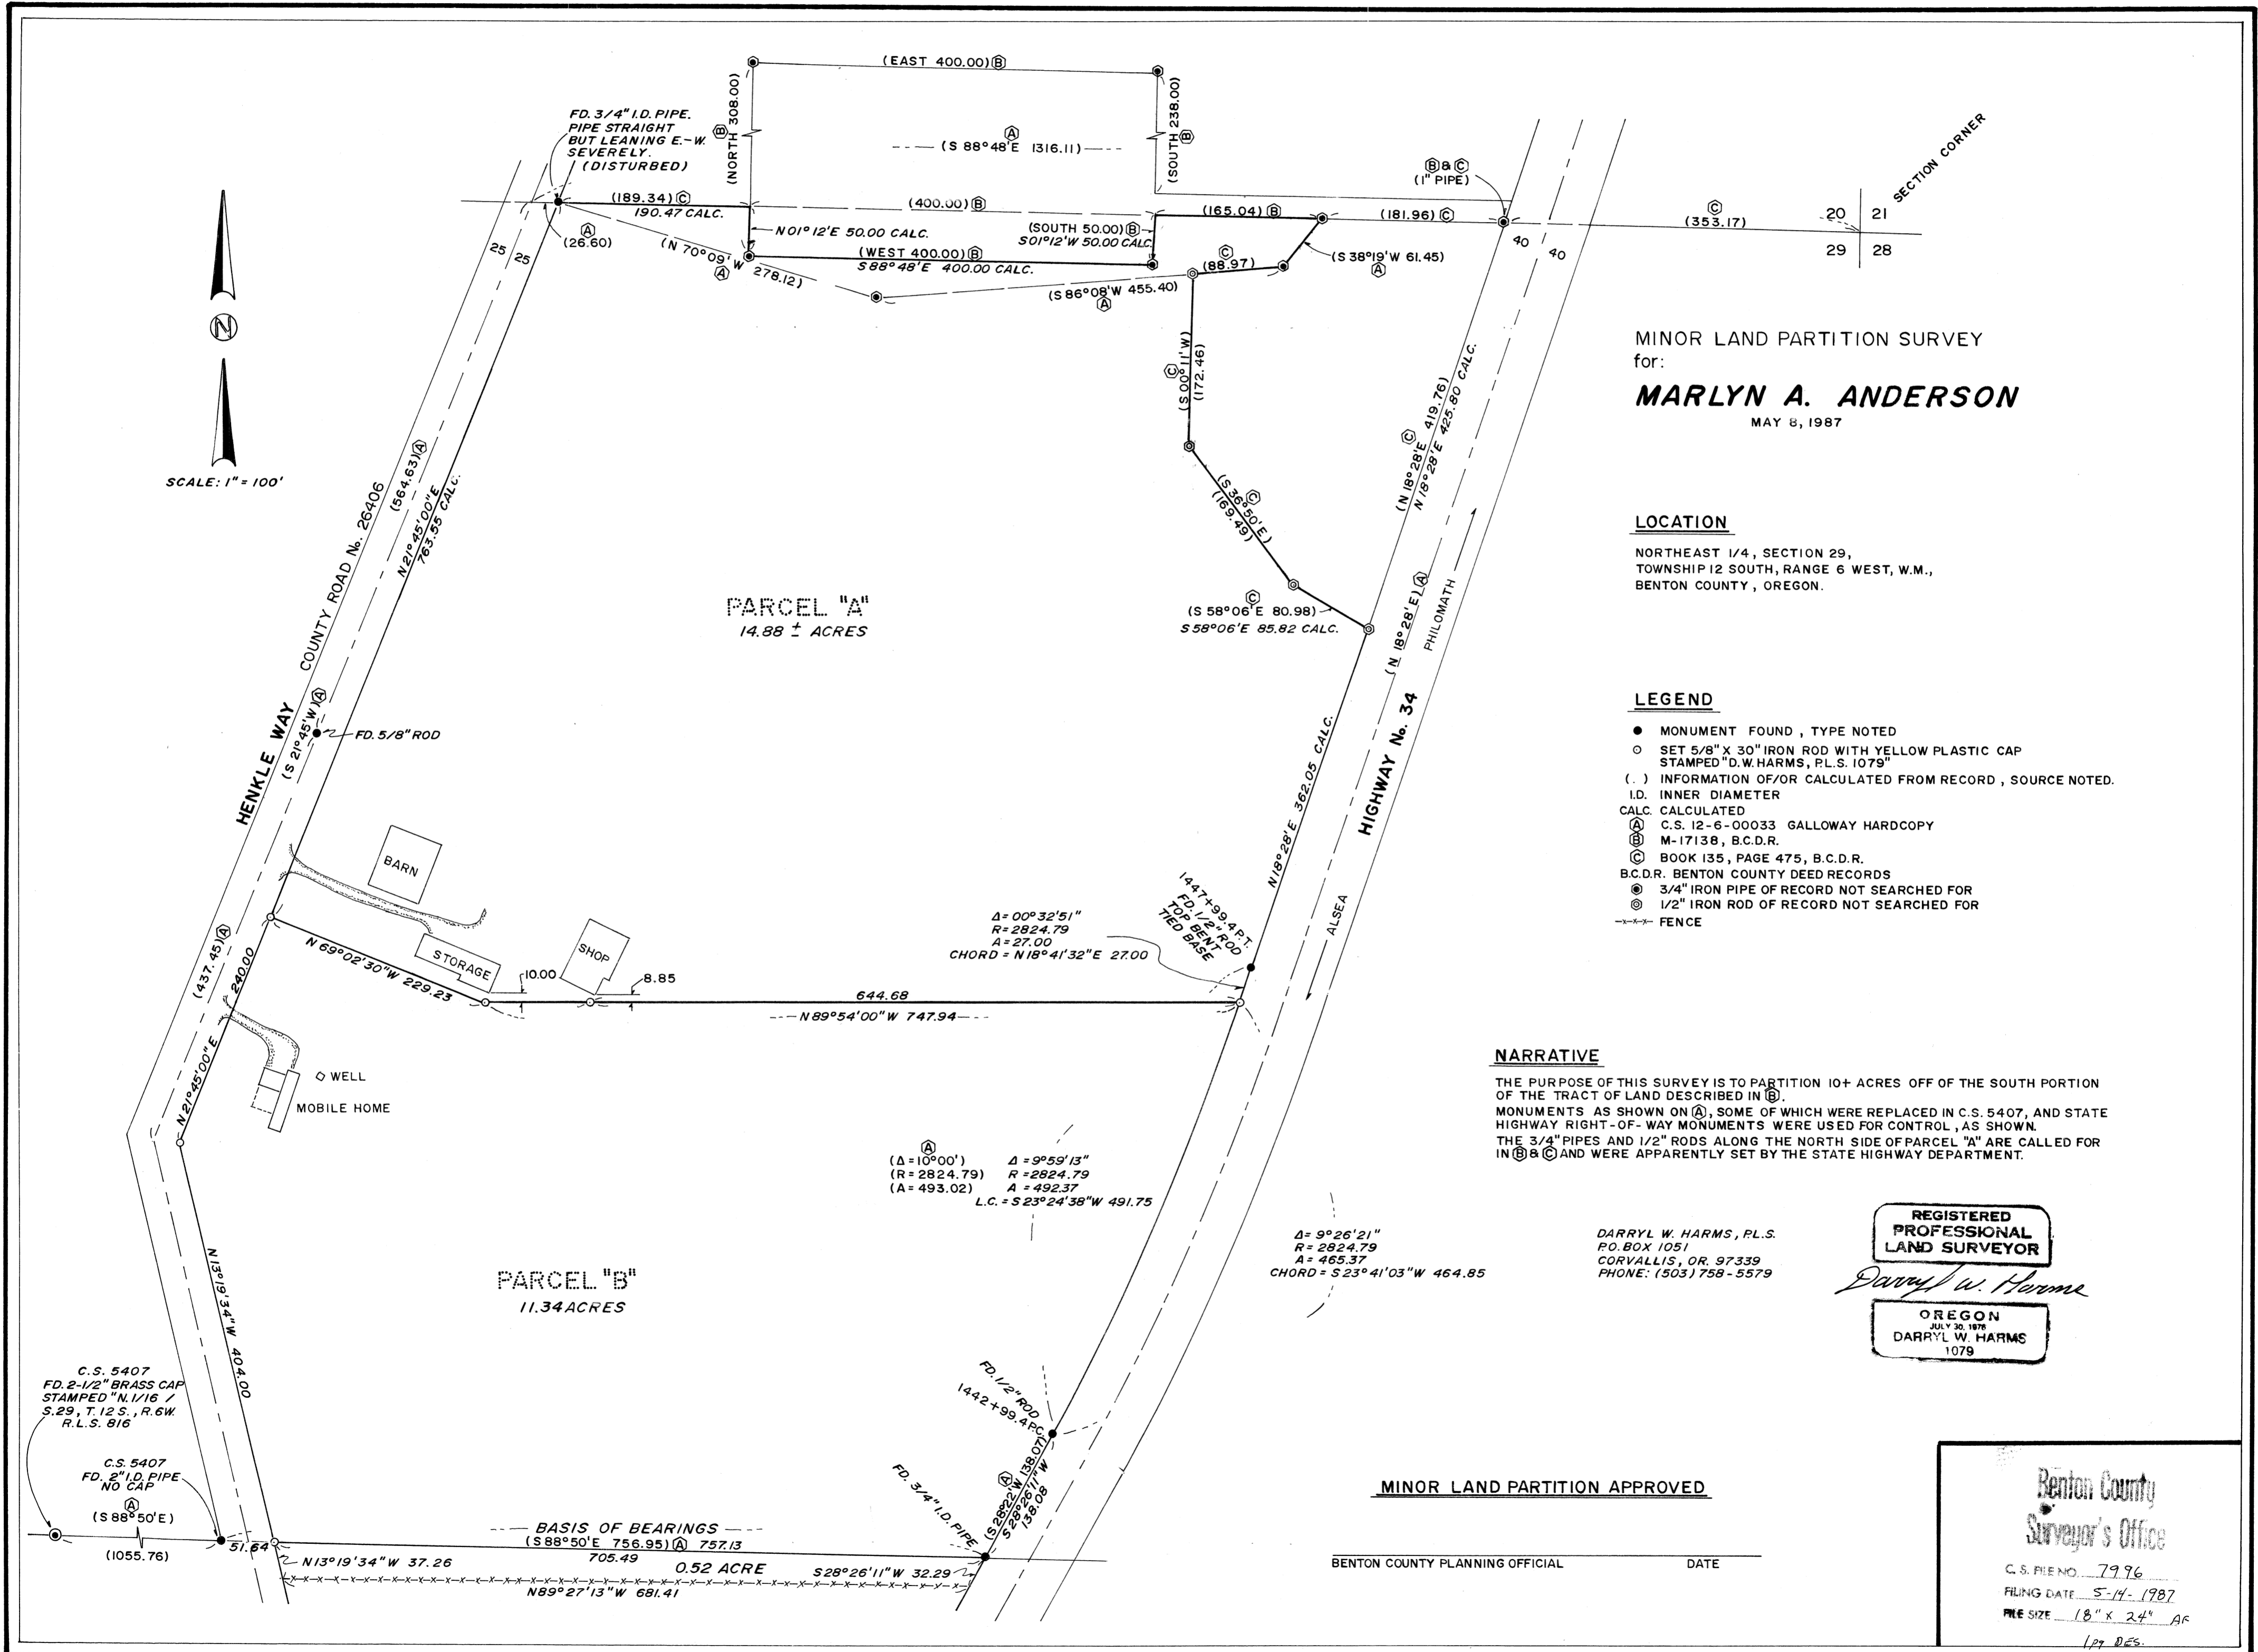

MINOR LAND PARTITION SURVEY
for:
MARLYN A. ANDERSON
MAY 8, 1987

LOCATION
NORTHEAST 1/4, SECTION 29,
TOWNSHIP 12 SOUTH, RANGE 6 WEST, W.M.,
BENTON COUNTY, OREGON.

- LEGEND**
- MONUMENT FOUND, TYPE NOTED
 - SET 5/8" X 30" IRON ROD WITH YELLOW PLASTIC CAP STAMPED "D.W.HARMS, P.L.S. 1079"
 - (.) INFORMATION OF/OR CALCULATED FROM RECORD, SOURCE NOTED.
 - I.D. INNER DIAMETER
 - CALC. CALCULATED
 - (A) C.S. 12-6-00033 GALLOWAY HARDCOPY
 - (B) M-17138, B.C.D.R.
 - (C) BOOK 135, PAGE 475, B.C.D.R.
 - B.C.D.R. BENTON COUNTY DEED RECORDS
 - ⊙ 3/4" IRON PIPE OF RECORD NOT SEARCHED FOR
 - ⊙ 1/2" IRON ROD OF RECORD NOT SEARCHED FOR
 - x-x- FENCE

NARRATIVE
THE PURPOSE OF THIS SURVEY IS TO PARTITION 10+ ACRES OFF OF THE SOUTH PORTION OF THE TRACT OF LAND DESCRIBED IN (B). MONUMENTS AS SHOWN ON (A), SOME OF WHICH WERE REPLACED IN C.S. 5407, AND STATE HIGHWAY RIGHT-OF-WAY MONUMENTS WERE USED FOR CONTROL, AS SHOWN. THE 3/4" PIPES AND 1/2" RODS ALONG THE NORTH SIDE OF PARCEL "A" ARE CALLED FOR IN (B) & (C) AND WERE APPARENTLY SET BY THE STATE HIGHWAY DEPARTMENT.

DARRYL W. HARMS, P.L.S.
P.O. BOX 1051
CORVALLIS, OR. 97339
PHONE: (503) 758-5579

REGISTERED
PROFESSIONAL
LAND SURVEYOR
Darryl W. Harms
OREGON
JULY 30, 1976
DARRYL W. HARMS
1079

MINOR LAND PARTITION APPROVED
BENTON COUNTY PLANNING OFFICIAL _____ DATE _____

Benton County
Surveyor's Office
C.S. FILE NO. 7996
FILING DATE 5-14-1987
FILE SIZE 18" X 24" AF
127 DES.