


DRAWING NUMBER
8160

DRAWING NUMBER
8160

8160 8/22

8160

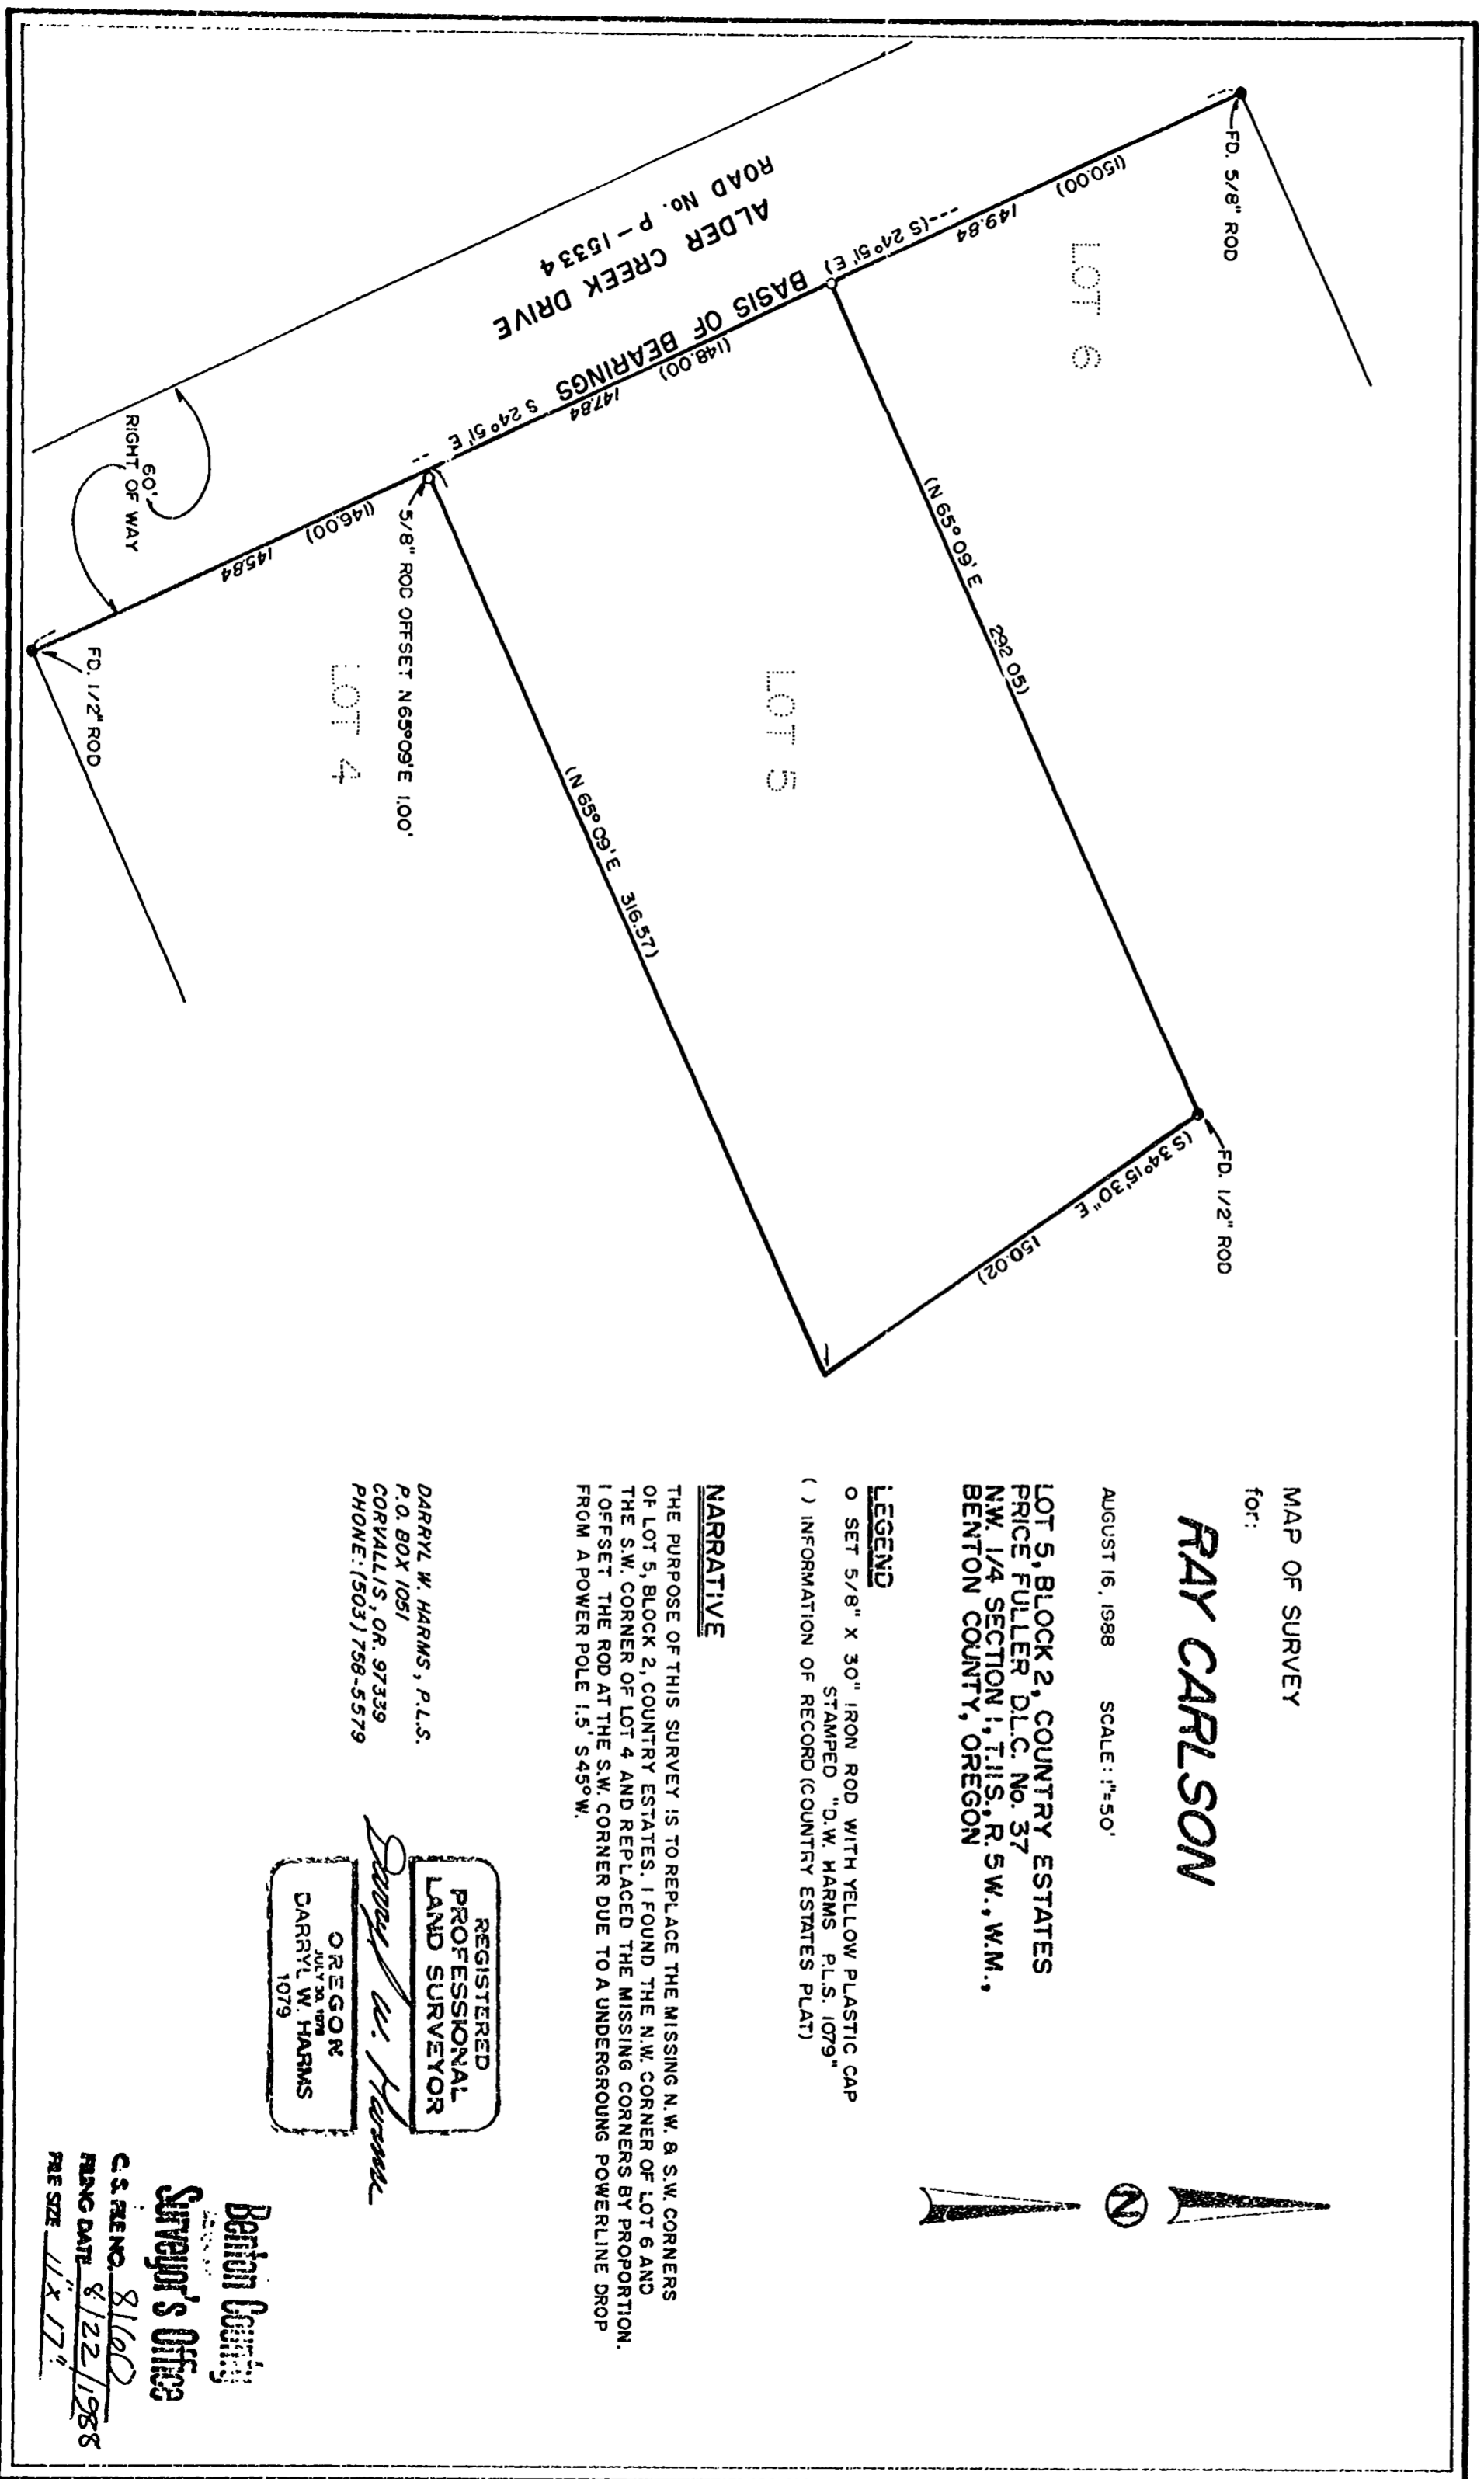

8160

NOT TO SCALE
DRAWING IS LESS CLEAR THAN
THE ORIGINAL
THIS DRAWING IS THE ORIGINAL
DRAWING

1	2	3	4	5	6	7	8	9	10	11	12																		
30	29	28	27	26	25	24	23	22	21	20	19	18	17	16	15	14	13	12	11	10	9	8	7	6	5	4	3	2	1

10