

DRAWING NUMBER

8200

PLAN HOLD CORPORATION - IRVINE, CALIFORNIA

RECORD BY NUMBER 0794

DATE OF SURVEY 1988

DRAWING NUMBER

8200

PLAN HOLD CORPORATION - IRVINE, CALIFORNIA

RECORD BY NUMBER 0794

DATE OF SURVEY 1988


Benton County  
Surveyor's Office

C.S. FILE NO. 8200  
FILING DATE 12/8/1988  
PLOT SIZE 11" X 17"

B-25

Part of **A.M. RAINWATER'S**  
Not, "No 697,, Cts, 61<sup>nd</sup> & 39 T II S.R 3 & 4 W. Will, Mer.,  
Benton Co, Ore.

NOTE: THIS IS AN OLD  
UNRECORDED SURVEY

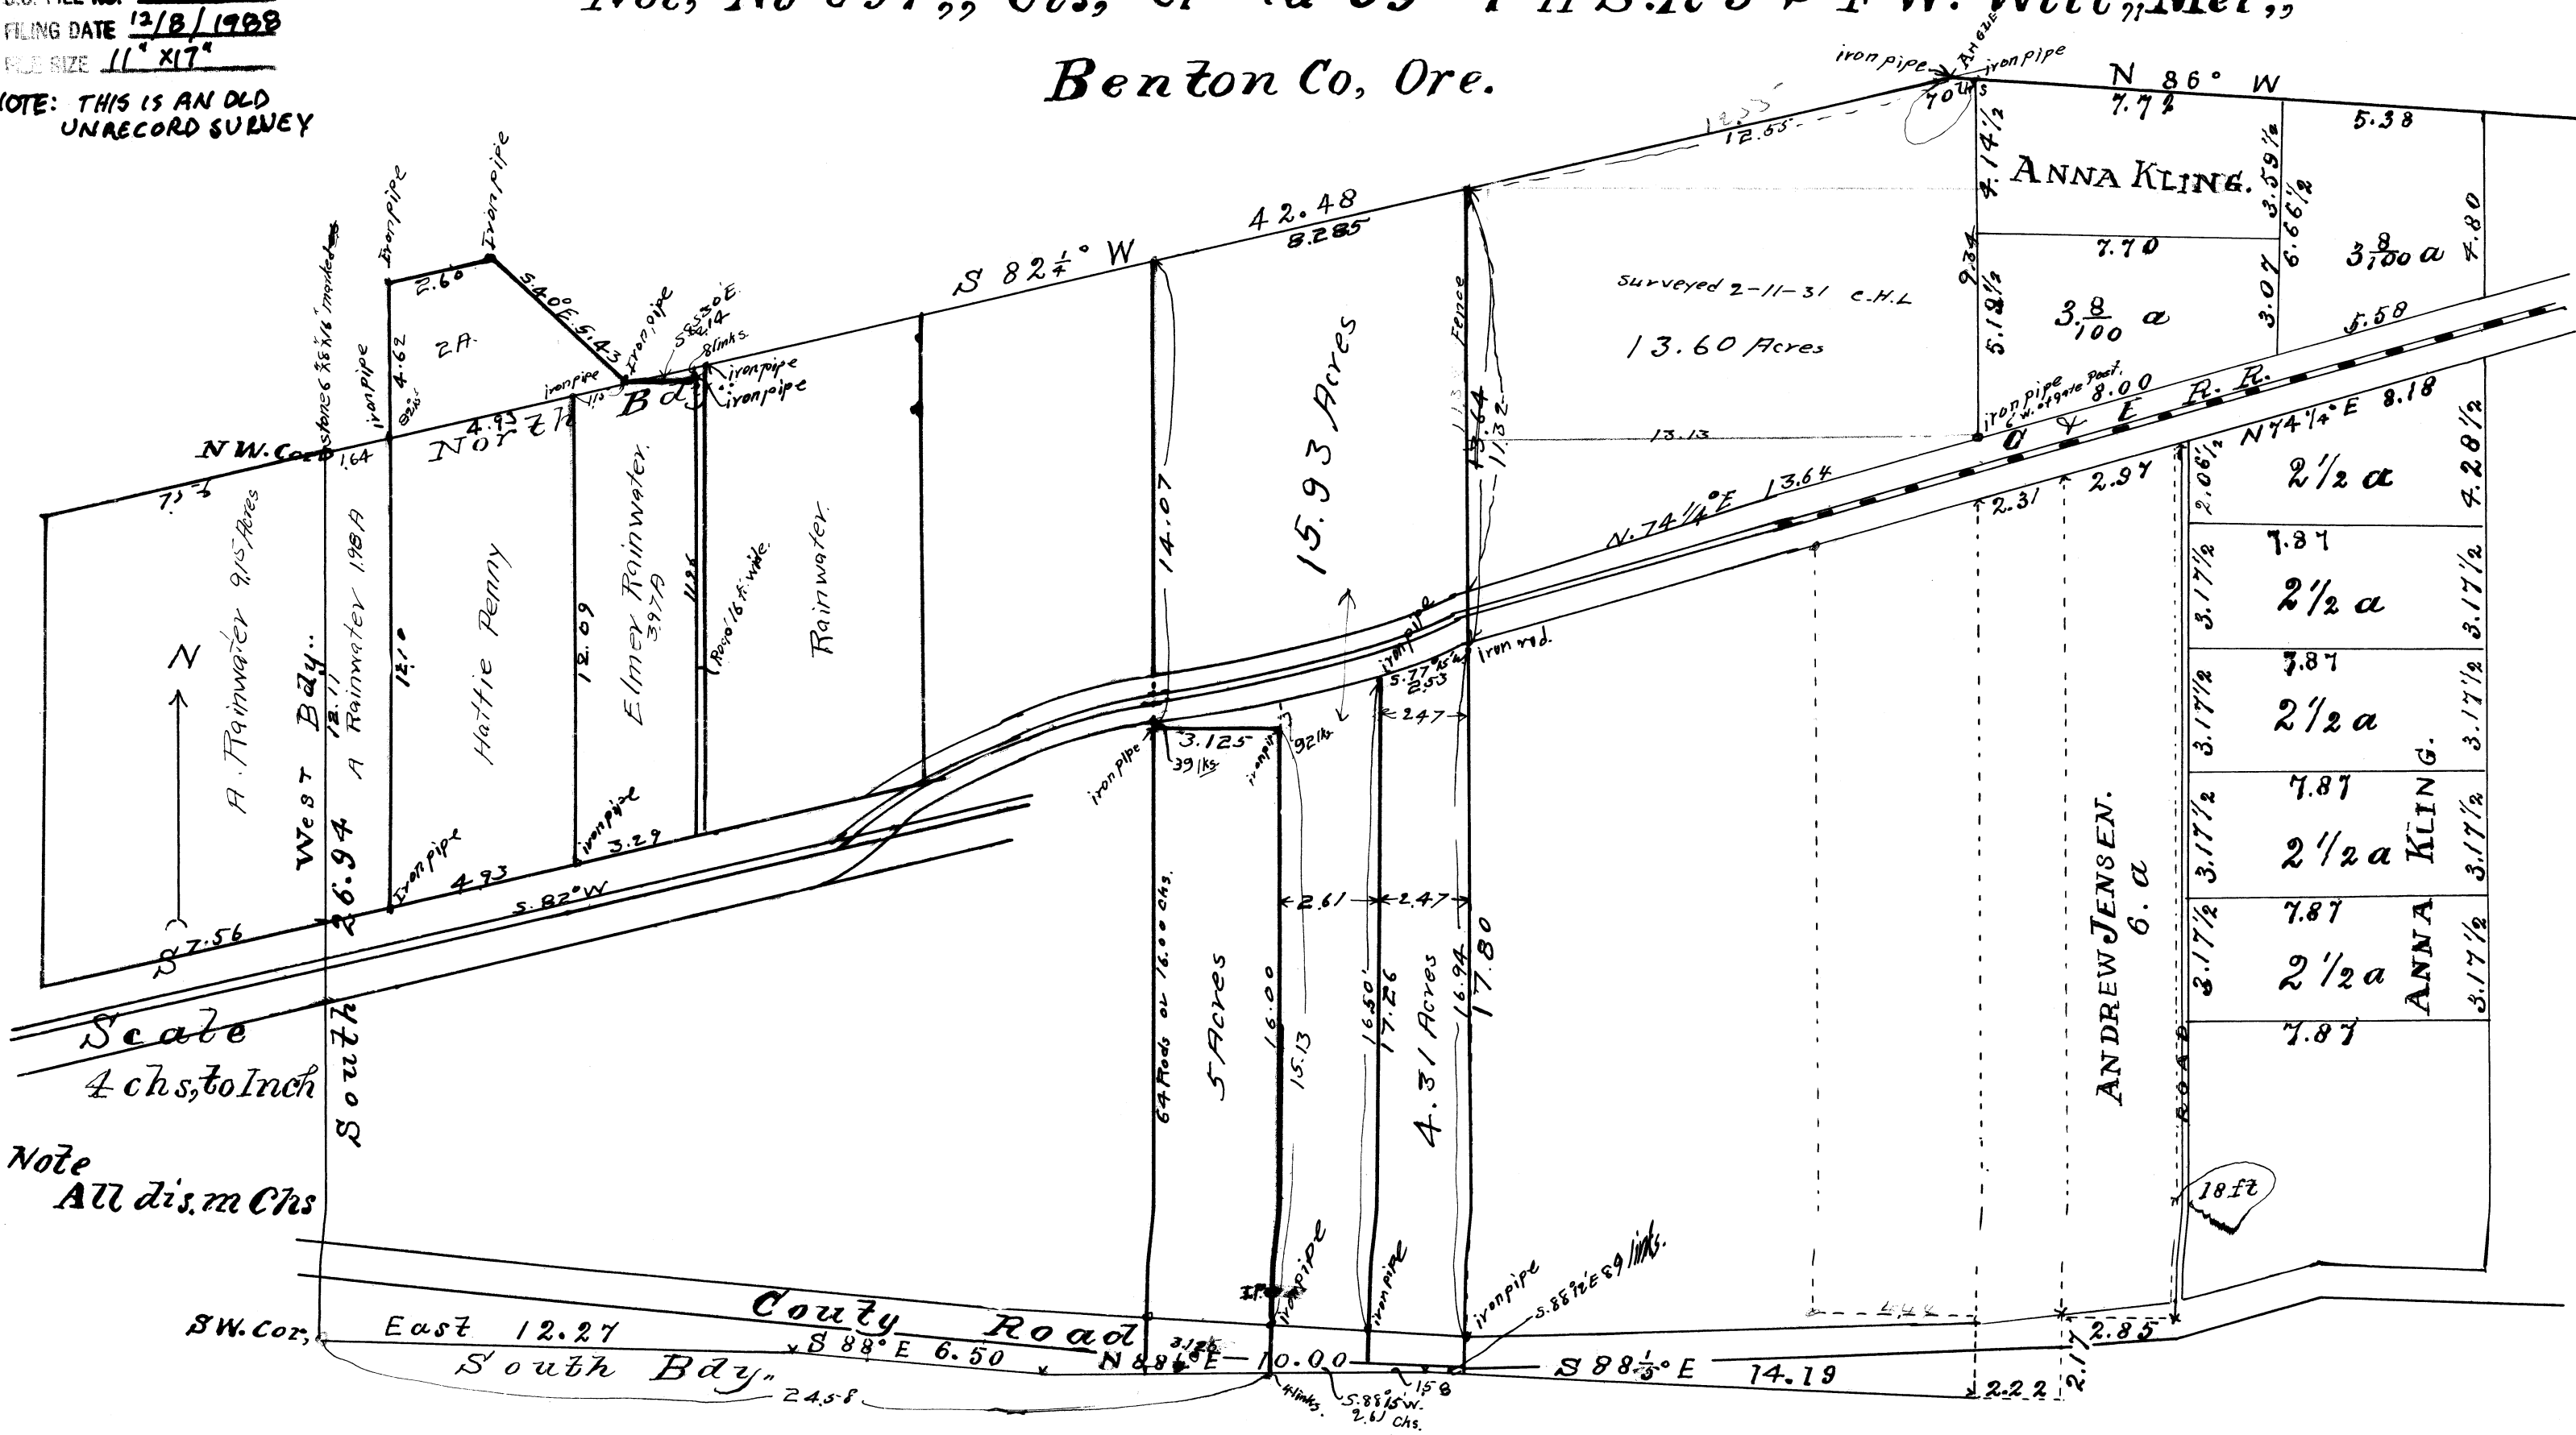

Scale  
4 chs to 1 inch

Note  
All dis. in Chs

SW. Cor., East 12.27, County Road, South Bay, S 88 1/2° E 6.50, N 88 1/2° E 10.00, S 88 1/2° E 14.19, 2.458, 158, 5.88 1/2° W, 2.61 chs., 2.22, 2.17, 2.85