

DRAWING NUMBER
8377

PLAN HOLD CORPORATION • IRVINE, CALIFORNIA
REORDER BY NUMBER 0754P

DRAWING NUMBER
8377

PLAN HOLD CORPORATION • IRVINE, CALIFORNIA
REORDER BY NUMBER 0754P

8377 1-10-90

N.M. COR. SEC. 1
FD 1/2" ID G.I.P. & 4 X 4 POST
50" DF HEALED FACE N70°00'E 30.1'

SEC. 2 SEC. 1

(60 18.96CH)

BASIS OF BEARINGS
(G.L.O. NORTH 38.96 CH)
(38.976 CH C.S. #159)

SET 5/8" I.R.

(60 20.00CH)

FD 5/8" I.R. UNDER SURFACE-BENT
BRG & DIST
FD 2 60" DE STUMPS AT C.S. #159 RECORD
(1325.67' CS #159)
1327.08'
N 68°15'04" E



Benton County
Surveyor's Office

FILE NO. **CS 8377**
PLG DATE **1-26-90**


SURVEYOR'S NARRATIVE:


THE PURPOSE OF THIS SURVEY IS TO ESTABLISH THE NORTH ONE-SIXTEENTH CORNER BETWEEN SECTIONS ONE AND TWO, T. 11 S., R. 7 W., M.M., BENTON COUNTY, OREGON. THIS SURVEY TIED TO MONUMENTS FOUND, AS REPRESENTED ON C.S. #159, AT THE NORTHWEST CORNER OF SECTION ONE AND THE 1/4 CORNER BETWEEN SECTIONS ONE AND TWO. THE MONUMENT ESTABLISHED WAS SET AT A DISTANCE PROPORTIONED WITH RESPECT TO THE RECORD G.L.O. DISTANCES.

LEGEND:

- ⊕ MONUMENTS FOUND - HELD FOR CONTROL.
- MONUMENTS FOUND.
- MONUMENTS SET: 5/8" x 30" IRON RODS W/ PLASTIC CAPS INSCRIBED "DENISON SURVEYING, NEWPORT, OR."

RECORD DATA SHOWN IN PARENTHESES.
EQUIPMENT USED: WILD T-2000 TOTAL STATION.

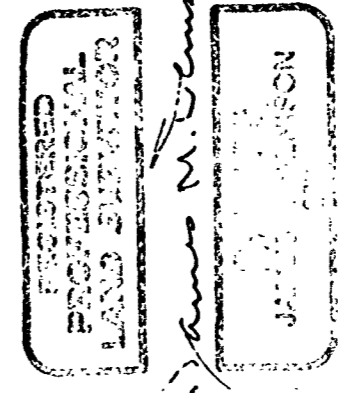

NAME: HAL SCHUDEL	
LOCATION: NW 1/4 SEC. 1, T. 11 S., R. 7 W., M.M.	
SCALE: 1" = 300'	 Denison Surveying, Inc. PROFESSIONAL LAND SURVEYOR 720 S.W. ANGLE NEWPORT, OREGON 97365 (503) 265-0308
DATE: NOV. 20, 1989	
JOB NO: DSI #1101	
DRAWN BY: CD	