


4-2-1992

NOTE: ALTHOUGH THIS MAP DOES NOT COMPLY WITH BENTON COUNTY MAP STANDARDS IT HAS BEEN ASSIGNED A COUNTY SURVEY NUMBER IN ORDER TO MAKE REFERENCE TO THE

MONUMENTS SHOWN. THE MAP FOR SWANSON-SUPERIOR FOREST PRODUCTS, INC. and STARKER FORESTS, INC. WAS CREATED BY JIM PETERSON TO SHOW CORNER RESTORATIONS DONE BY HIM, AND FOUND MONUMENTS LOCATED BY HIM.

Benton County Surveyor's Office

C.S. FILE NO. 8602
FILING DATE 4-9-92
FILE SIZE 14 X 17

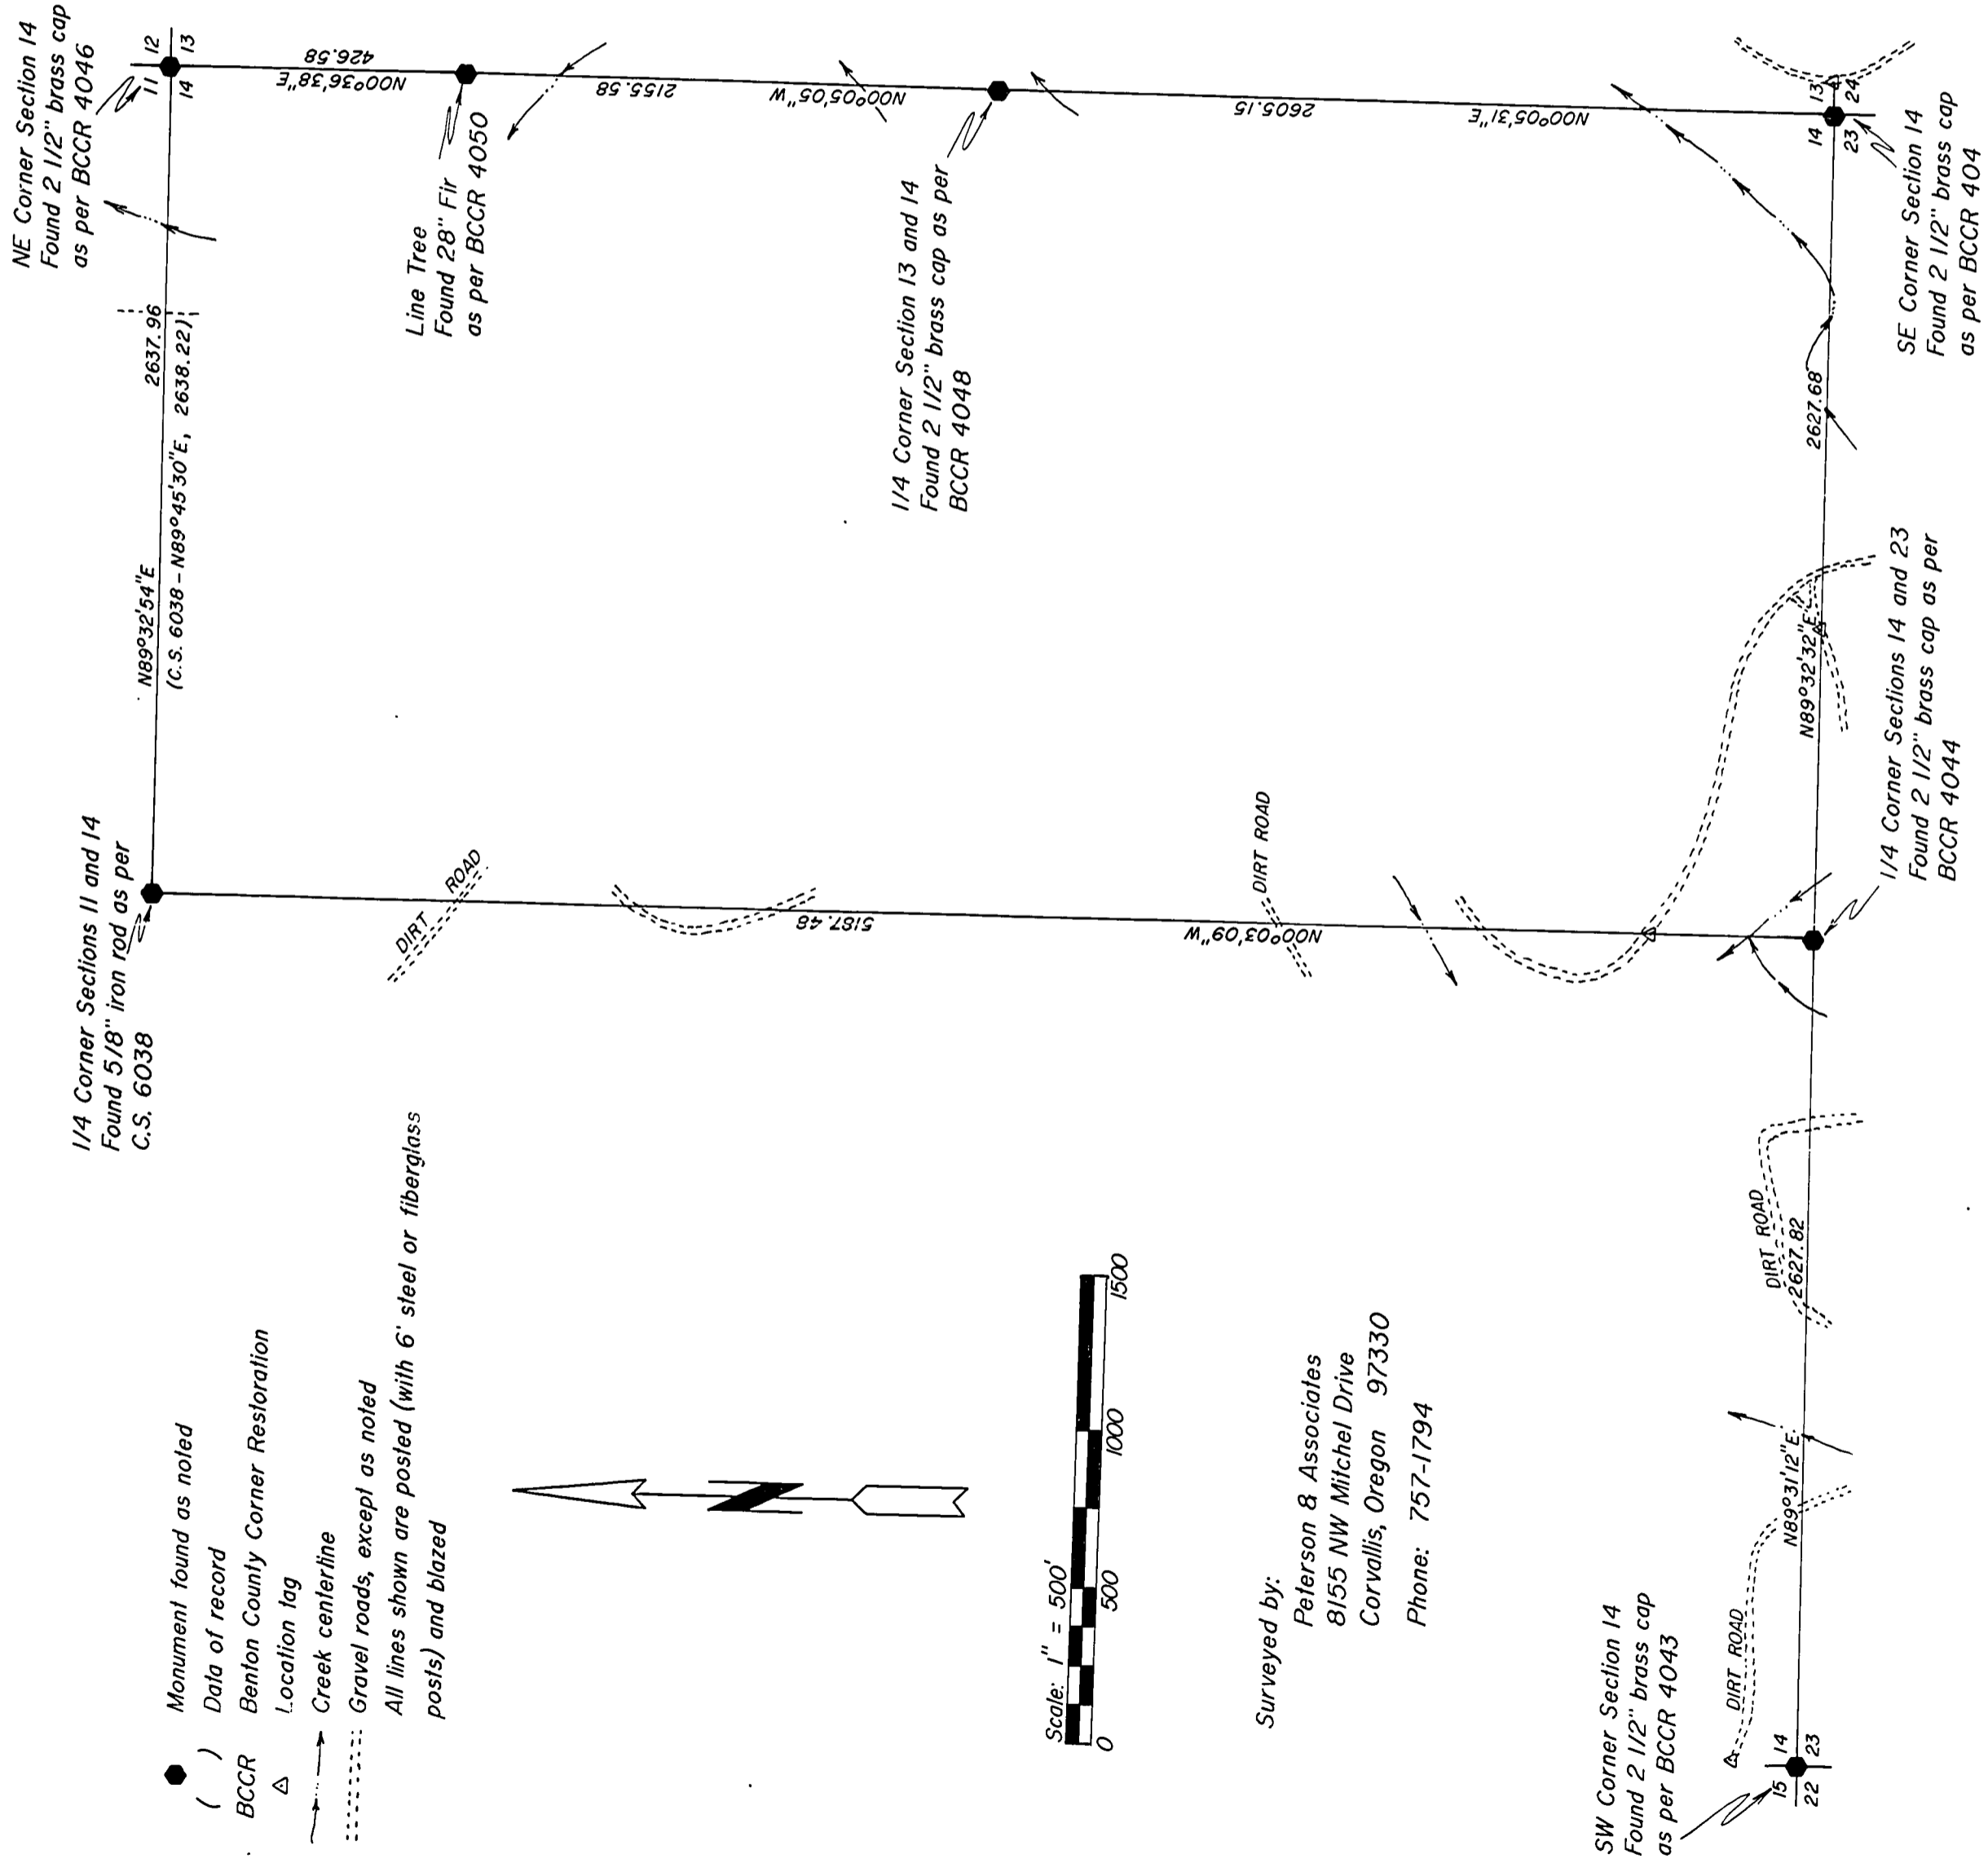

8602

8602

1-1-92
3032