


BLOCK 3 870  
WILKINS ADDITION  
 CITY OF CORVALLIS

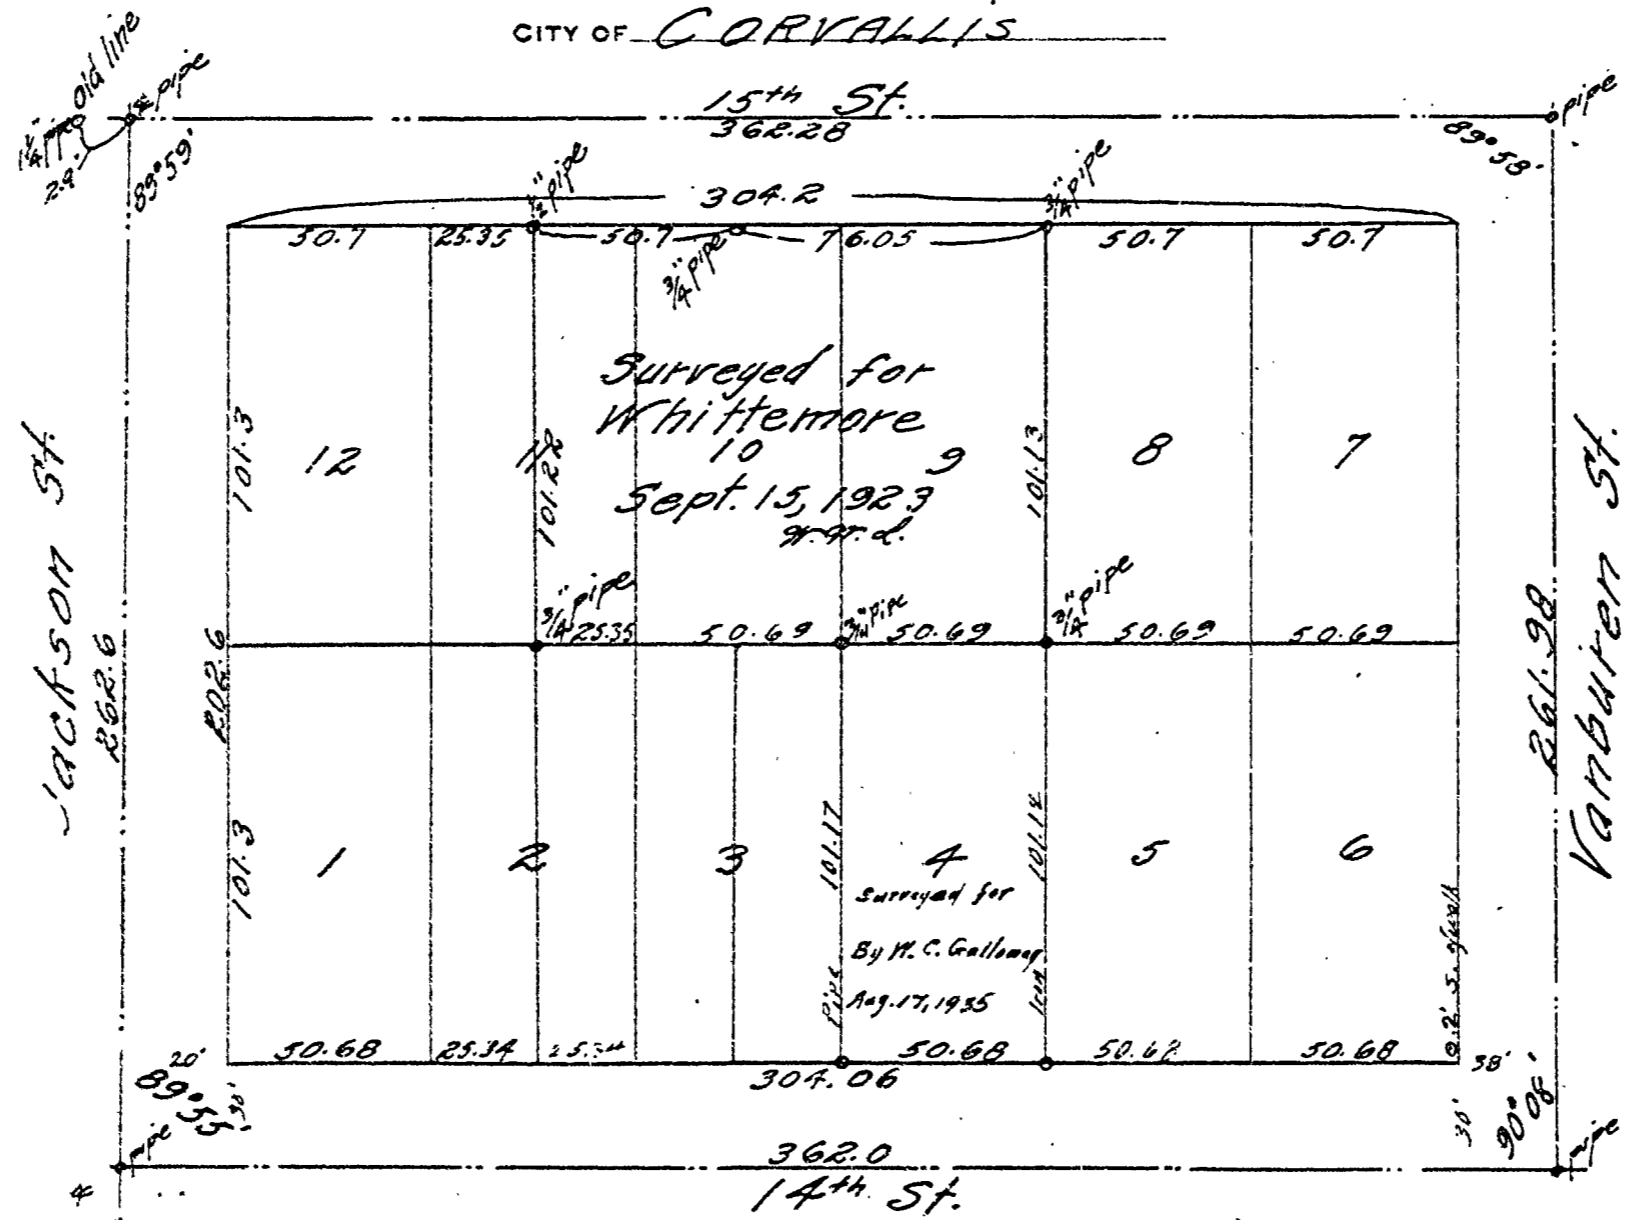

75