


DRAWING NUMBER  
**8782**

PLAN HOLD CORPORATION • IRVINE, CALIFORNIA  
REPROD BY NUMBER 075AR

DRAWING NUMBER  
**8782**

PLAN HOLD CORPORATION • IRVINE, CALIFORNIA  
REPROD BY NUMBER 075AR

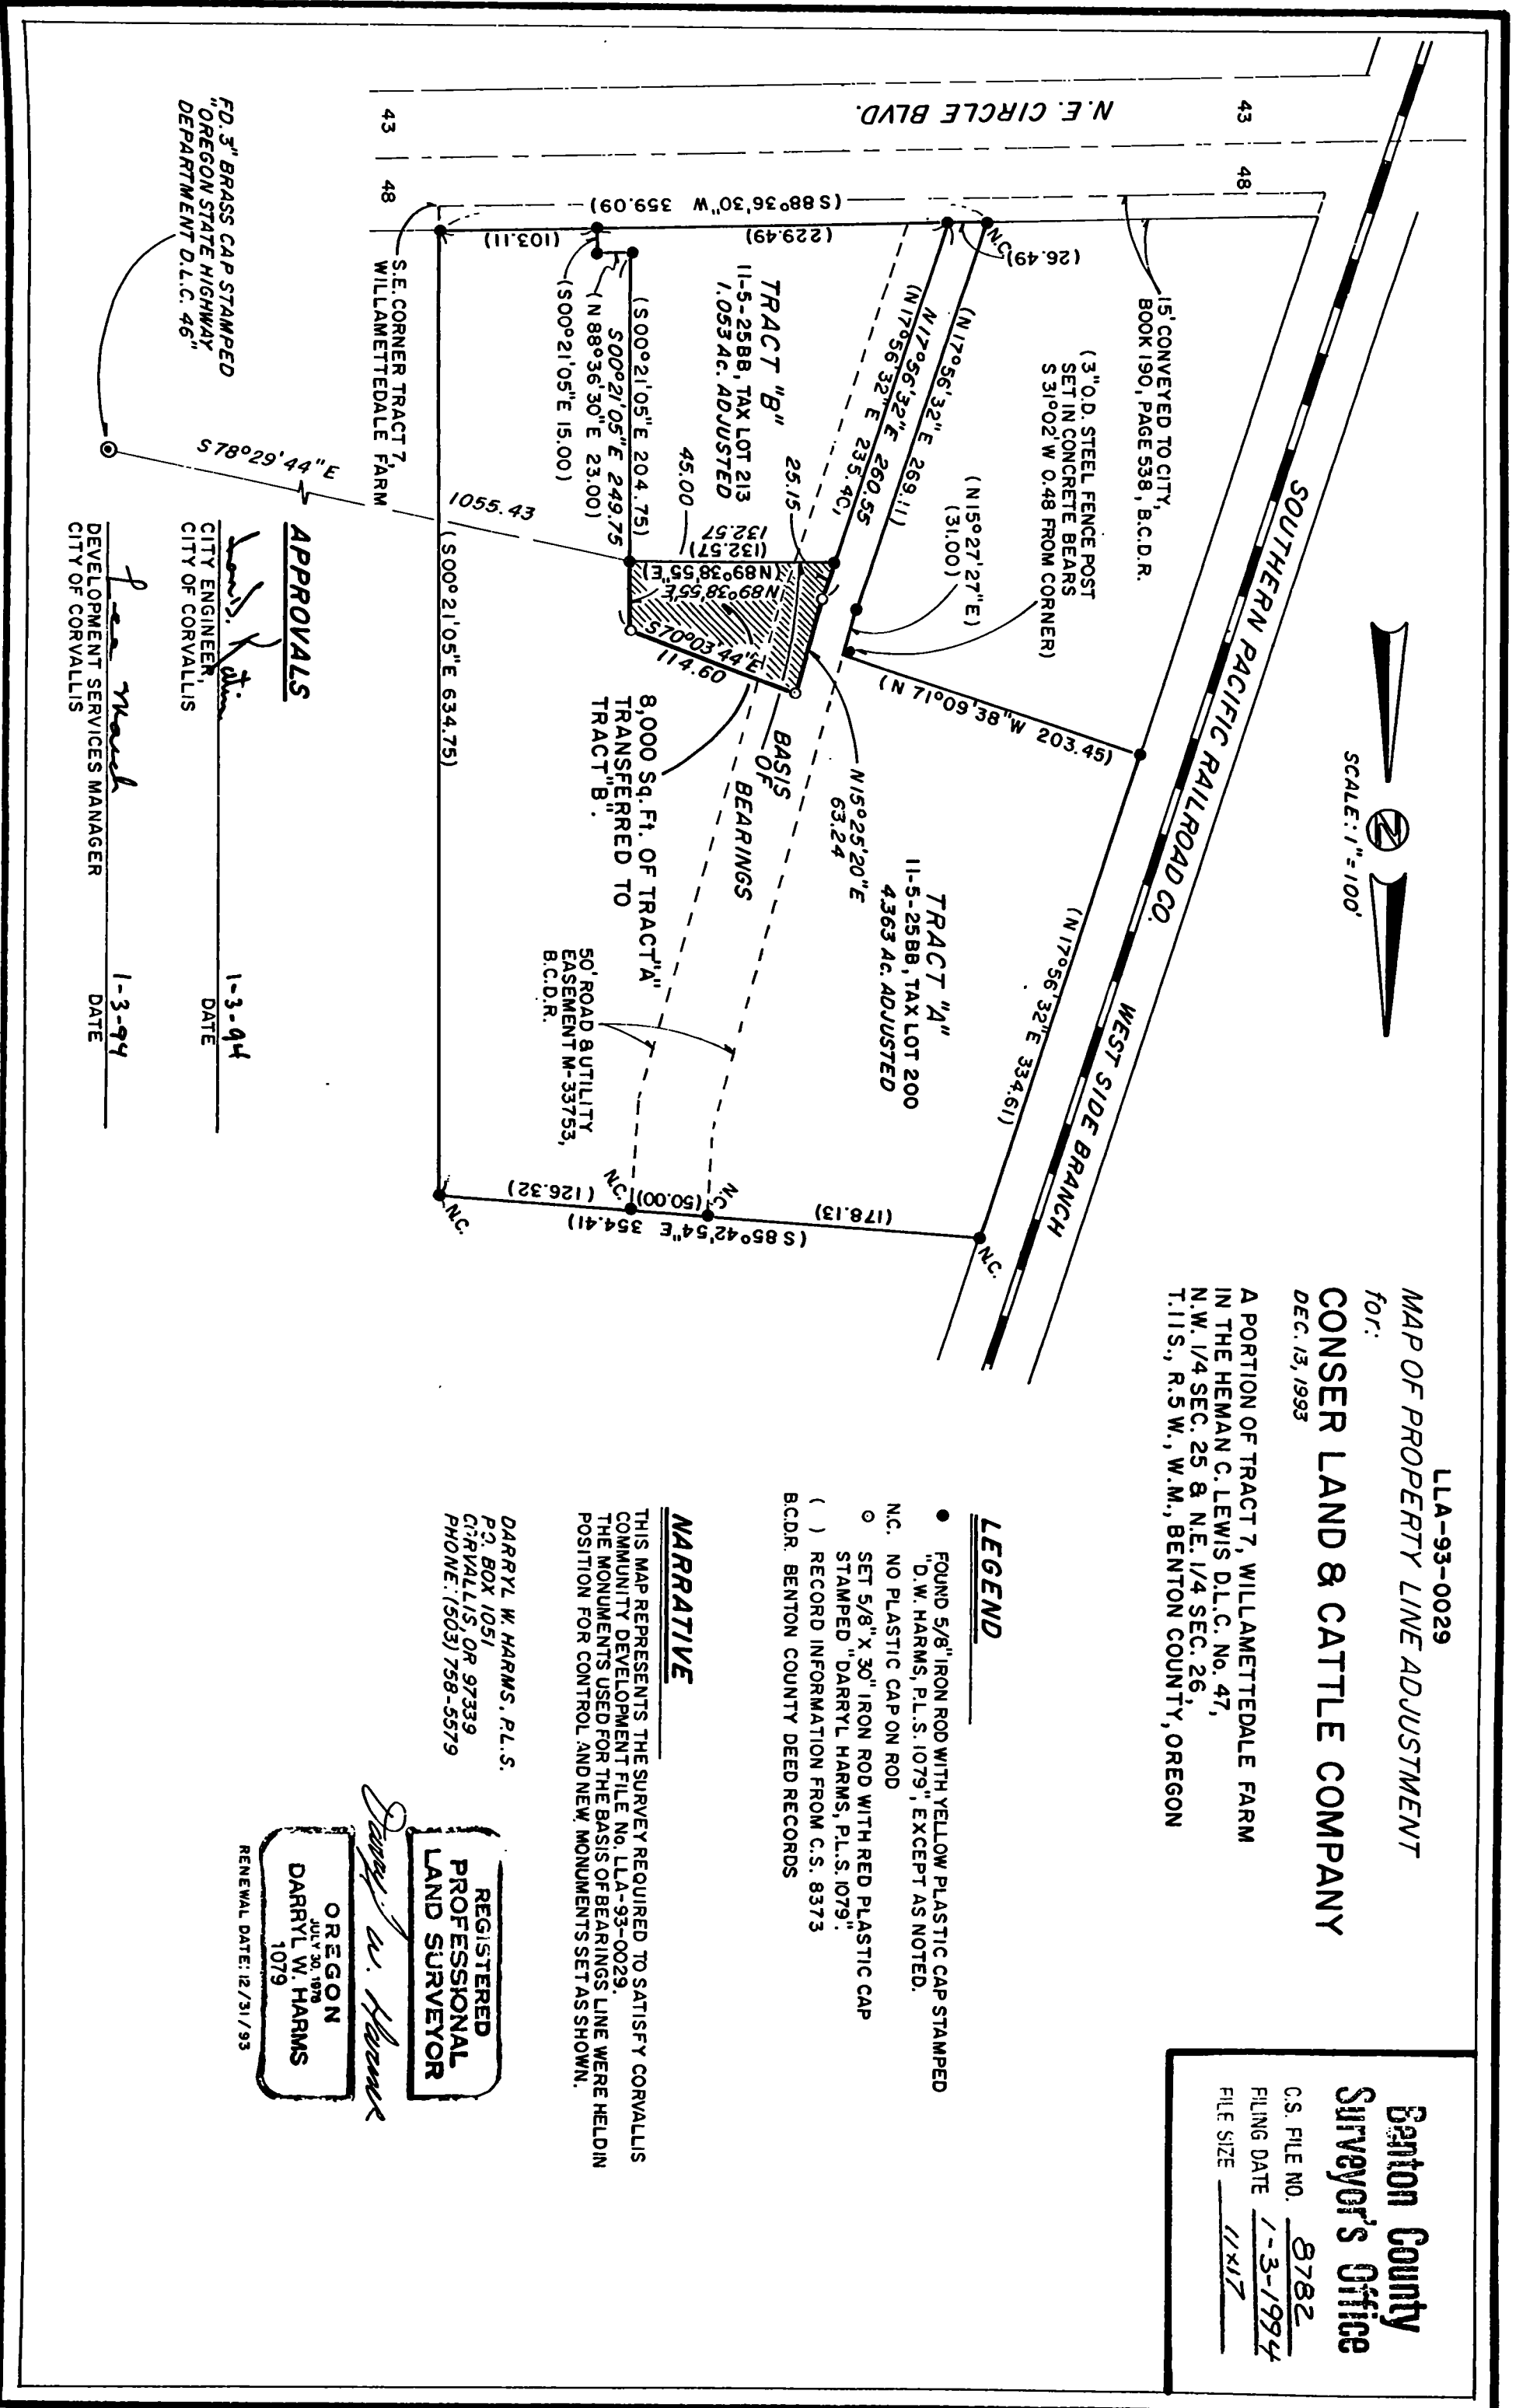

**Benton County  
Surveyor's Office**

C.S. FILE NO. 8782  
FILING DATE 1-3-1994  
FILE SIZE 11x17